
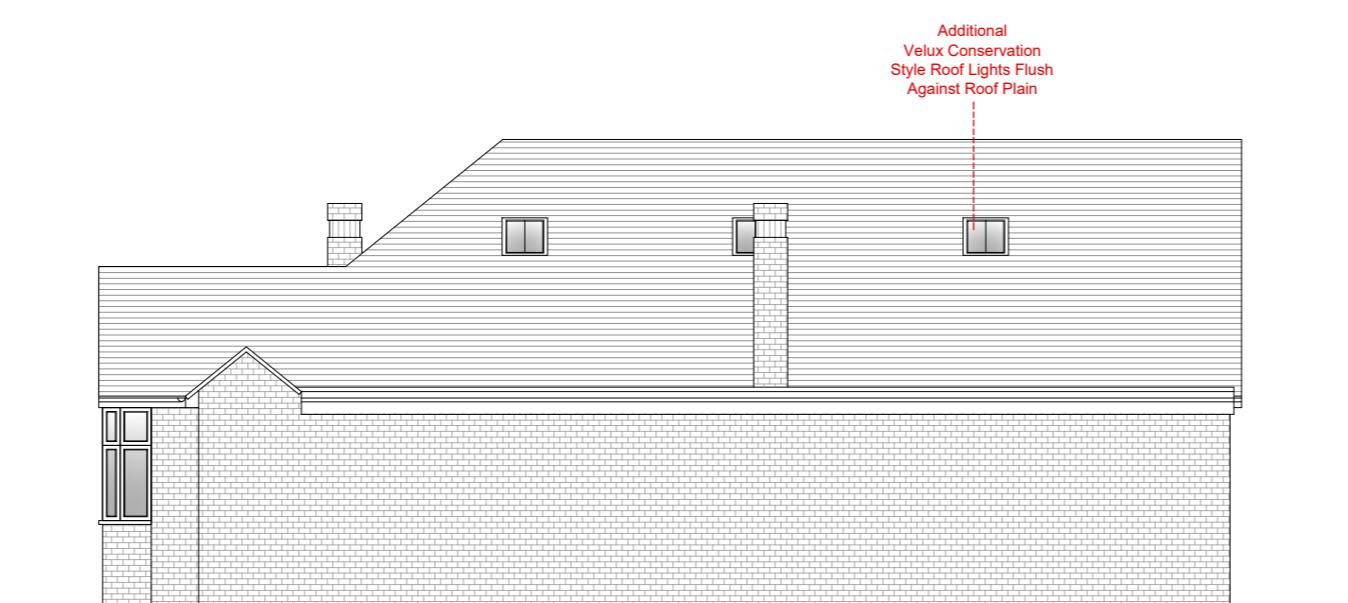
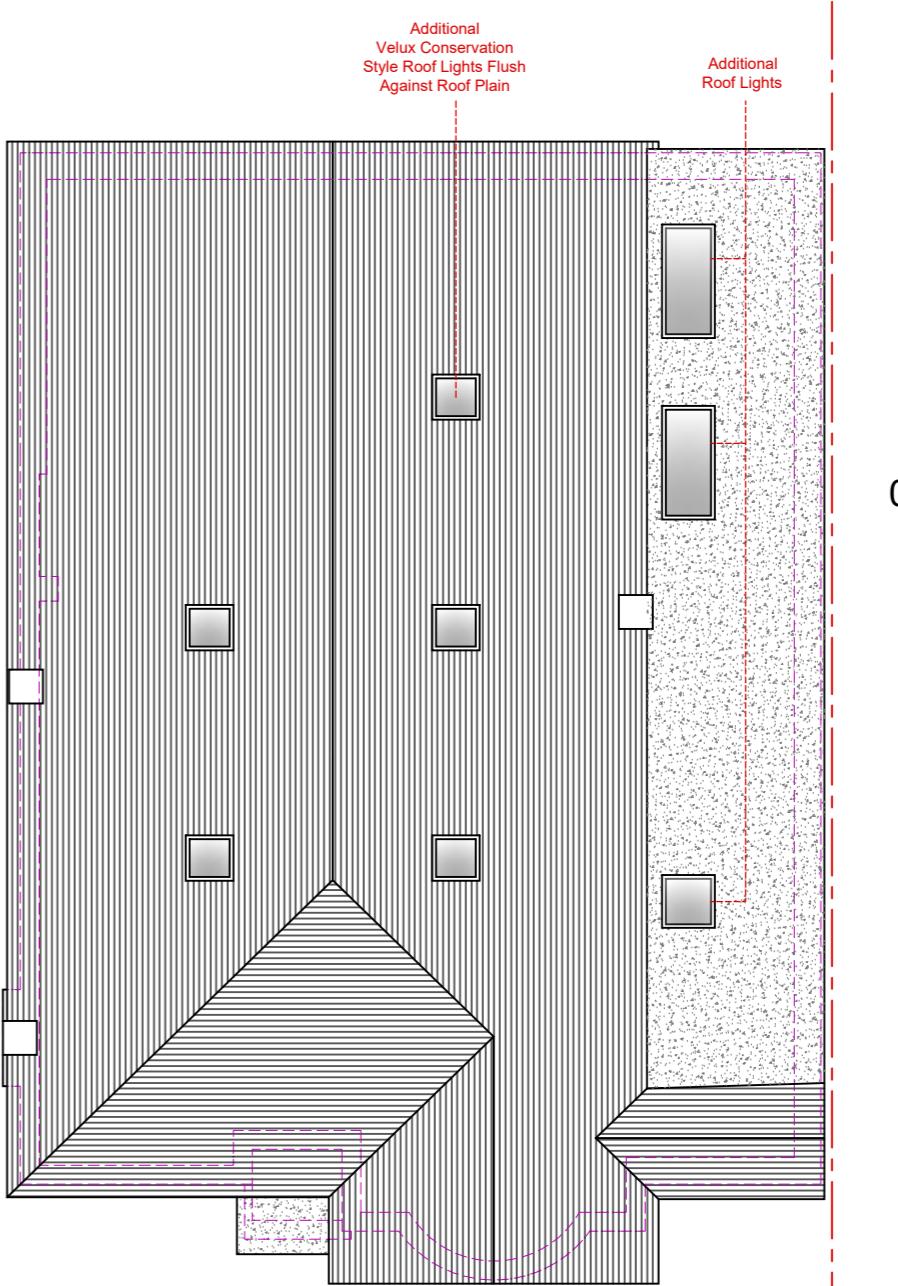
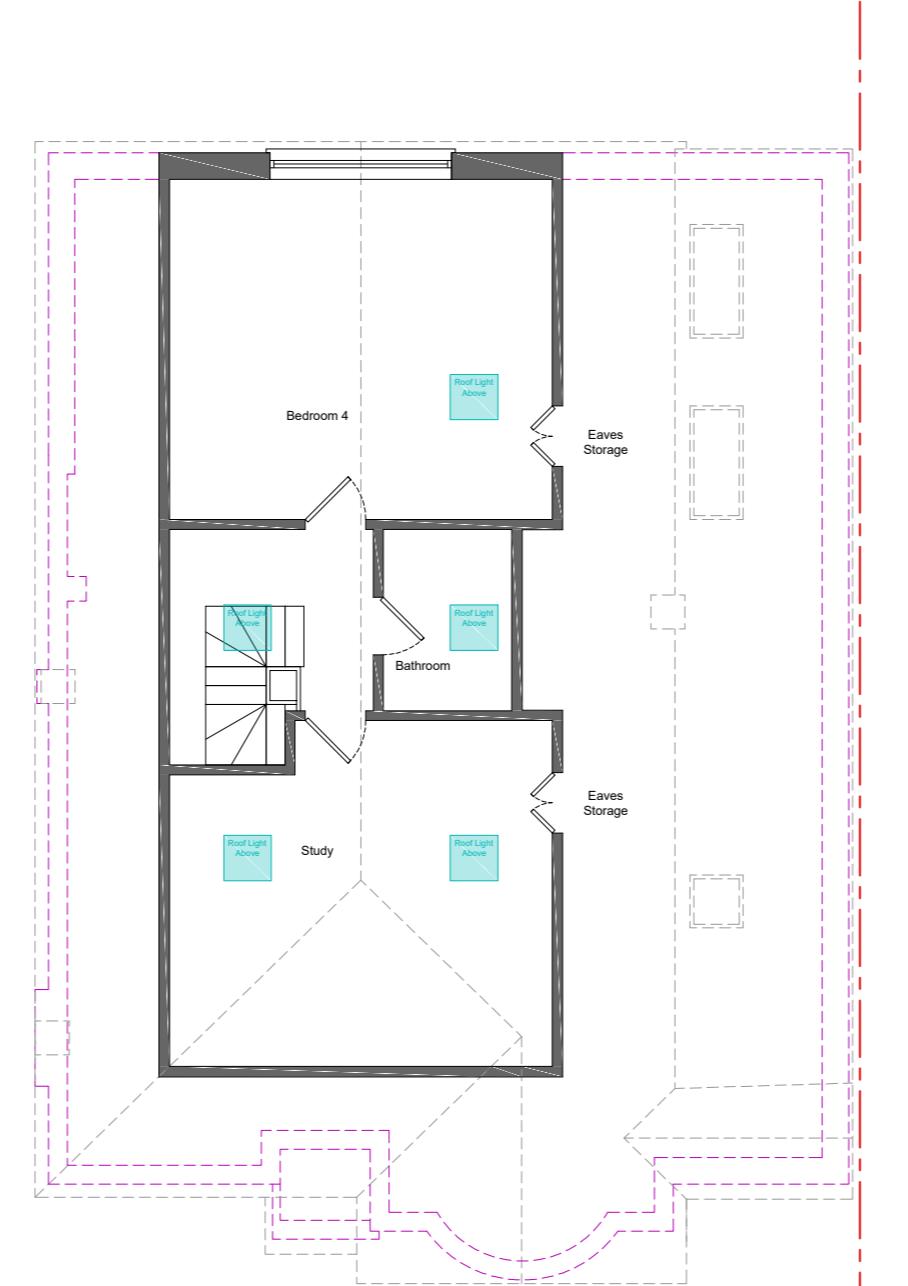


Drawing Number		CS40-05-1002A	Legend
As-Built		Plans & Elevations	
Site Address		40 Cheney Street PINNER HA5 2TB	
Paper Size		A2	Scale 1:100
Revision		A	Date 04.06.2024
Description		Position and Size of windows and doors changed on the Rear Elevation.	
Status		Proposed Extensions	
info@nearch.co.uk		Copyrights 2024	

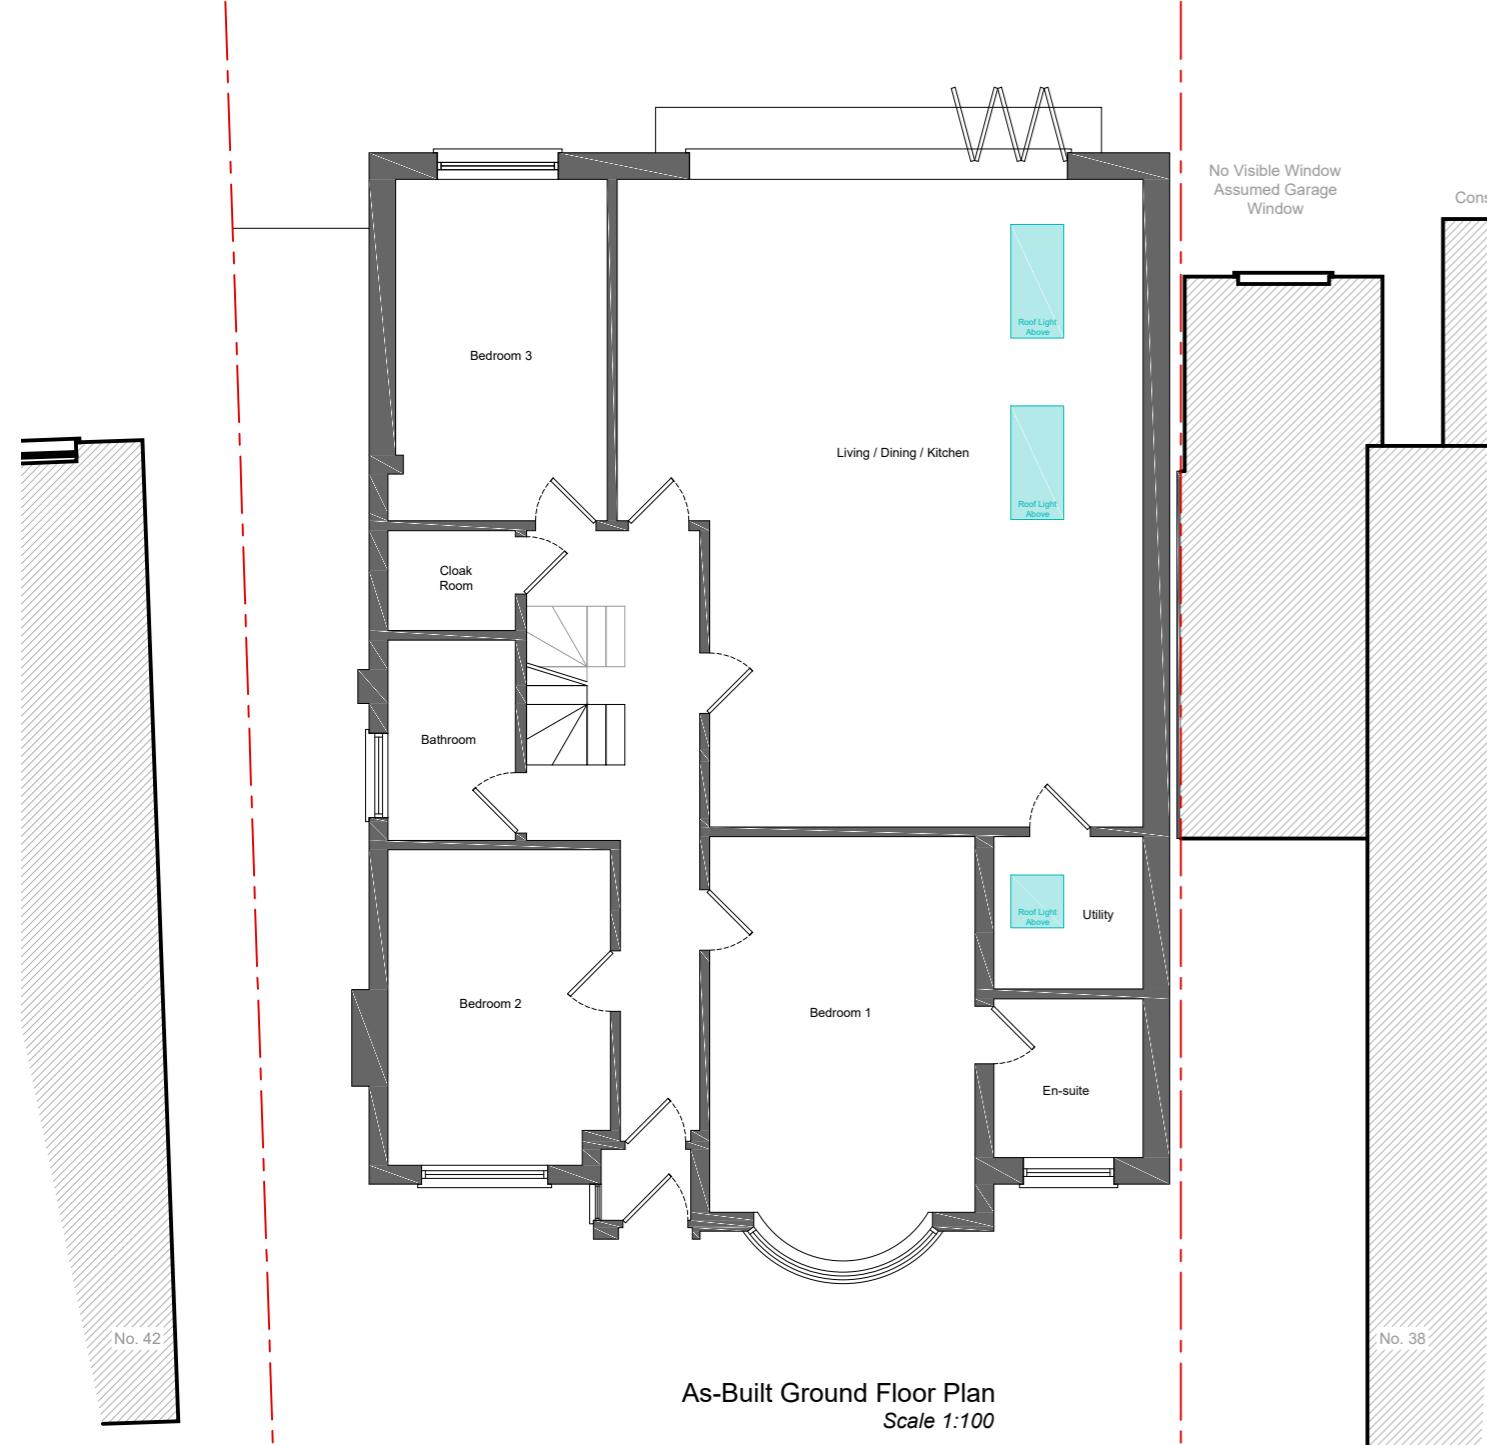

As-Approved - Ref:78059/APP/2023/2542
With Description:
Erection of a single storey extension to the side and rear of the dwelling. Conversion of garage to habitable accommodation with amendments to fenestration. Conversion of roof space to habitable use to include 4 side facing roof lights, extension to the rear and conversion from hip to gable end with new gable end window to the rear.

As-Built - Additional Changes include:

- 1x Roof light to side elevation pitched roof.
- 3x Roof lights to single storey side extensions flat roof.
- French Doors Replaced with a Window on the Rear Elevation
- French Doors and Bi-Folds Replaced with a 5m Bi-folds.

