

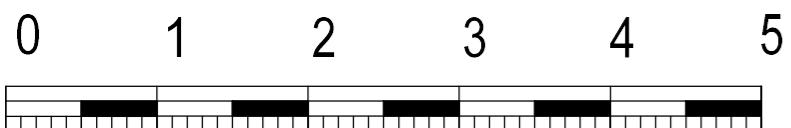
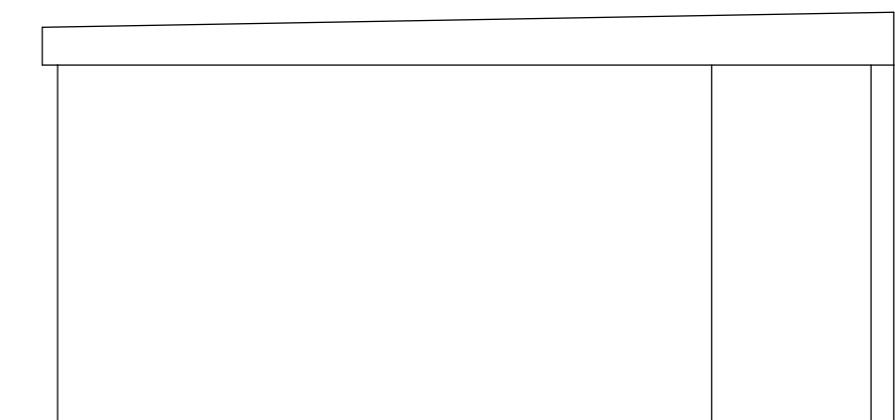
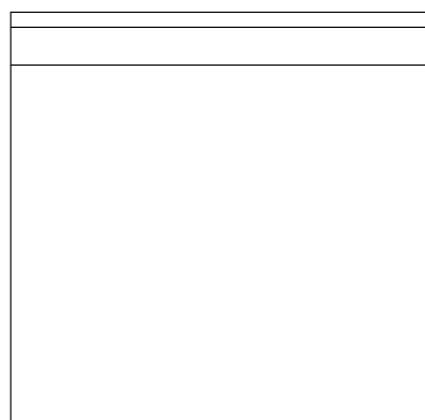


Metres

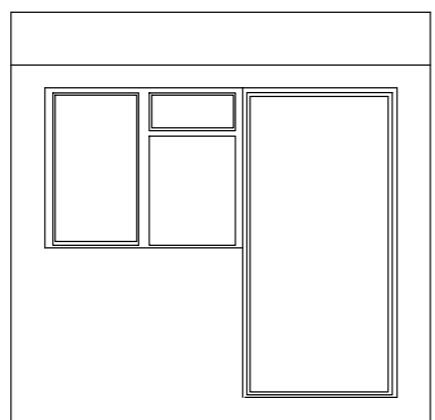

SCALE 1 : 50

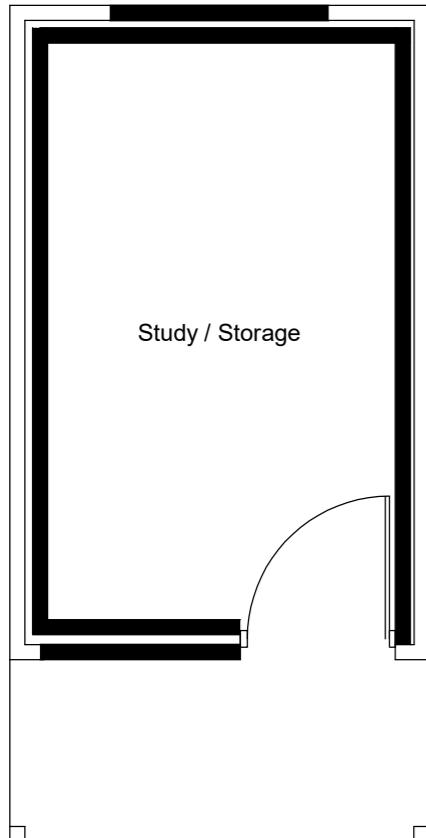

AS BUILT ELEVATIONS
Scale 1:50

AS BUILT LAYOUT
Scale 1:50

REV/NOTES:

Where building to the boundaries the adjacent owner is to be informed under the terms of the Party Wall Act 1996 and its provisions followed. Where building over boundaries the adjacent owner is to be served notice under section 65 of the Town & Country Planning Act 1990.

© This drawing and the works depicted are the copyright of ASB Property Consultants LTD and may not be reproduced or amended except by written permission of ASB Property Consultants LTD

Application:
HPA – Change of use from garage to habitable room including external changes

Client: Mr Vishal Shah Date: 17th May 2023
Site: 193 Tolcarne Drive Drawn By: Gurps Benning
Pinner, HA5 2DN
Scale: Refer to Drawing @ A3 Dwg.No: ASB975 – 02

ASB PROPERTY CONSULTANTS LTD
Planning consultants and Surveyors
Unit 1,
Gethclen House,
Dawley Road
Hayes, UB3 1EH Tel : 07854 351 934 – 0208 212 7981
Email : asbpropertyconsultantsltd@hotmail.com