



DRAWING TITLE:  
GROUND FLOOR PLAN, EXISTING AND AS BUILT

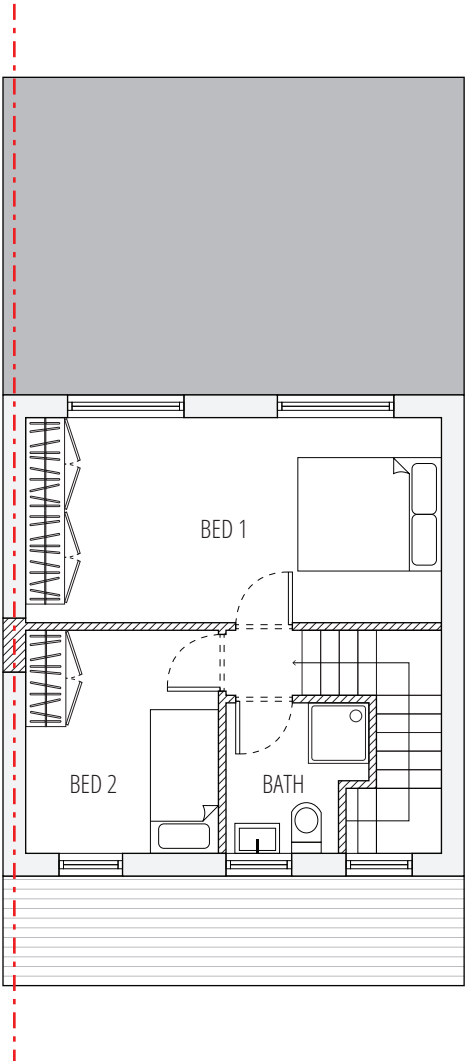

DRAWING TITLE:  
FIRST FLOOR PLAN, EXISTING

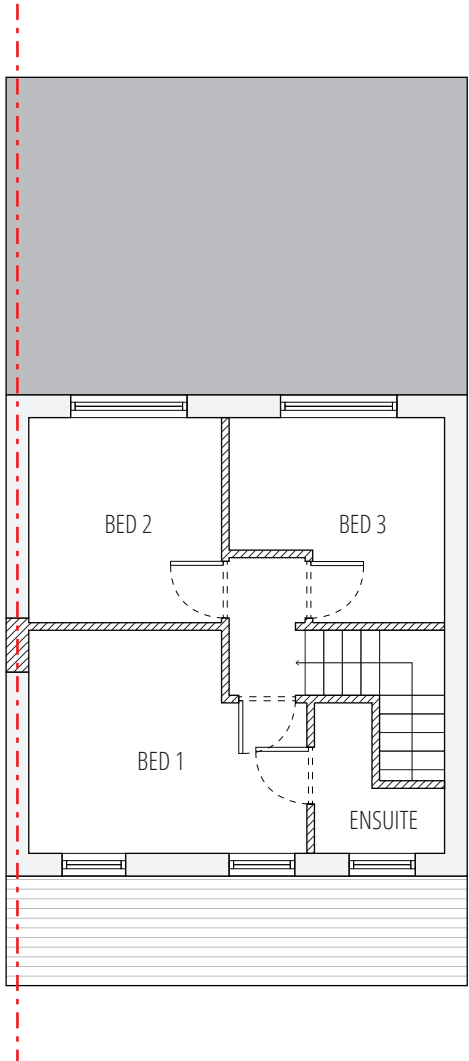

DRAWING TITLE:  
FIRST FLOOR PLAN, AS BUILT



DRAWING TITLE:  
ROOF PLAN, EXISTING AND AS BUILT