


DRAWING TITLE:
PRINCIPAL ELEVATION, EXISTING AND AS BUILT

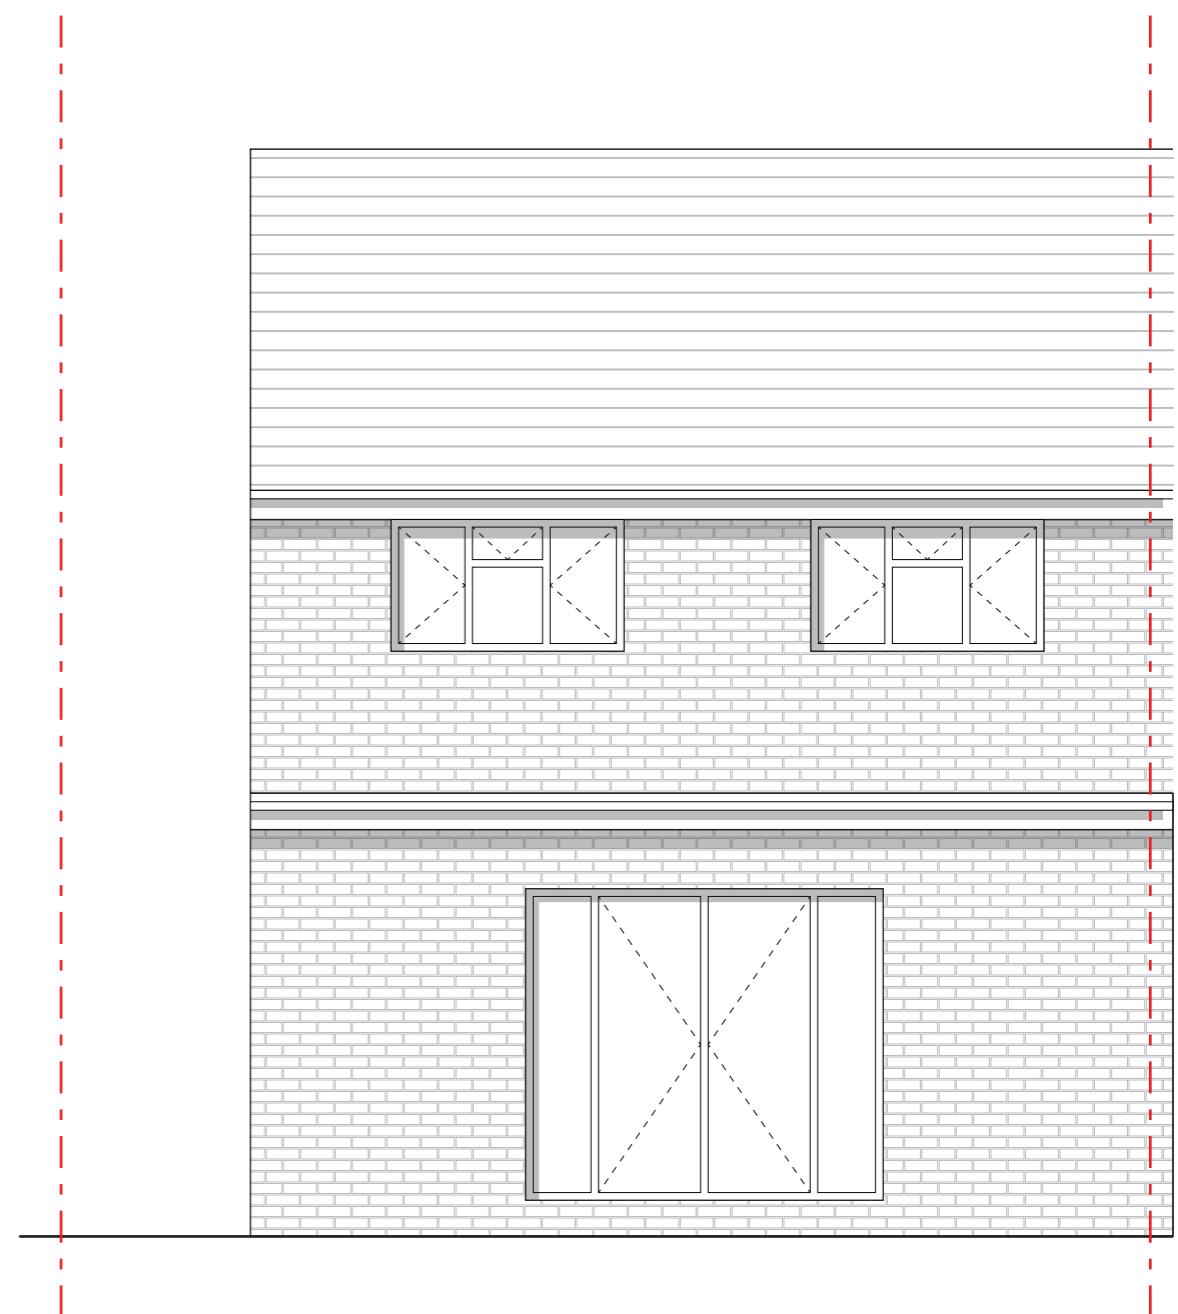

DRAWING TITLE:
REAR ELEVATION, EXISTING AND AS BUILT

THE AVENUE GROUP	NOTES	PLEASE NOTE: THIS IS NOT A WORKING DRAWING THIS DRAWING IS ONLY FOR PLANNING PURPOSES OR FOR BUILDERS TO OBTAIN ESTIMATES THIS DRAWING IS TO BE READ IN CONJUNCTION WITH ANY OTHER RELEVANT DRAWINGS ALL DETAILS AND DIMENSIONS ARE TO BE CARRIED OUT ON SITE, PRIOR TO WORKS COMMENCING OR ANY ORDERING OF MATERIALS	DRAWING TITLE: PRINCIPAL AND REAR ELEVATION, EXISTING AND AS BUILT PROJECT LOCATION: 129A THORNTON AVENUE, WEST DRAYTON	DATE: SEP 23	DRAWING NO: TA03	
---------------------------------	-------	--	--	-----------------	---------------------	---