




SITE LOCATION PLAN
AREA 2 HA
SCALE 1:1250 on A4
CENTRE COORDINATES: 510305, 189117



Supplied by Streetwise Maps Ltd
www.streetwise.net
Licence No: 100047474
23/04/2025 22:31

LOCATION PLAN
1: 1250

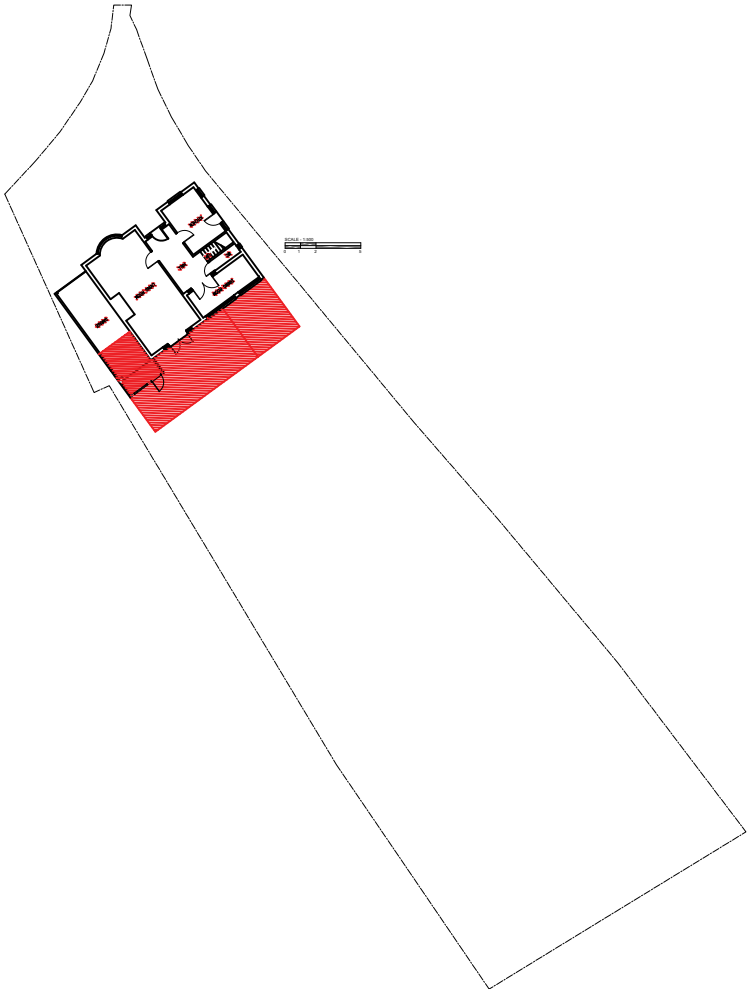

SITE PLAN
1: 500

Rev	UPDATED JULY 2026	
Project	2 Egerton Close Pinner HA5 2LP	
Drawing Title	Location Plan & As Built Site Plan	
Drawing Title	143 /P/A	Rev.
Rev: A	Scale: 1/1250 1: 500	Date: July 2026