





FRONT ELEVATION  
AS BUILT




RIGHTSIDE ELEVATION  
AS BUILT

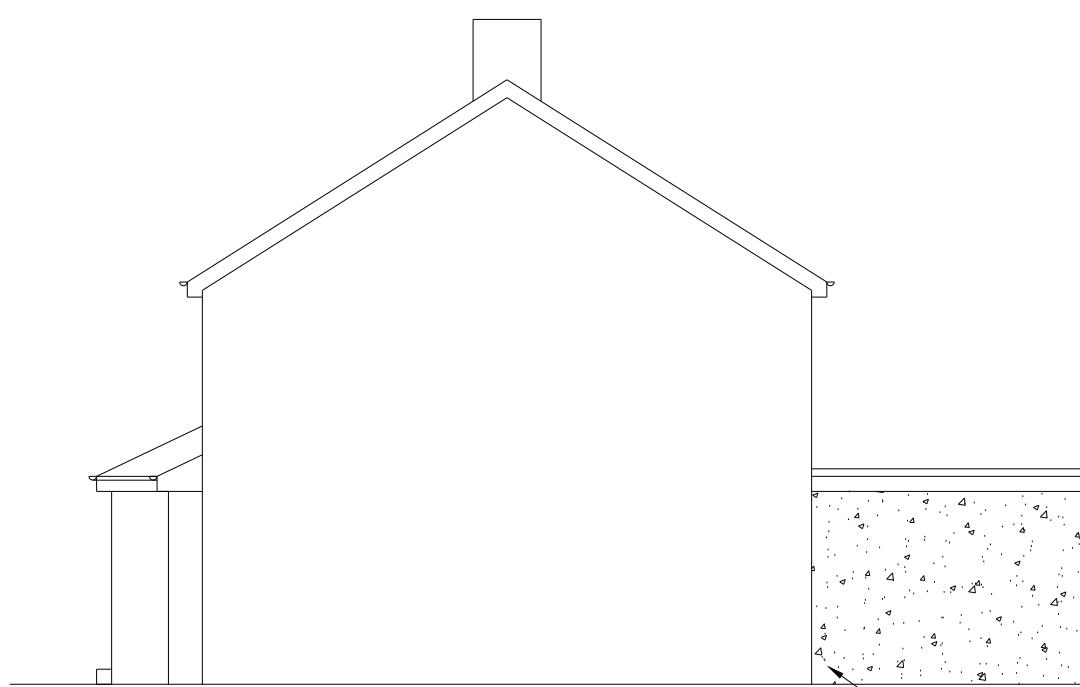

FRONT ELEVATION  
EXISTING

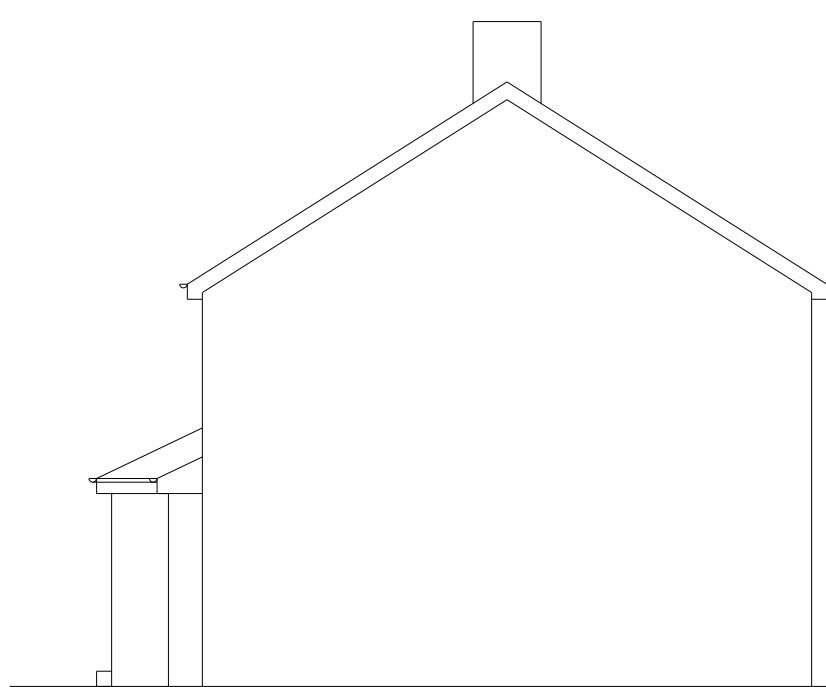

RIGHTSIDE ELEVATION  
EXISTING

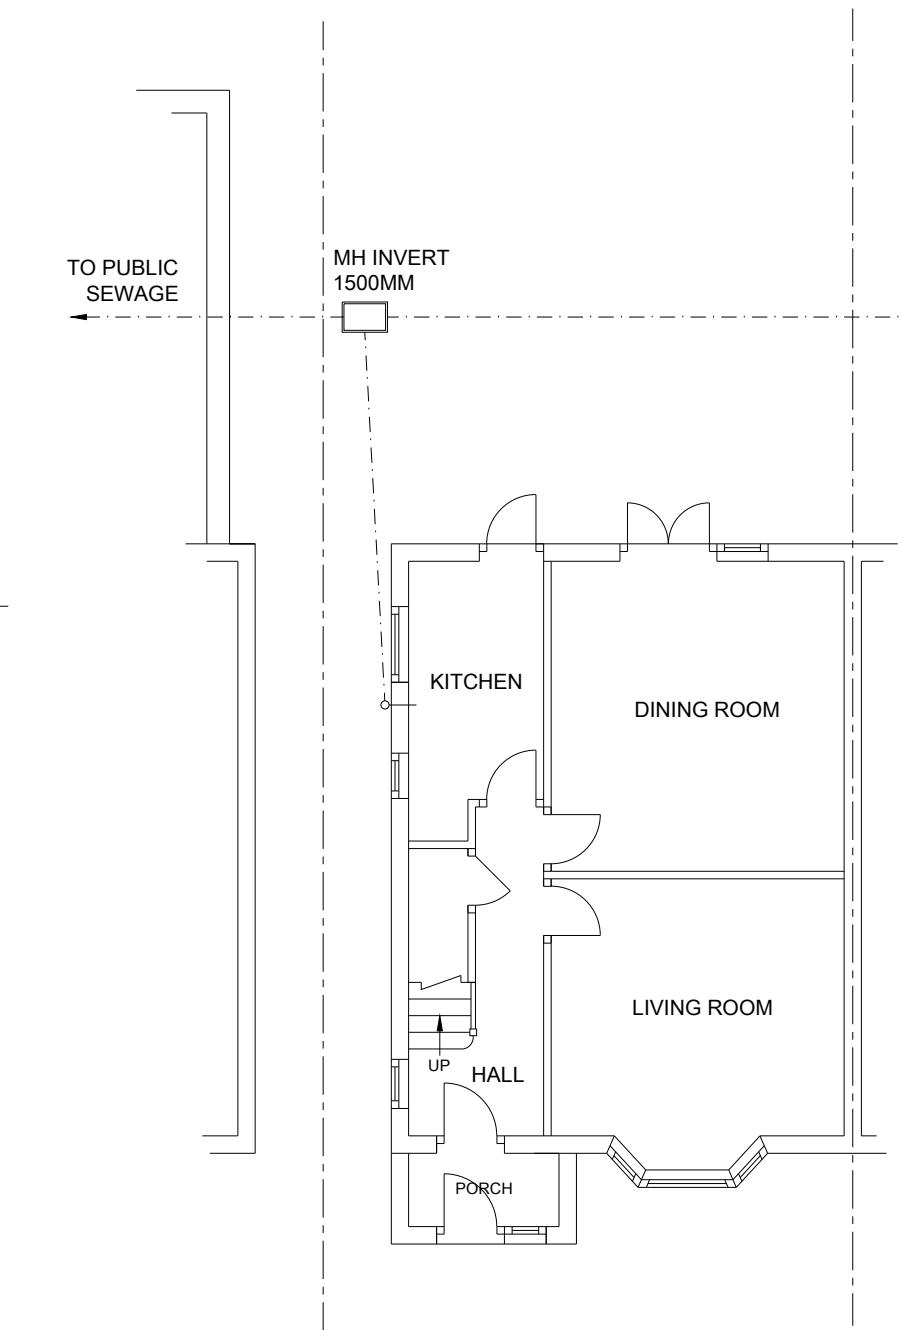

GROUND FLOOR PLAN  
EXISTING

1:100  
0 1m 2m 3m 4m 5m

REGULARISATION APPLICATION FOR SINGLE STOREY REAR  
EXTENSION AT 154 NESTLES AVENUE HAYES UB3 4QF  
CLIENT:- MR. H TAMANG  
SCALE :- 1:100 @ A3  
DRG. NO. :- 1334-B  
DRAWN BY :- ANIL HALLAN TEL:- 07734033013  
[www.akdraughting.com](http://www.akdraughting.com)

DATE :- OCT. 2025