




REAR ELEVATION  
AS BUILT

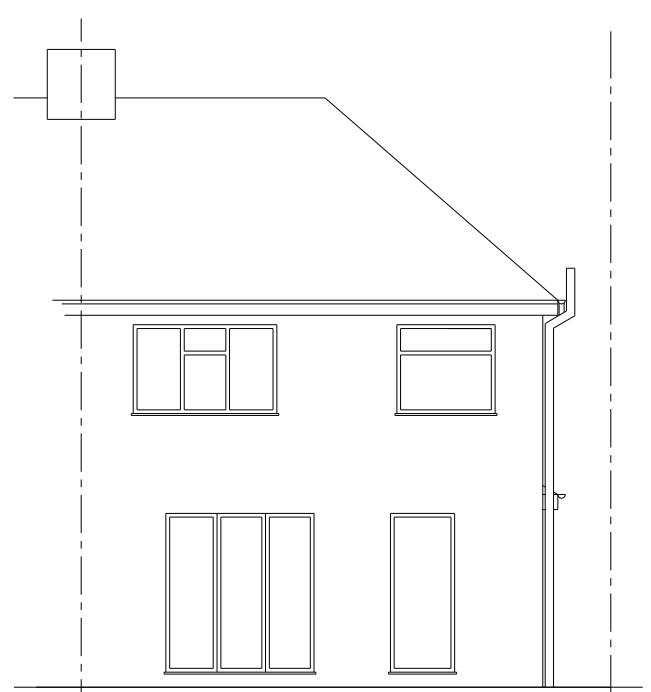


REAR ELEVATION  
EXISTING

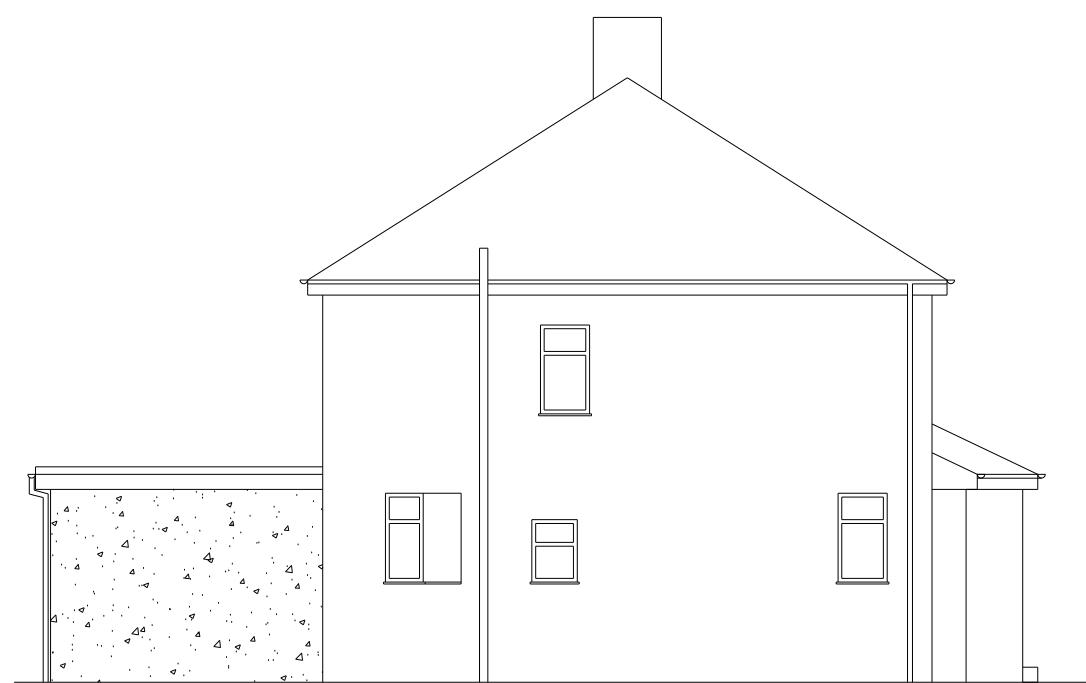

LEFTSIDE ELEVATION  
AS BUILT

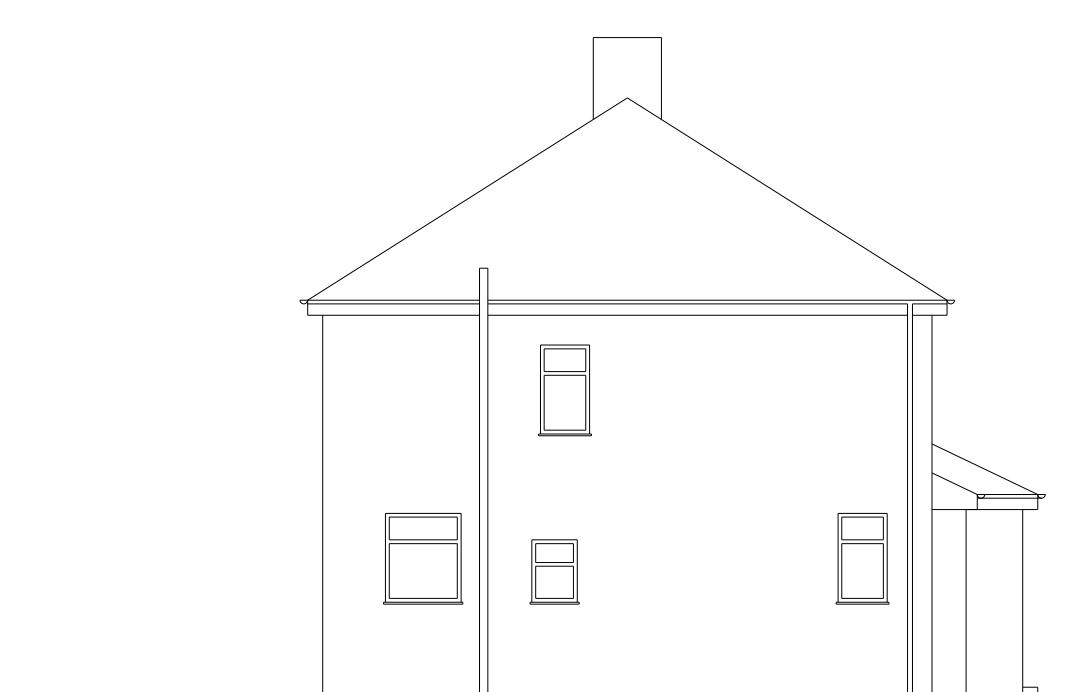

LEFTSIDE ELEVATION  
EXISTING

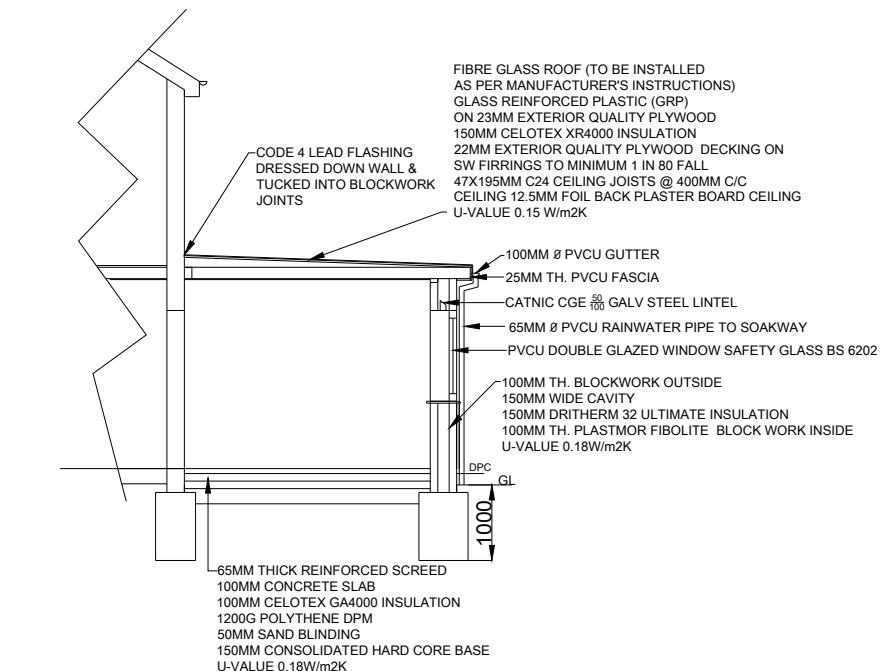

1:100  
0 1m 2m 3m 4m 5m

REGULARISATION APPLICATION FOR SINGLE STOREY REAR  
EXTENSION AT 154 NESTLES AVENUE HAYES UB3 4QF  
CLIENT:- MR. H TAMANG  
SCALE :- 1:100 @ A3  
DRG. NO. :- 1334-C  
DRAWN BY :- ANIL HALLAN TEL:- 07734033013  
www.akdraughting.com

DATE :- OCT. 2025