


Notes


All drawings to be signed off by building control before the commencement of any works. If works commence on a Building Notice, the Builder/property owner commences works at their own risk and ELA Design (or its Officer's) cannot accept and liability whatsoever for these works carried out.




Scale in Metres  
1:100

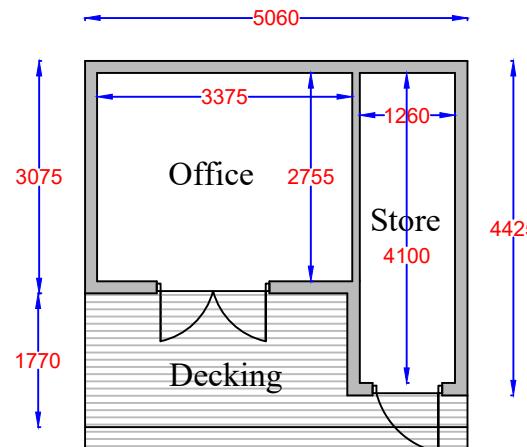


EXISTING GROUND FLOOR LAYOUT  
(AS BUILT)

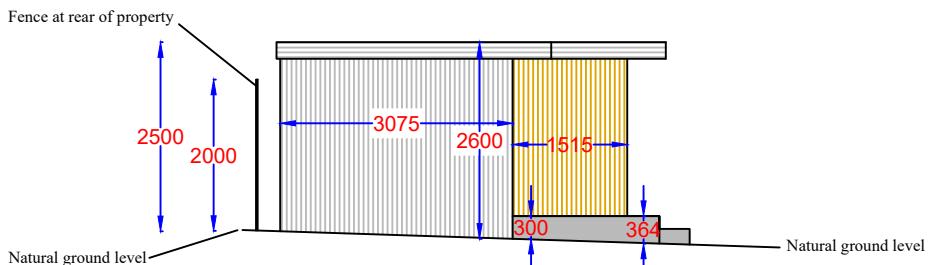


EXISTING SIDE ELEVATION  
(AS BUILT)

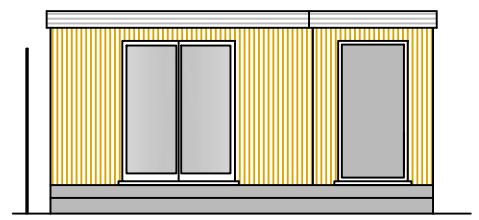


EXISTING FRONT ELEVATION  
(AS BUILT)

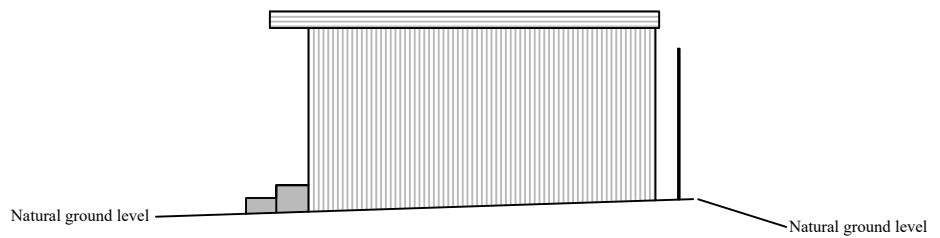

EXISTING SIDE ELEVATION  
(AS BUILT)

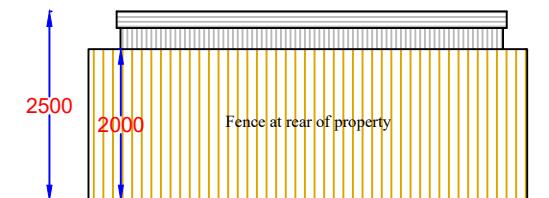

EXISTING REAR ELEVATION  
(AS BUILT)

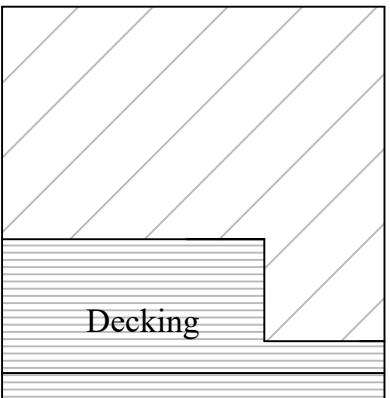

EXISTING ROOF PLAN  
(AS BUILT)

Rev	Date	Details	By
A	08/07/25	Revision A	CE

Project:  
Retrospective Outbuilding

Drawing:  
Existing Layout (As built)

Address:  
29 Myrtle Ave,  
Ruislip, HA4 8SA

Drawing No:  
ELA/1


Rev:  
A

A3 Scale:  
1:100

Drawn By:  
CE

Job No:  
3431

Date:  
02/12/25

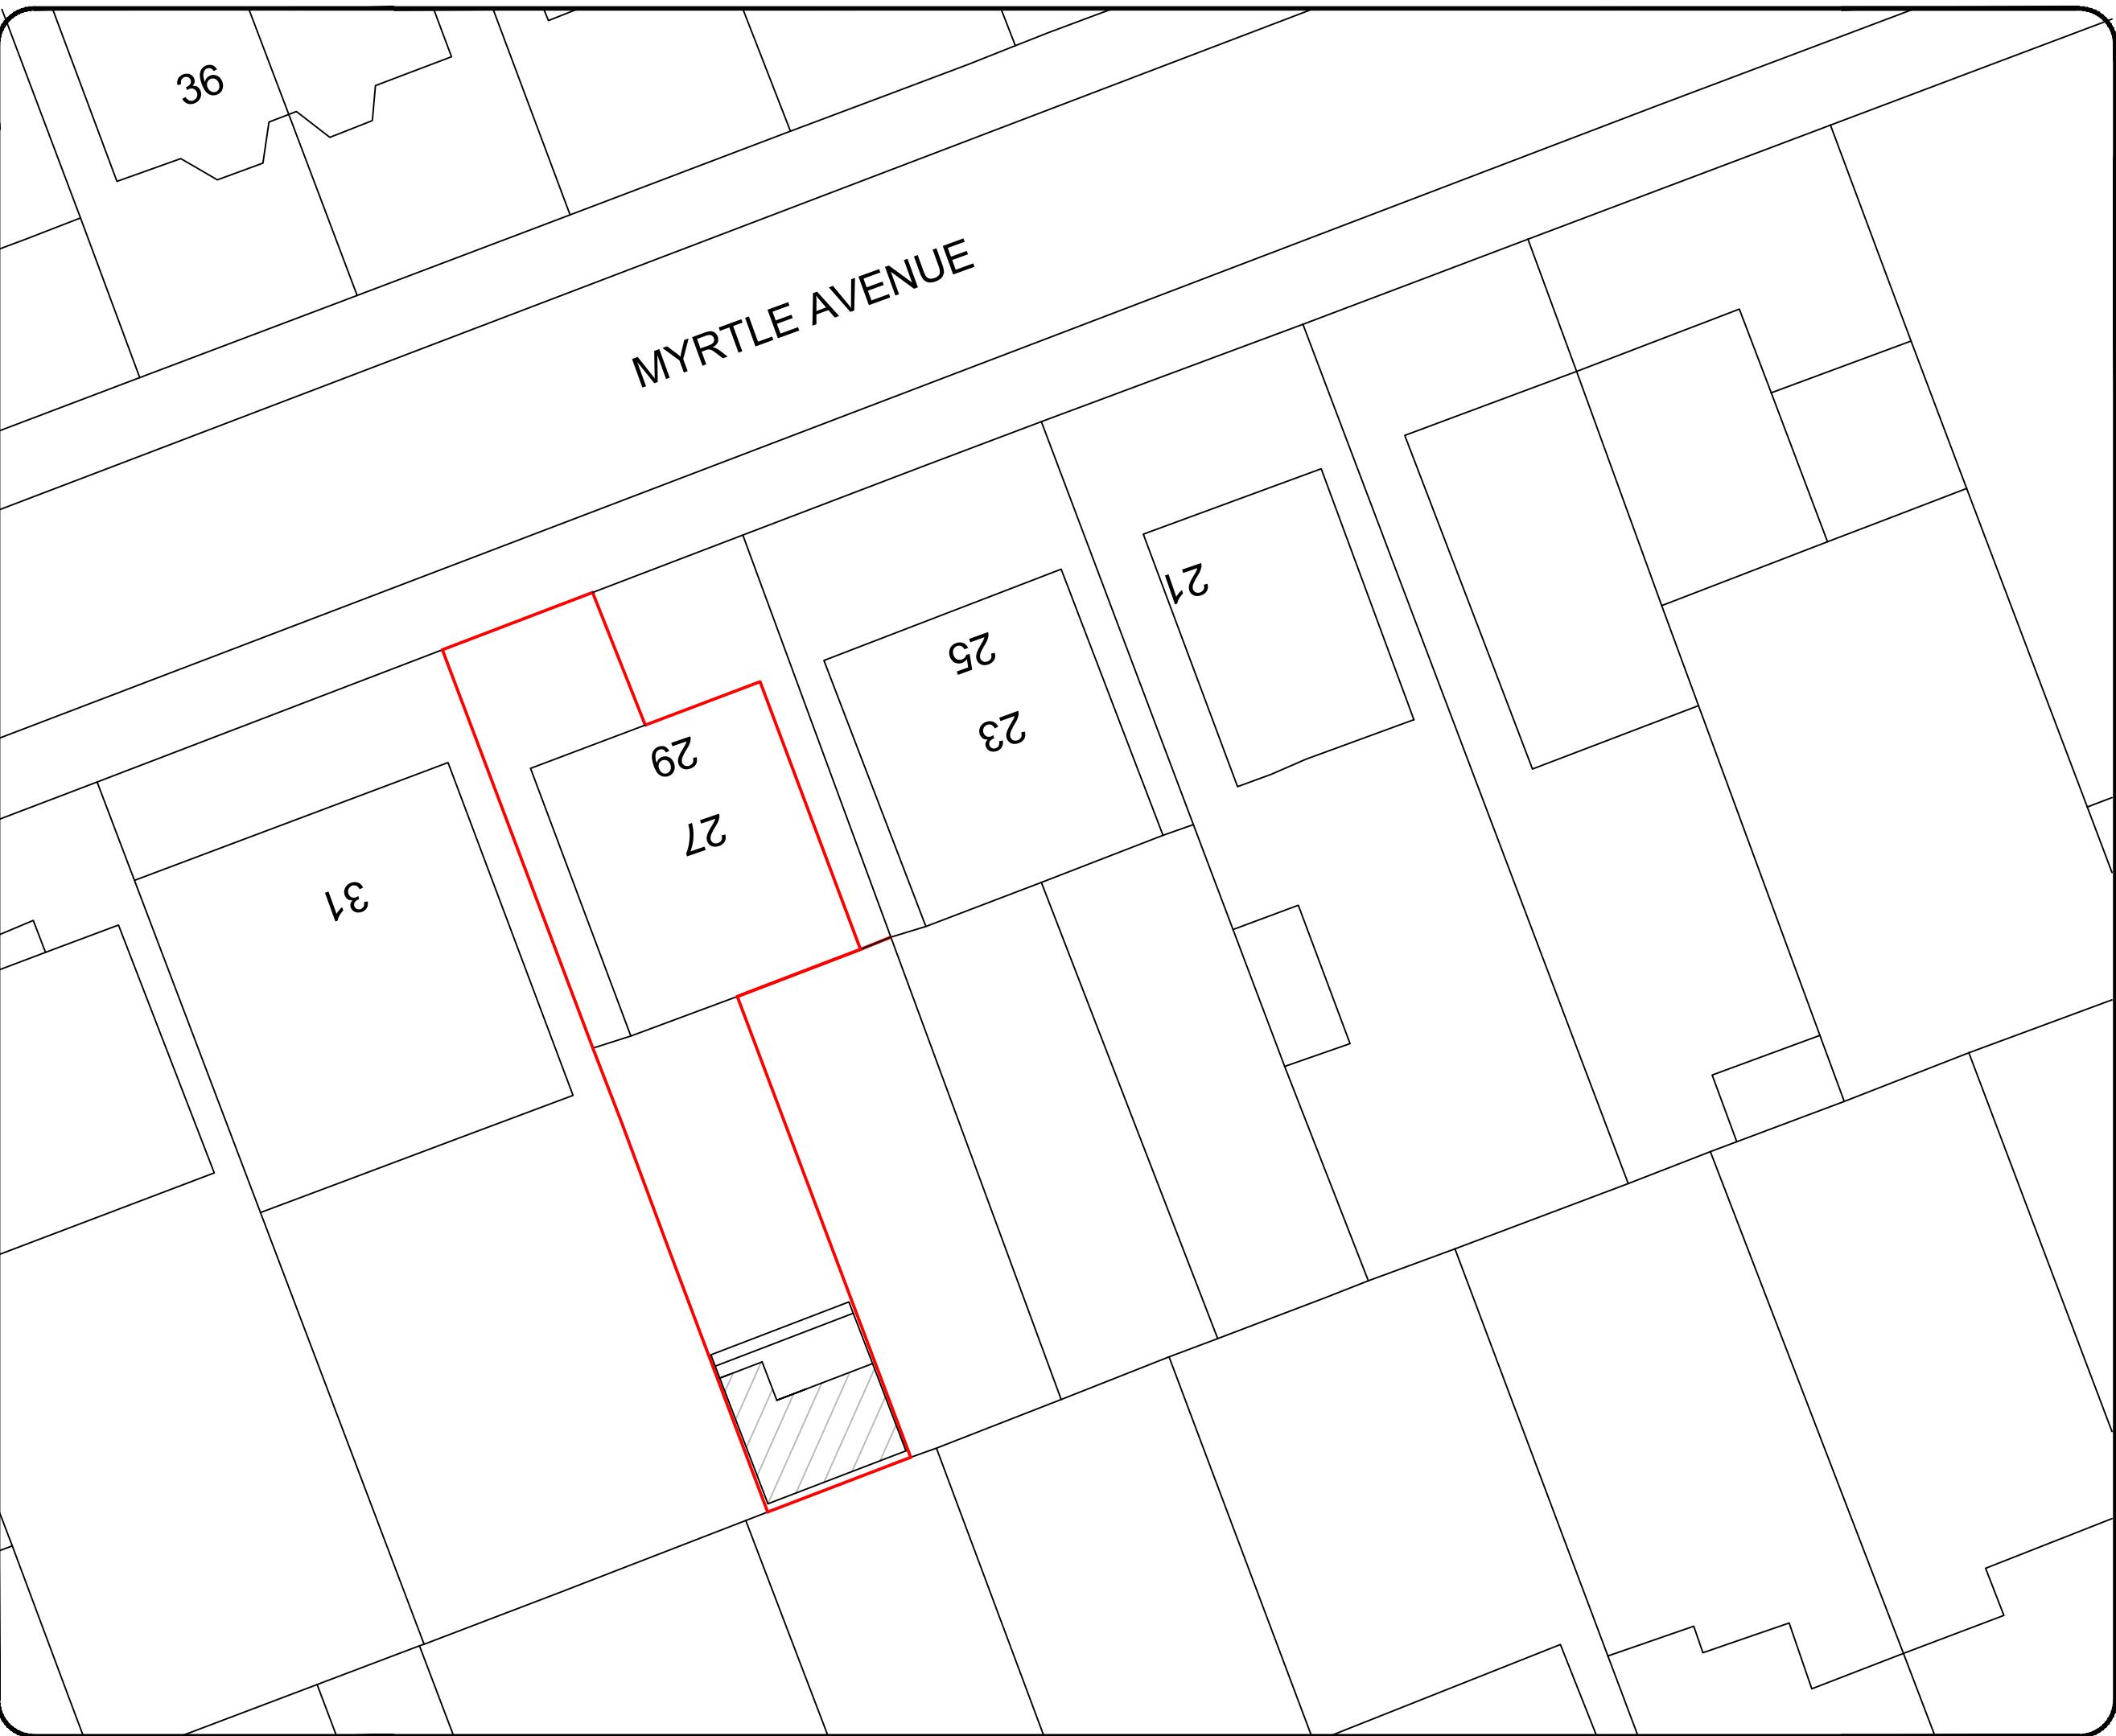


Notes

All drawings to be signed off by building control before the commencement of any works. If works commence on a Building Notice, the Builder/property owner commences works at their own risk and ELA Design (or its Officer's) cannot accept and liability whatsoever for these works carried out.






0  
2  
4  
6  
8  
10

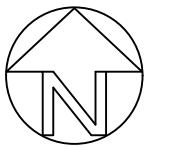

O/S licence number			
100060020			
Rev	Date	Details	By
A	08/07/25	Revision A	CE
Project: Retrospective Outbuilding			
Drawing: Block Plan			
Address: 29 Myrtle Ave, Ruislip, HA4 8SA			
Drawing No:		Rev:	
ELA/14			A
A3 Scale:	Drawn By:	Job No:	Date:
1:200	CE	3431	02/12/25
<b>ELA</b> design		ELA Design Beechcroft Riverside Avenue Broxbourne Herts EN10 6RA	
www.el-a-design.co.uk		Tel:- 07979510821	

Notes

All drawings to be signed off by building control before the commencement of any works. If works commence on a Building Notice, the Builder/property owner commences works at their own risk and ELA Design (or its Officer's) cannot accept and liability whatsoever for these works carried out.

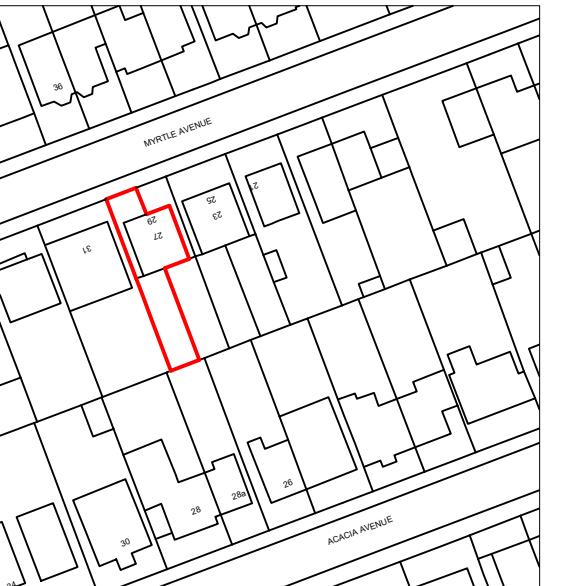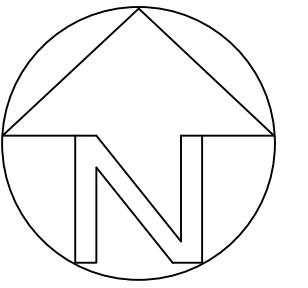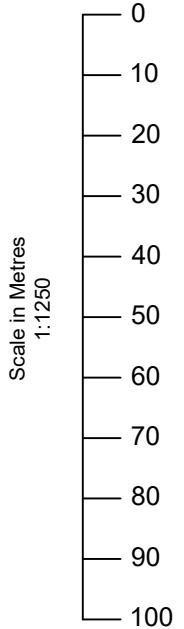

LOCATION PLAN

O/S licence number			
100060020			
Rev	Date	Details	By
A	08/07/25	Revision A	CE

Project:  
Retrospective Outbuilding

Drawing:  
Site Location Plan

Address:  
29 Myrtle Ave,  
Ruislip, HA4 8SA

Drawing No.:  
ELA/21

Rev:  
A

A3 Scale:  
1:1250

Drawn By:  
CE

Job No:  
3431

Date:  
02/12/25