



Plan of Proposed Ground Floor

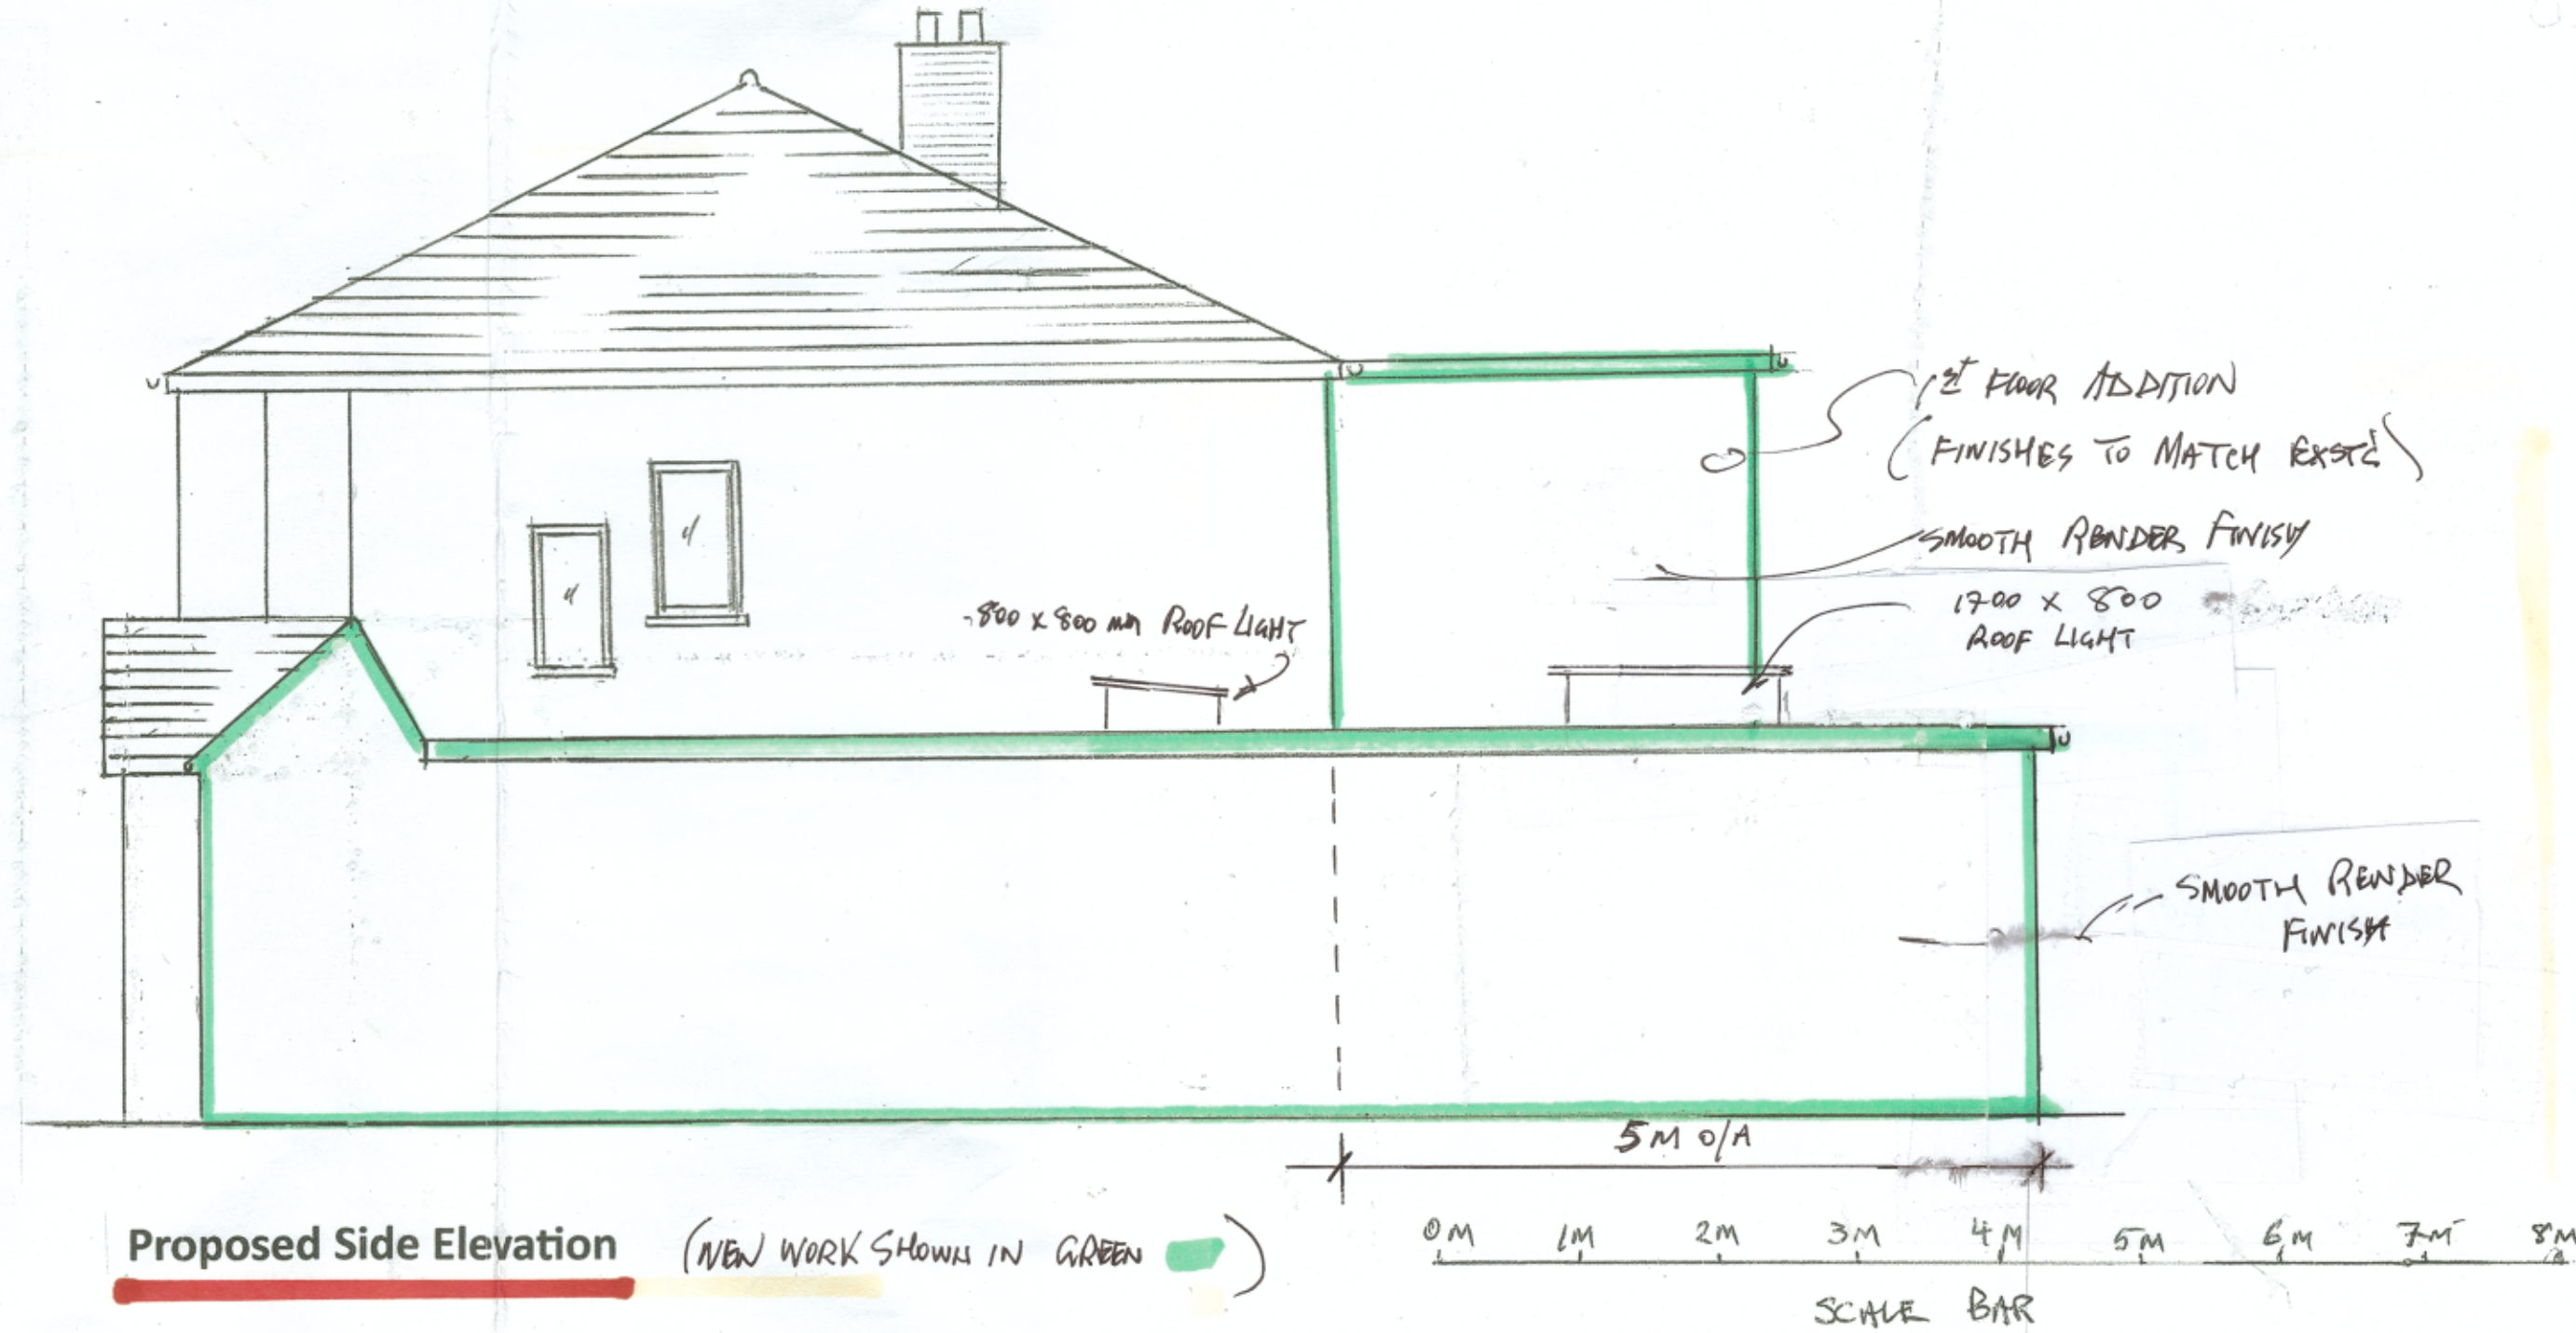

Proposed Side Elevation (NEW WORK SHOWN IN GREEN)

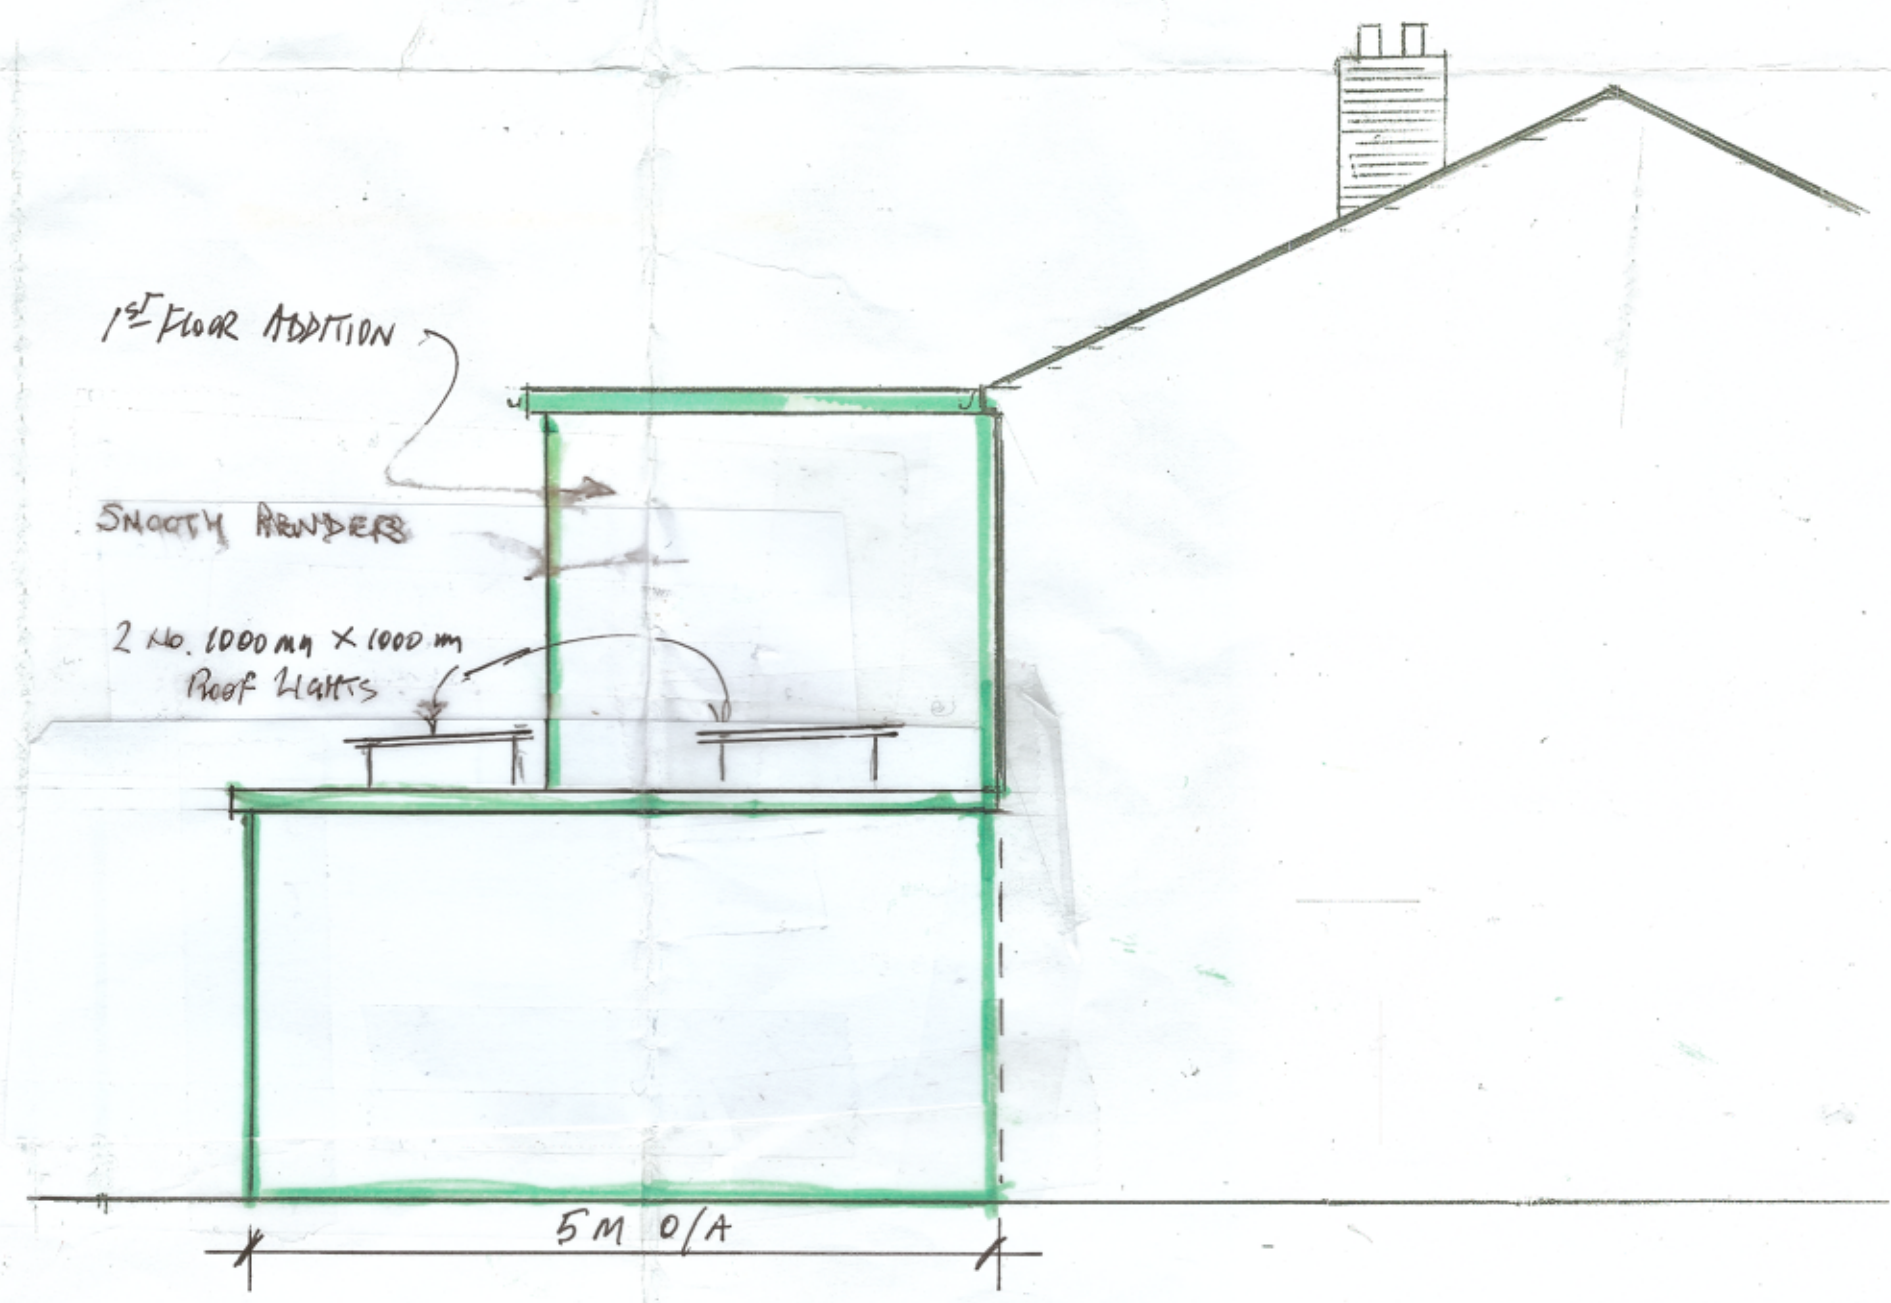

Proposed Side Elevation from South (NEW WORK SHOWN OUTLINED IN GREEN)

**Proposed Alterations to
No 160 Joel Street
Northwood Hills
London
HA5 2PE**

Drawing No HJ 2 A

Scale 1:50

For Mr and Mrs Joshi

REVISION A REAR ADDITION REDUCED IN SIZE
MARCH '26