




APPROVED APPLICATION 820/APP/2023/82  
SETTING OUT  
Scale 1:200

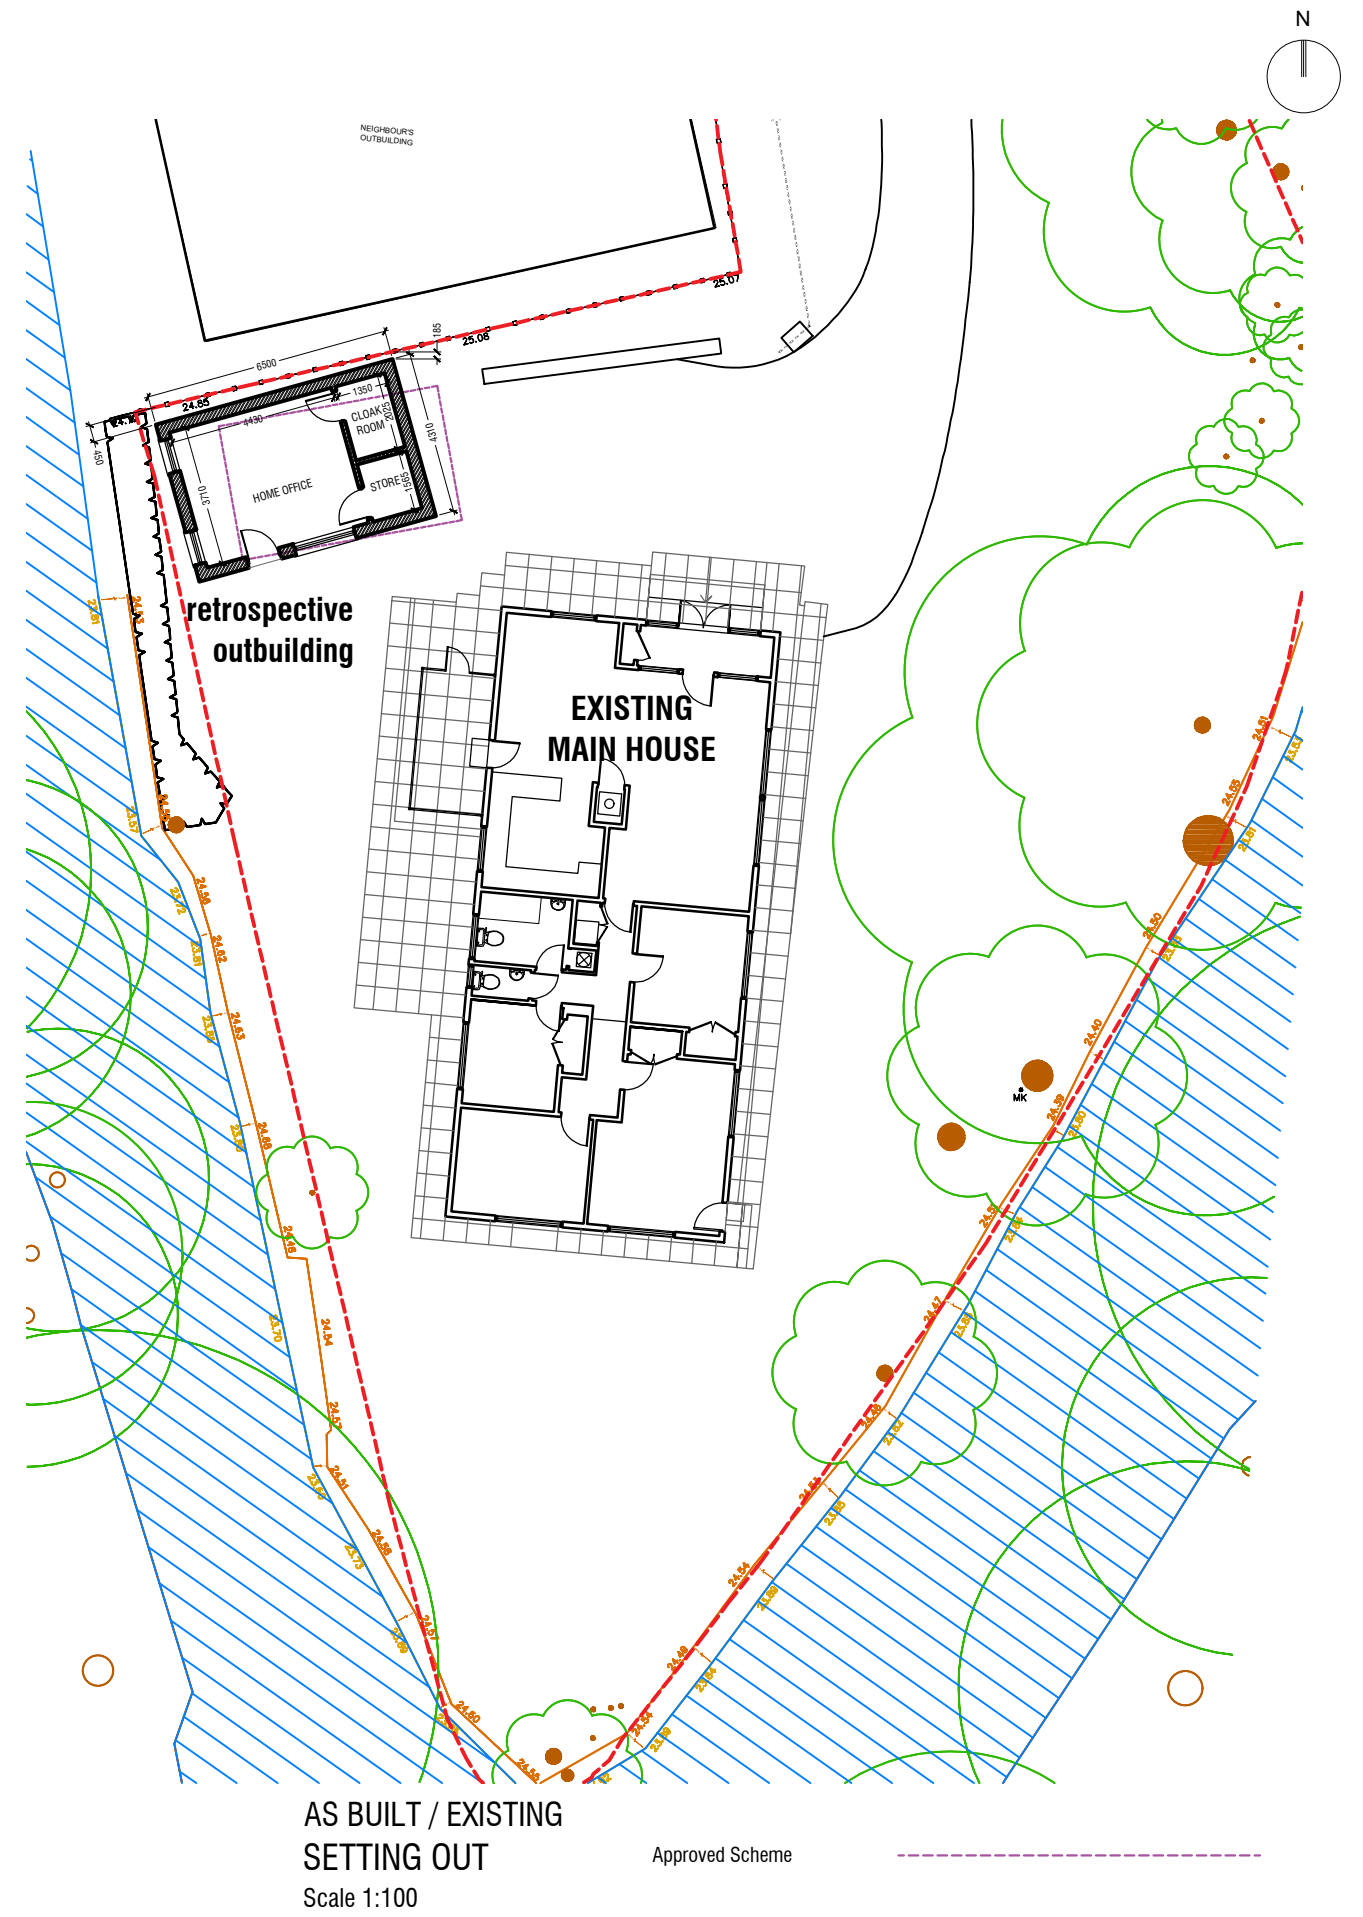

AS BUILT / EXISTING  
SETTING OUT  
Scale 1:100

Approved Scheme