




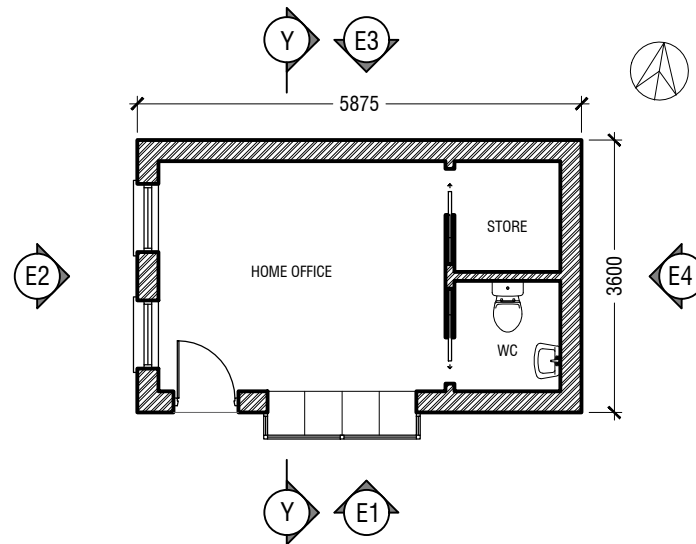

APPROVED APPLICATION 820/APP/2023/82
 OUTBUILDING - FLOOR PLAN
 Scale 1:100

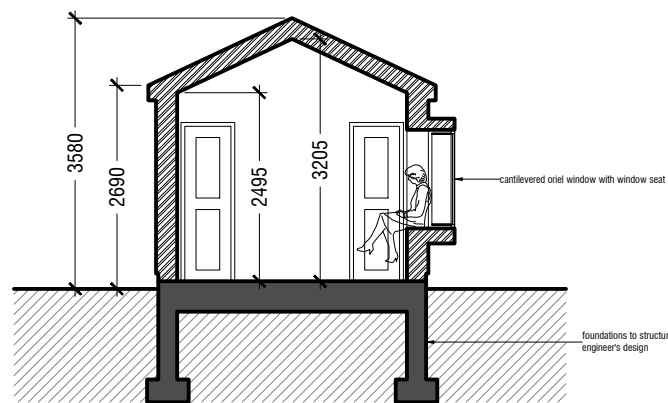


APPROVED APPLICATION 820/APP/2023/82
 OUTBUILDING - SECTION Y-Y
 Scale 1:100

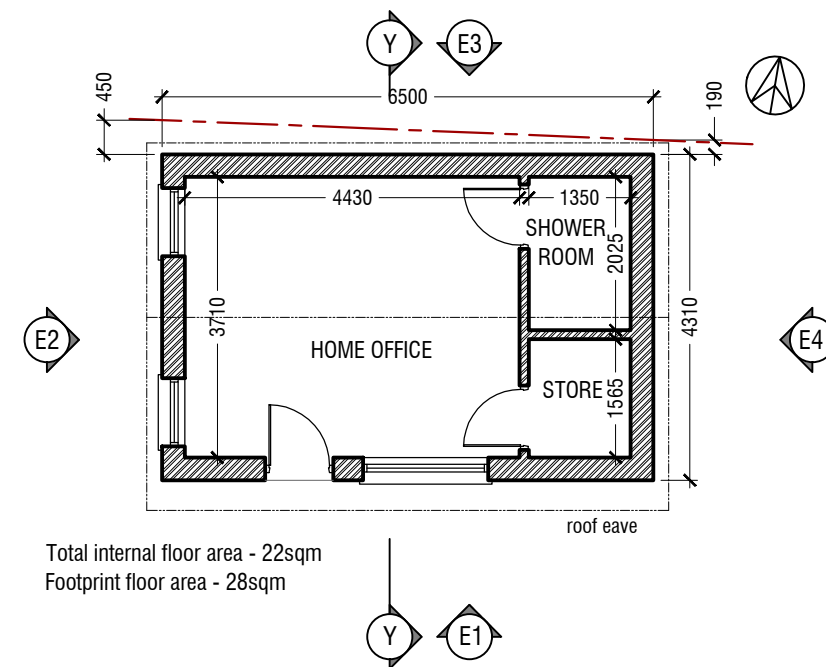

Total internal floor area - 22sqm
 Footprint floor area - 28sqm

AS BUILT / EXISTING
 OUTBUILDING - FLOOR PLAN
 Scale 1:100

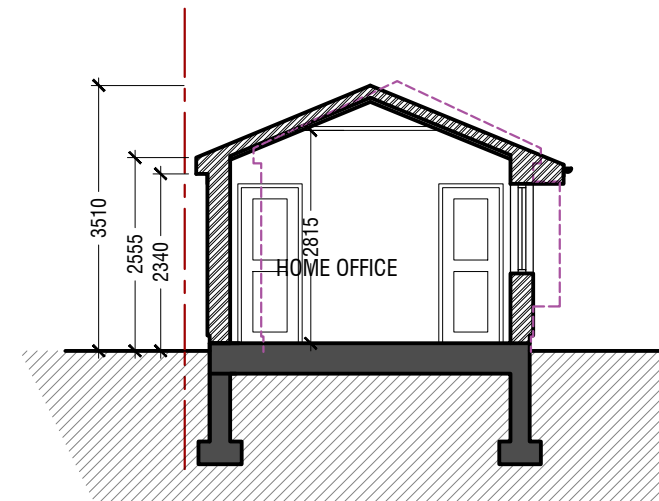

AS BUILT / EXISTING
 OUTBUILDING - SECTION Y-Y
 Scale 1:100

Approved Scheme -----
 Boundary line - - - - -

