



SITE PLAN
Scale 1:500




LOCATION PLAN
Scale 1:1250

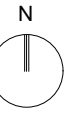

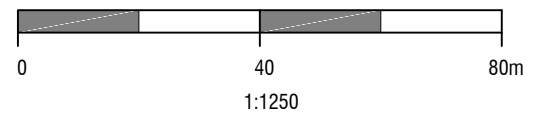



APPROVED APPLICATION 820/APP/2023/82
SETTING OUT
Scale 1:200

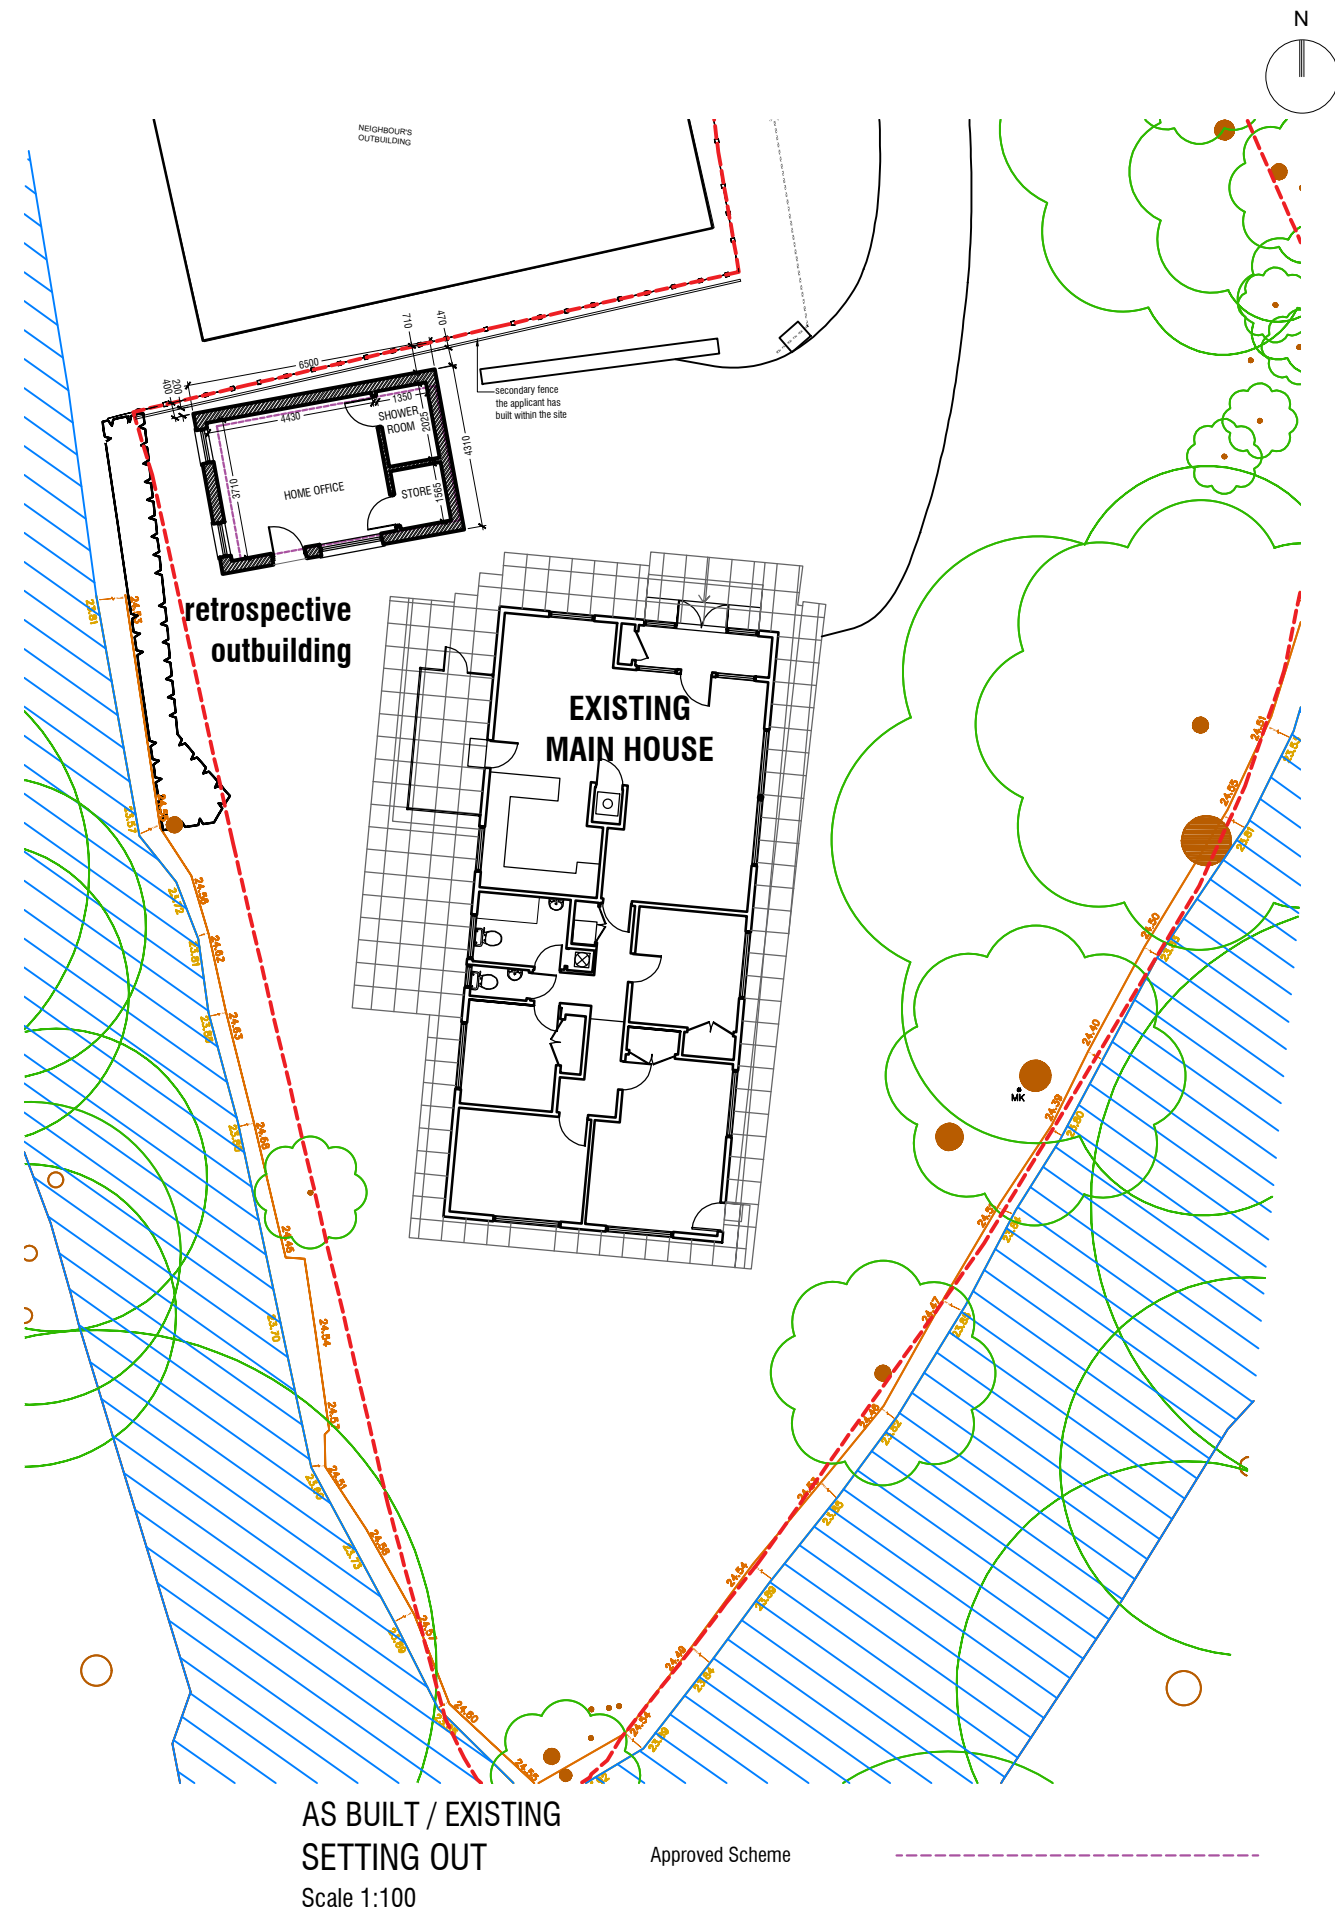


AS BUILT / EXISTING
SETTING OUT
Scale 1:100

Approved Scheme

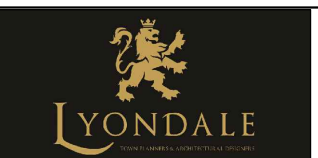


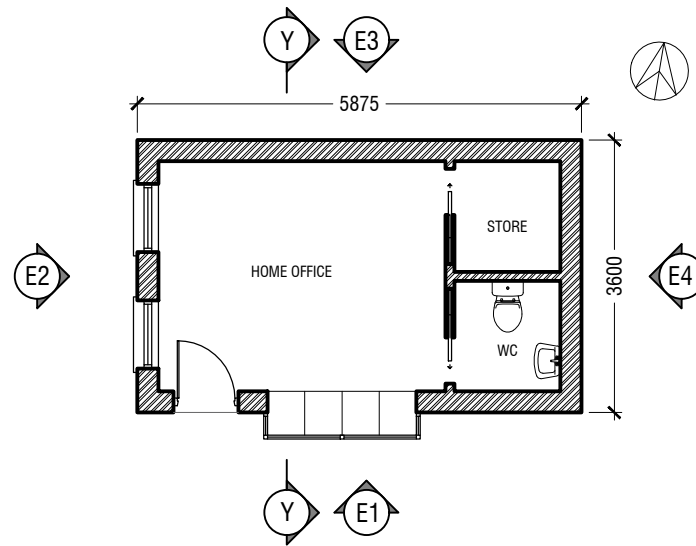


APPROVED APPLICATION 820/APP/2023/82
 OUTBUILDING - FLOOR PLAN
 Scale 1:100

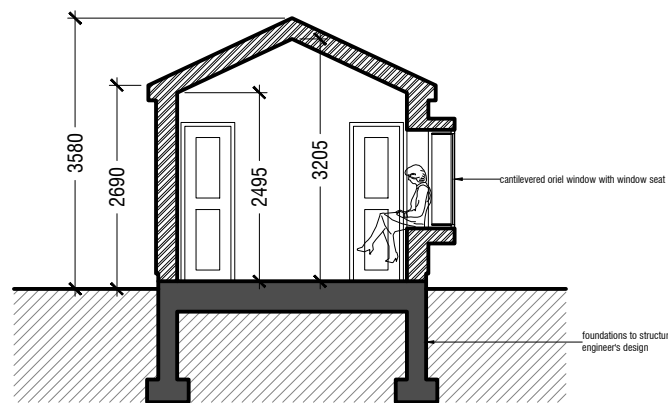


APPROVED APPLICATION 820/APP/2023/82
 OUTBUILDING - SECTION Y-Y
 Scale 1:100

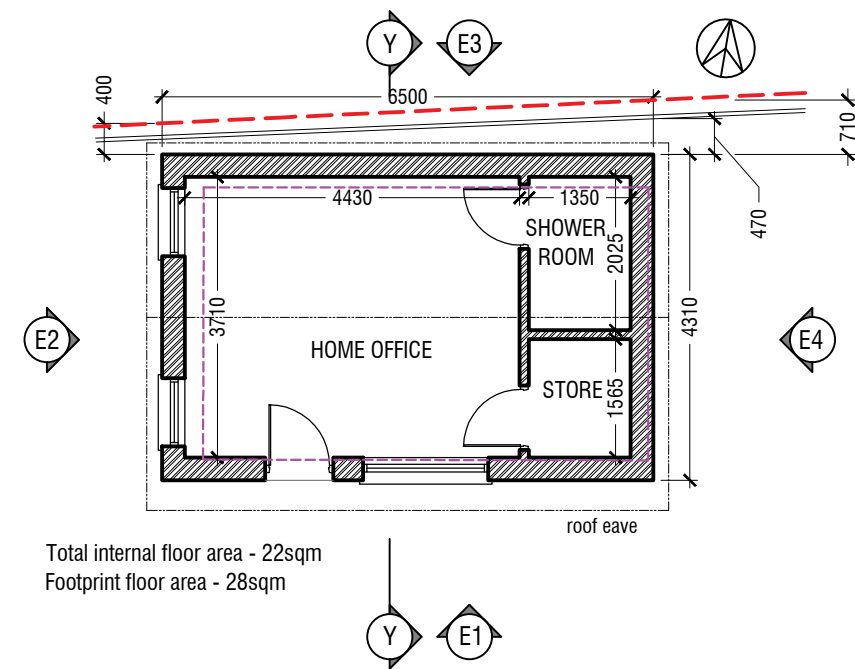


AS BUILT / EXISTING
 OUTBUILDING - FLOOR PLAN
 Scale 1:100

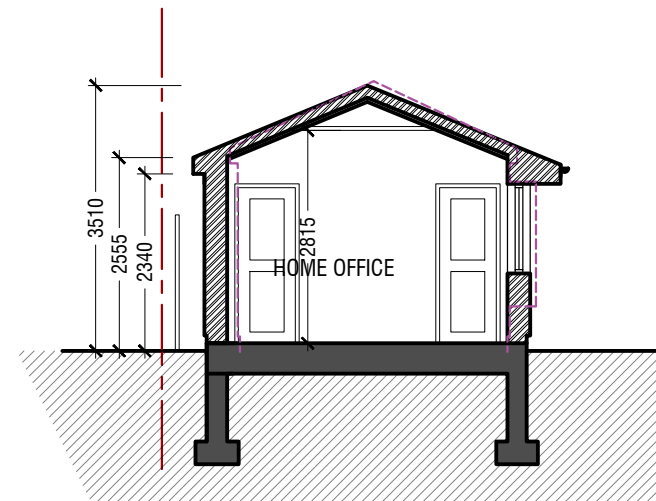


AS BUILT / EXISTING
 OUTBUILDING - SECTION Y-Y
 Scale 1:100

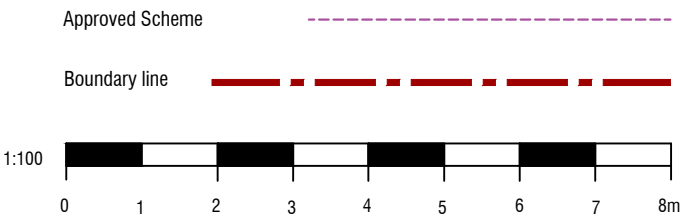

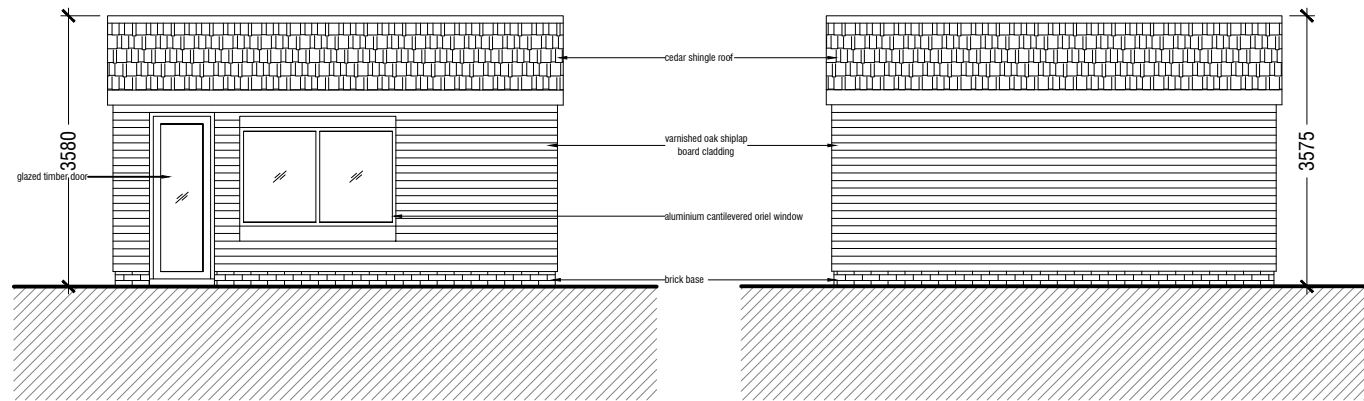


APPROVED APPLICATION 820/APP/2023/82
OUTBUILDING - ELEVATION E1
Scale 1:100

APPROVED APPLICATION 820/APP/2023/82
OUTBUILDING - ELEVATION E3
Scale 1:100

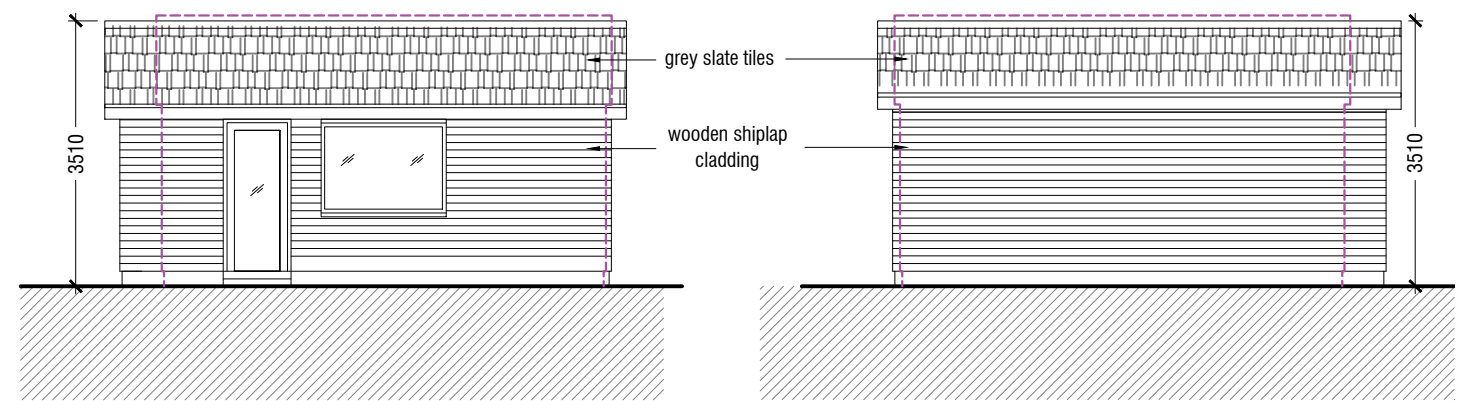


AS BUILT / EXISTING
OUTBUILDING - ELEVATION E1
Scale 1:100

AS BUILT / EXISTING
OUTBUILDING - ELEVATION E3
Scale 1:100

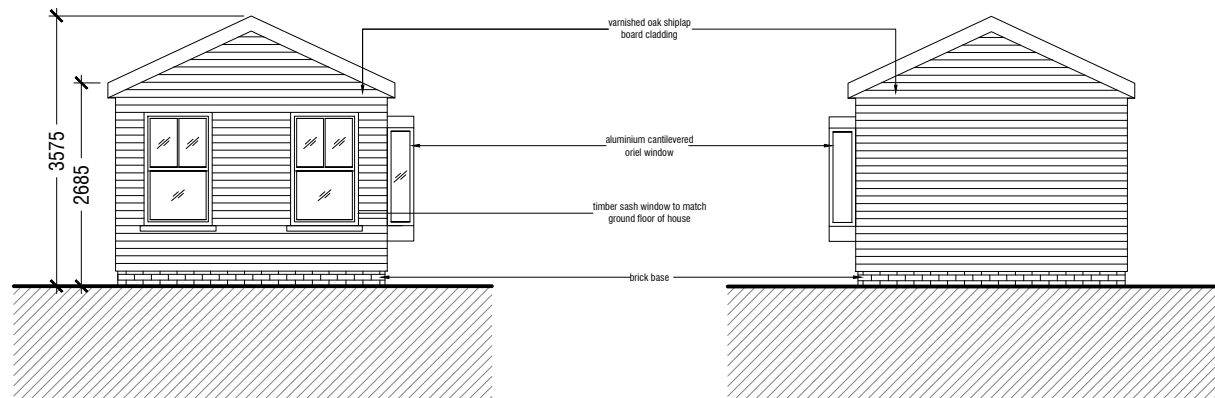

APPROVED APPLICATION 820/APP/2023/82
OUTBUILDING - ELEVATION E2
Scale 1:100

APPROVED APPLICATION 820/APP/2023/82
OUTBUILDING - ELEVATION E4
Scale 1:100

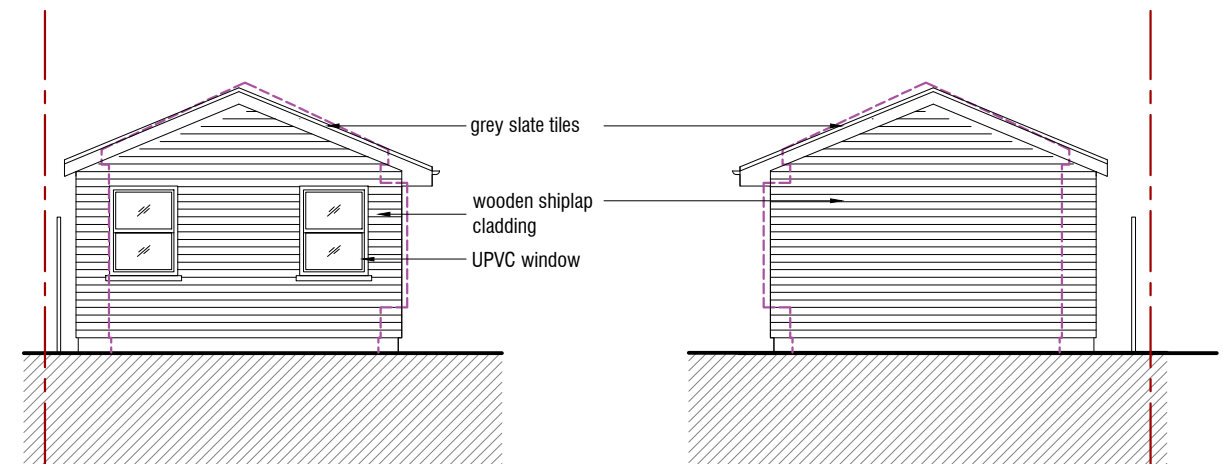

AS BUILT / EXISTING
OUTBUILDING - ELEVATION E2
Scale 1:100

AS BUILT / EXISTING
OUTBUILDING - ELEVATION E4
Scale 1:100

