



SITE PLAN
Scale 1:500




LOCATION PLAN
Scale 1:1250

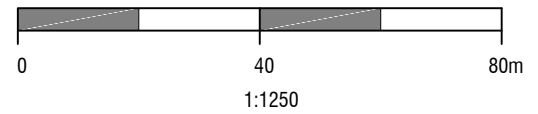




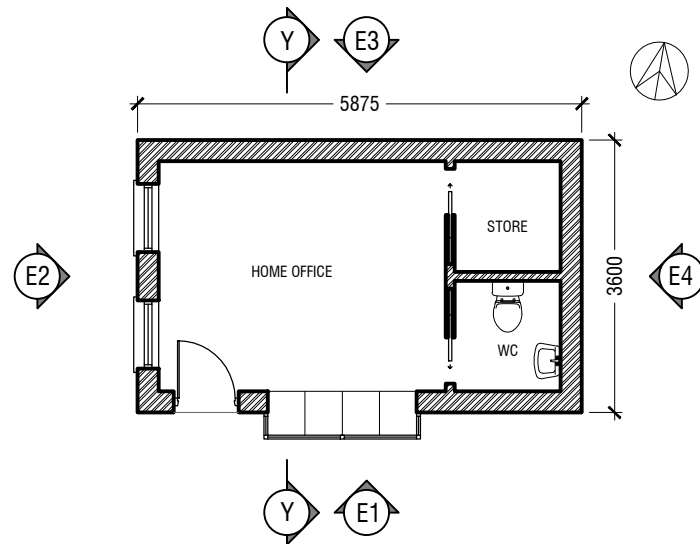

APPROVED APPLICATION 820/APP/2023/82
OUTBUILDING - FLOOR PLAN
Scale 1:100

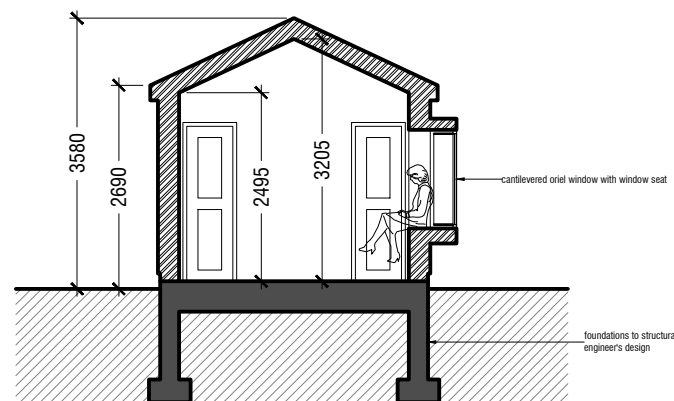


APPROVED APPLICATION 820/APP/2023/82
OUTBUILDING - SECTION Y-Y
Scale 1:100

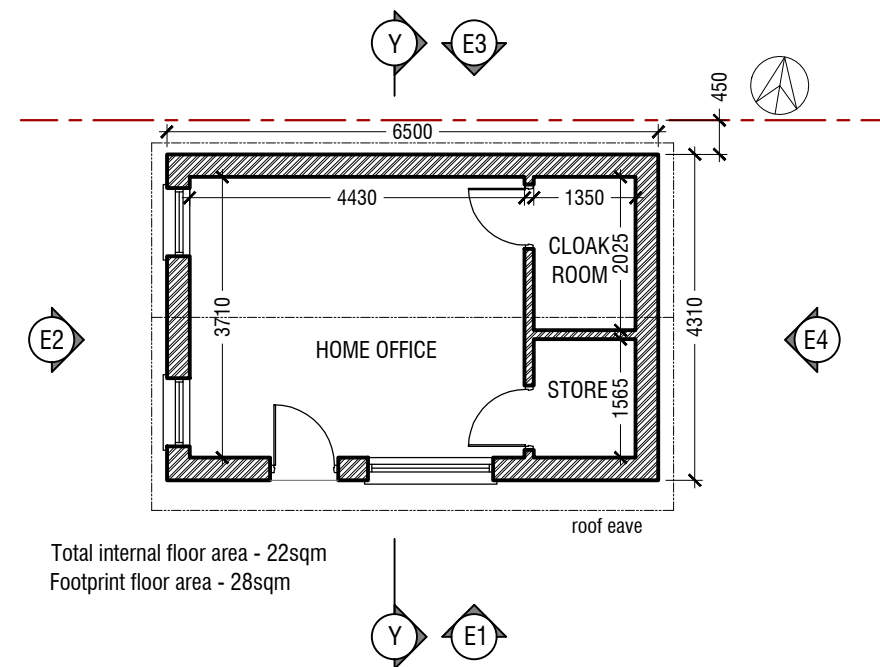

Total internal floor area - 22sqm
Footprint floor area - 28sqm


AS BUILT / EXISTING
OUTBUILDING - FLOOR PLAN
Scale 1:100

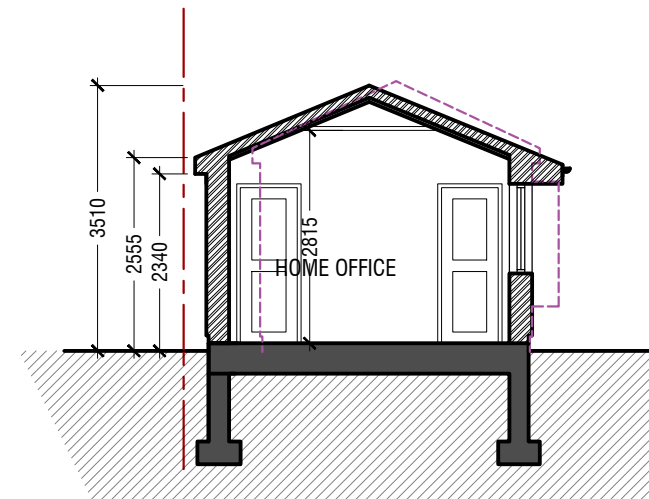


AS BUILT / EXISTING
OUTBUILDING - SECTION Y-Y
Scale 1:100


Approved Scheme -----

Boundary line - - - - -

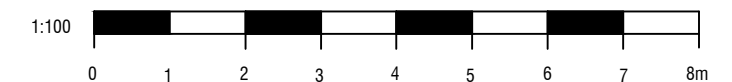


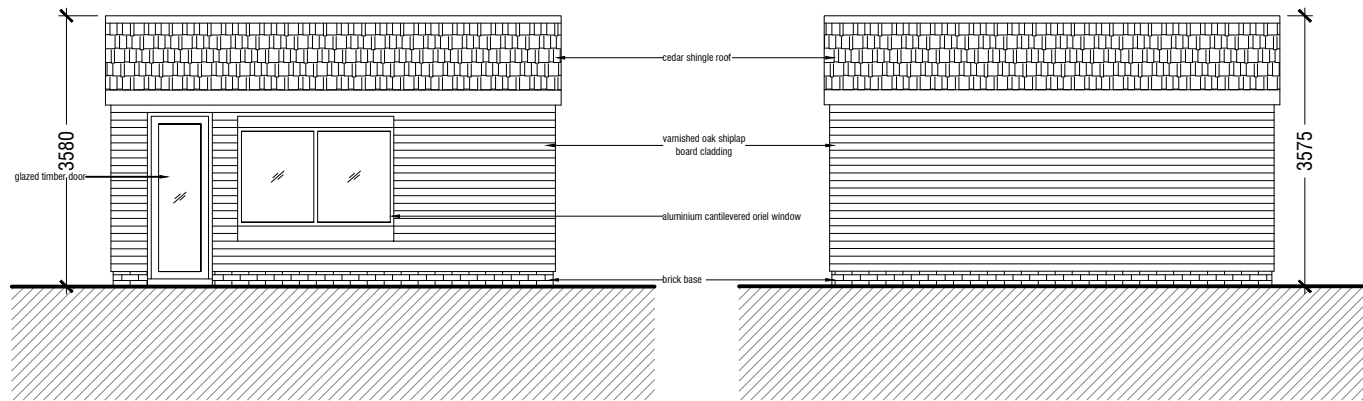


APPROVED APPLICATION 820/APP/2023/82
OUTBUILDING - ELEVATION E1
Scale 1:100

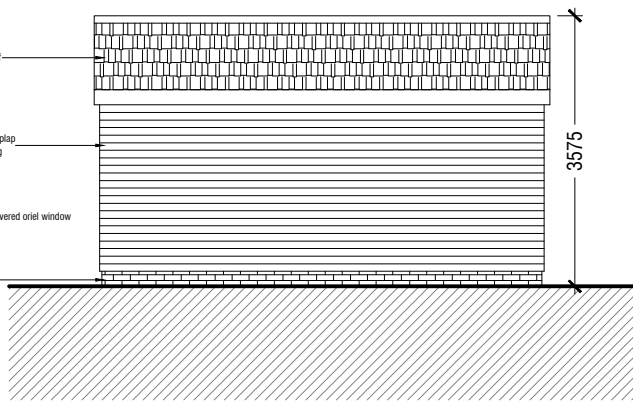


APPROVED APPLICATION 820/APP/2023/82
OUTBUILDING - ELEVATION E3
Scale 1:100

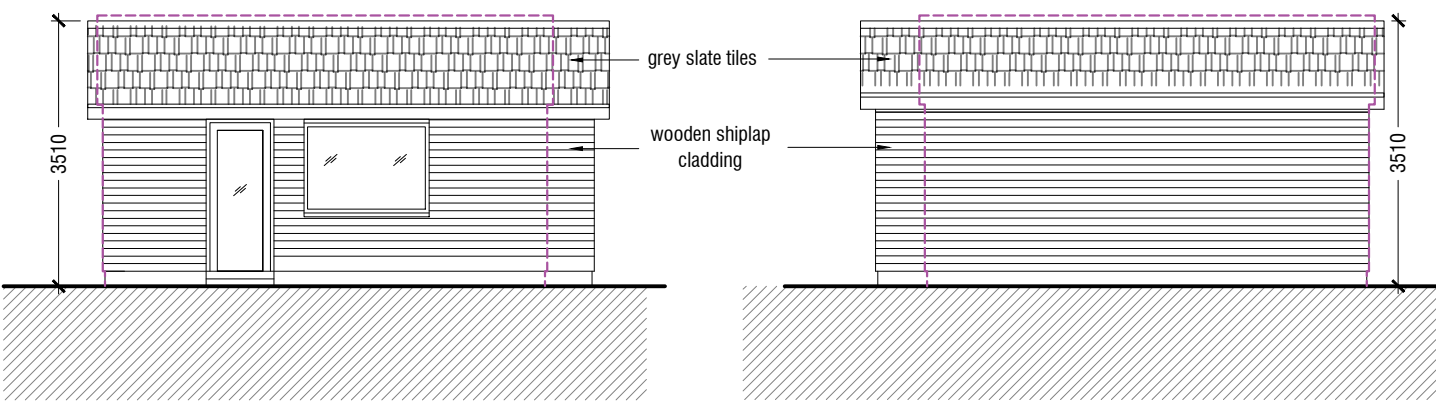


AS BUILT / EXISTING
OUTBUILDING - ELEVATION E1
Scale 1:100

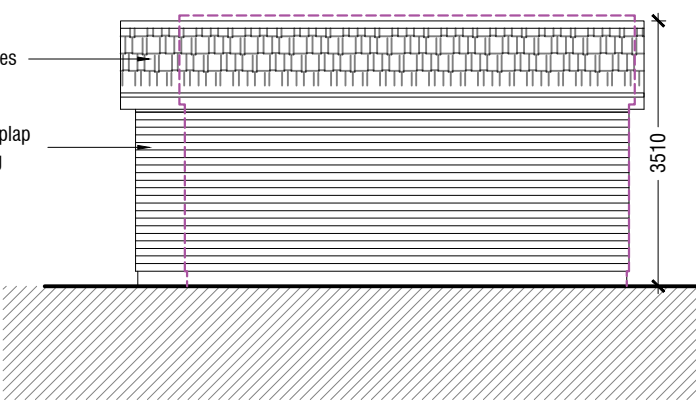


AS BUILT / EXISTING
OUTBUILDING - ELEVATION E3
Scale 1:100

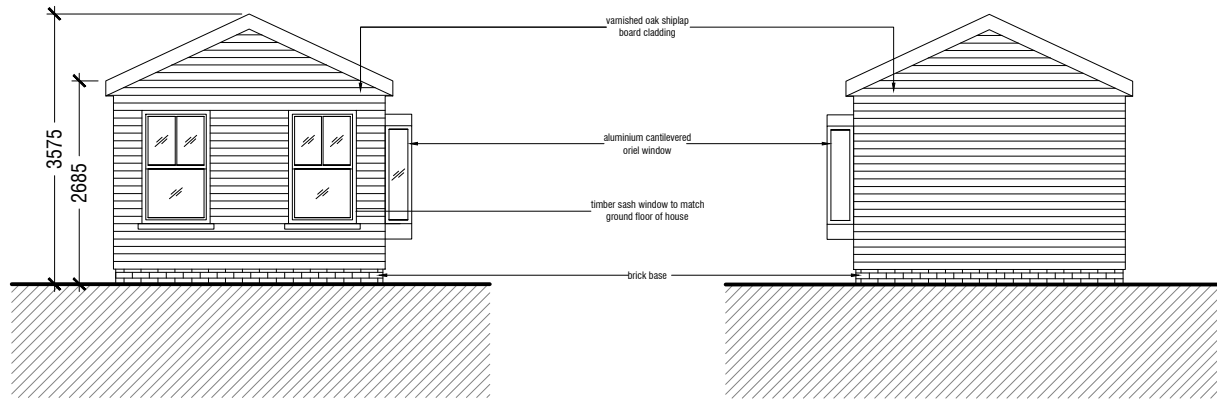


APPROVED APPLICATION 820/APP/2023/82
OUTBUILDING - ELEVATION E2
Scale 1:100

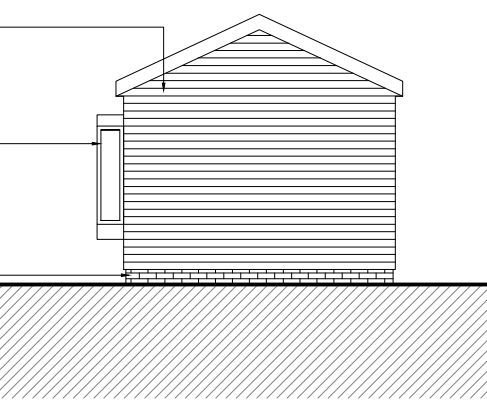

APPROVED APPLICATION 820/APP/2023/82
OUTBUILDING - ELEVATION E4
Scale 1:100

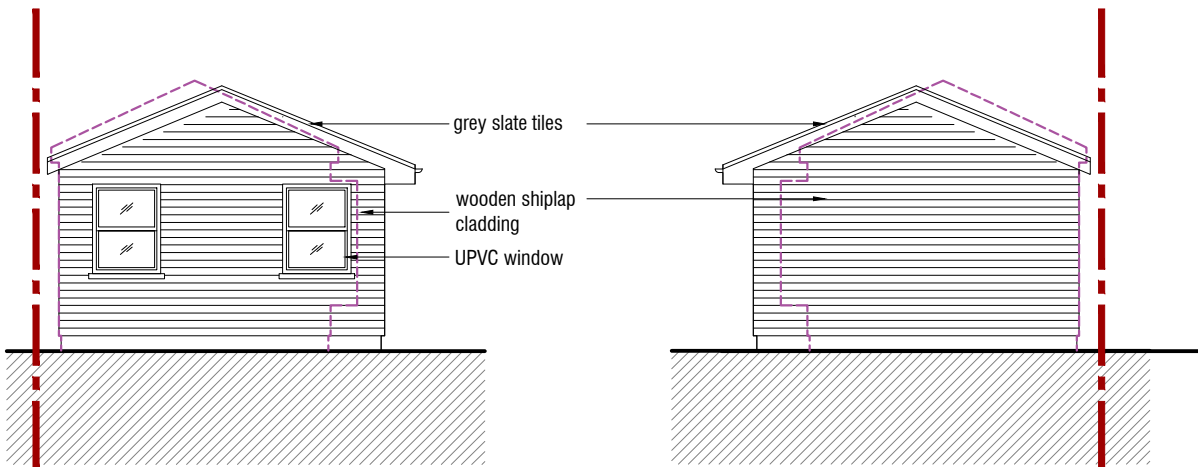

AS BUILT / EXISTING
OUTBUILDING - ELEVATION E2
Scale 1:100

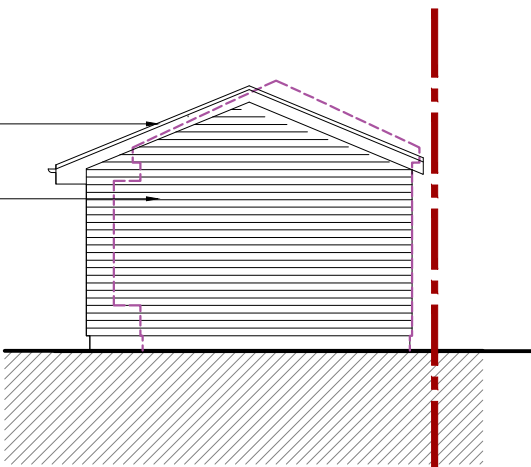

AS BUILT / EXISTING
OUTBUILDING - ELEVATION E4
Scale 1:100

