

NOTES:
Whilst every effort has been made to correctly identify species of trees on the site, we advise that an entomologist be consulted before any final decisions are made.
Grid coordinates are based on Ordnance Survey National Grid

ABBREVIATION KEY – TOPOGRAPHIC SURVEY

AV	Air Valve
BO	Bollard
BIG	Back Inlet
BT	British Telecom
CPS	Concrete Paving Slabs
CL	Cover Level
CATV	Cable Television Cover
DT	Double Yellow Line
DR	Double Red Line
DW	Dashed White Line
ECB	Electric Cable Cabinet
ECP	Electric Cable Pit
EP	Electricity Pole
ER	Earth Road
FAI	Fresh Air Inlet
FH	Fire Hydrant
F/B	Flower Bed
GV	Gas Valve
Gully	Gully
IL=	Invert Level
LC	Lamp Column
LP	Lamp Post
MB	Multi Boll
MK	Service Marker
PM	Parking Meter
RE	Rodding Eye
RS	Road Sign
RWP	Rain Water Pipe
SC	Stop Cock
SW	Single White Line
SY	Single Yellow Line
SV	Stop Valve
SVP	Soil and Vent Pipe
TCB	Telephone Cable Cabinet
TP	Telephone Pole
UTL	Unable To Lift
WC	Weir Gully
WM	Water Meter
WO	Wash Out

ABBREVIATION KEY – BUILDING SURVEY

○	Floor To Ceiling
□	Floor To False Ceiling
AB	Air Brick
DS	Double Socket
DN	Double Socket
Cell HT	Door Head Level
FA	Fire Alarm
FL	Floor Level
FS=	Floor To Sill
FS	Fuse Box
GL	Ground Line
HT=	Height
LS	Light Switch
RWP	Rain Water Pipe
SA	Smoke Alarm
SD	Smoke Detector
SH=	Sill To Head
SS	Single Socket
Stat	Thermostat
SW	Switch
Tel	Telephone/Outlet
TV	Arial/Cable Socket
UA=	Under Arch (centre)
UO=	Under Opening
UD=	Under Beam
UD=	Under Duct
UP=	Under Pipe
WL	Wall Light
Wh=	Window Head Level
Ws=	Window Sill Level

Co-ordinate Table

ID	Easting	Northing	Height

REV. SUFFIX	DATE	INITIAL	REVISION DETAILS

LEVELLING	DATUM
Related To Ordnance Survey Utilising GPS	
CAD OPERATOR	RFRC
APPROVED BY	BED
DATE	01.06.23

Survey and Engineering Services Ltd



CLIENT
Towers Associates

LOCATION
**90 Long Lane
Ickenham
UB10 8SX**

DRAWING TITLE
Existing Elevations

ORIGINAL JOB No. **150523**

DRAWING No. **150523/Elev**

SCALE
1:100 @A1


DATE
1st June 2023

The Company
Lee Farm
Long Lane
Maidenhead
SL6 6PE

Registered Company No 206478


Tel No / Fax: +44 (0) 1628 673 761
e-mail: mail@seesurveyors.co.uk

Land, Architectural and Engineering Surveyors

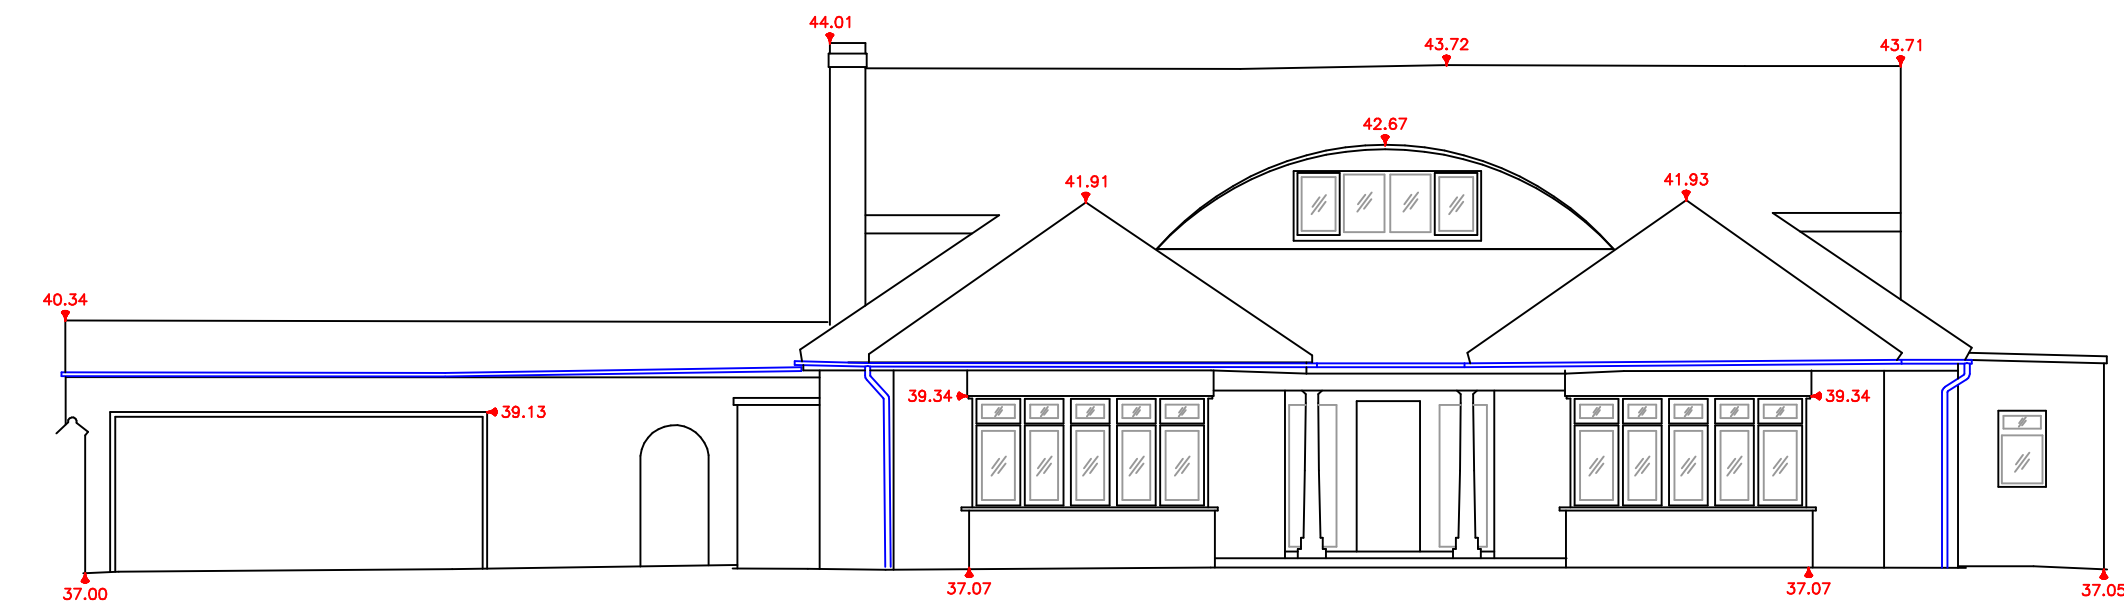


Datum 35.00mts

Front Elevation

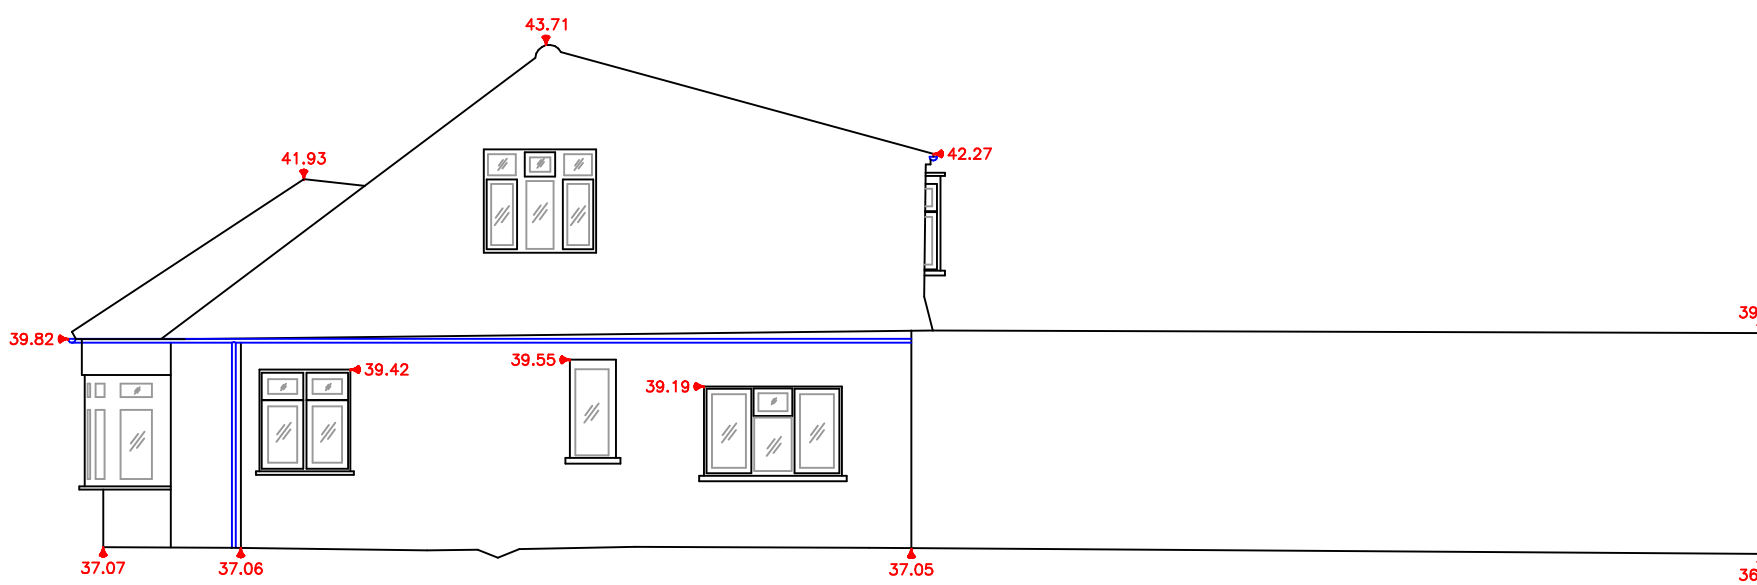


Datum 35.00mts

Right Elevation

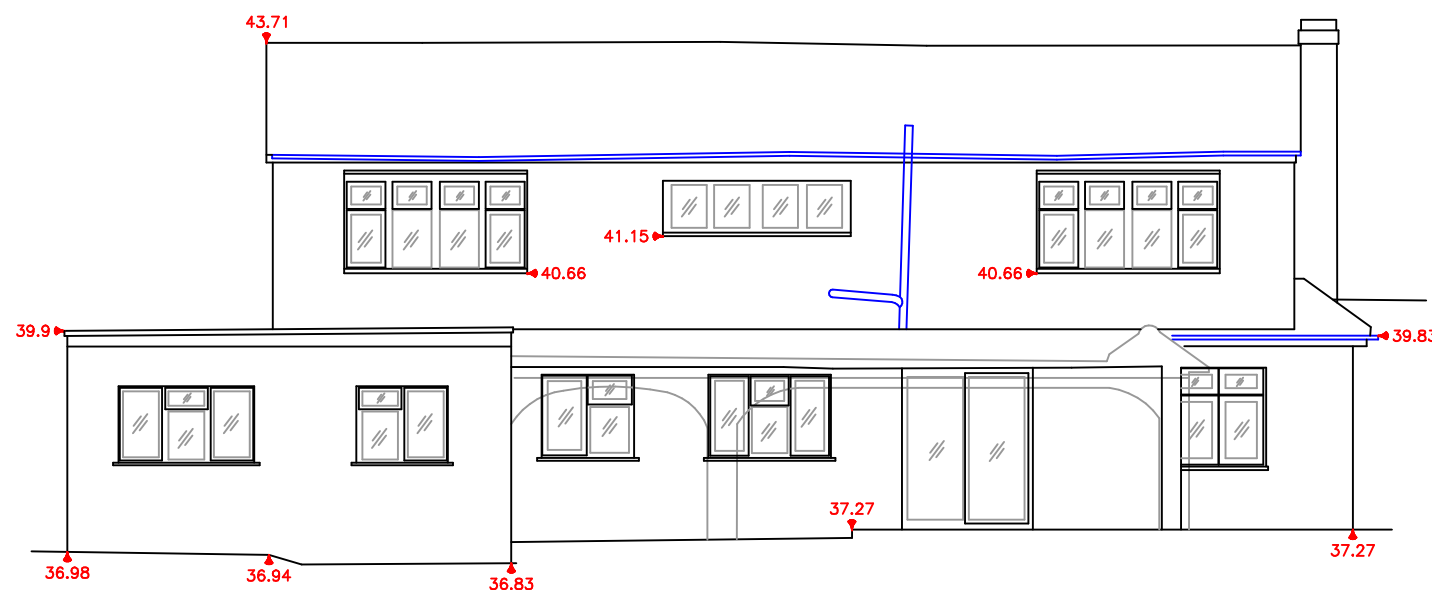

Datum 35.00mts

Rear Elevation

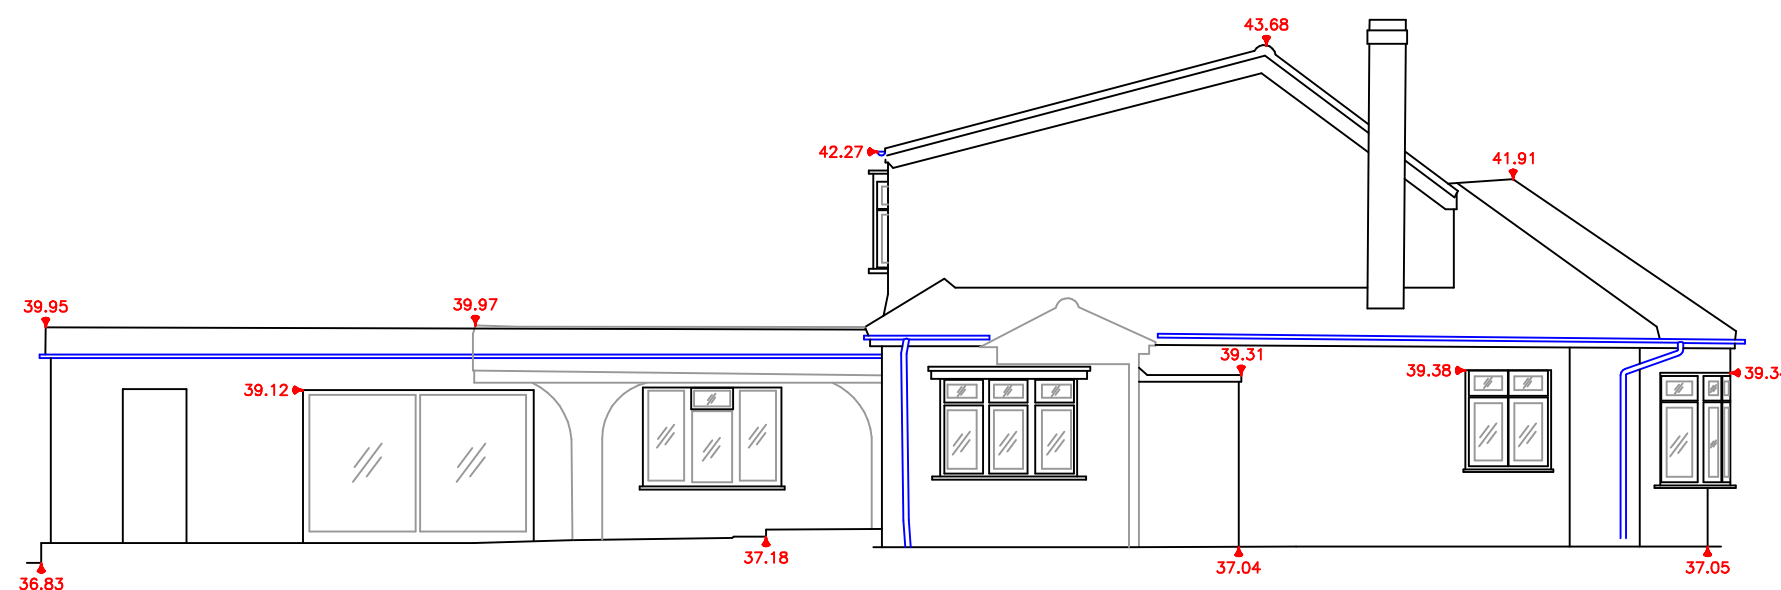

Datum 35.00mts

Left Elevation

