

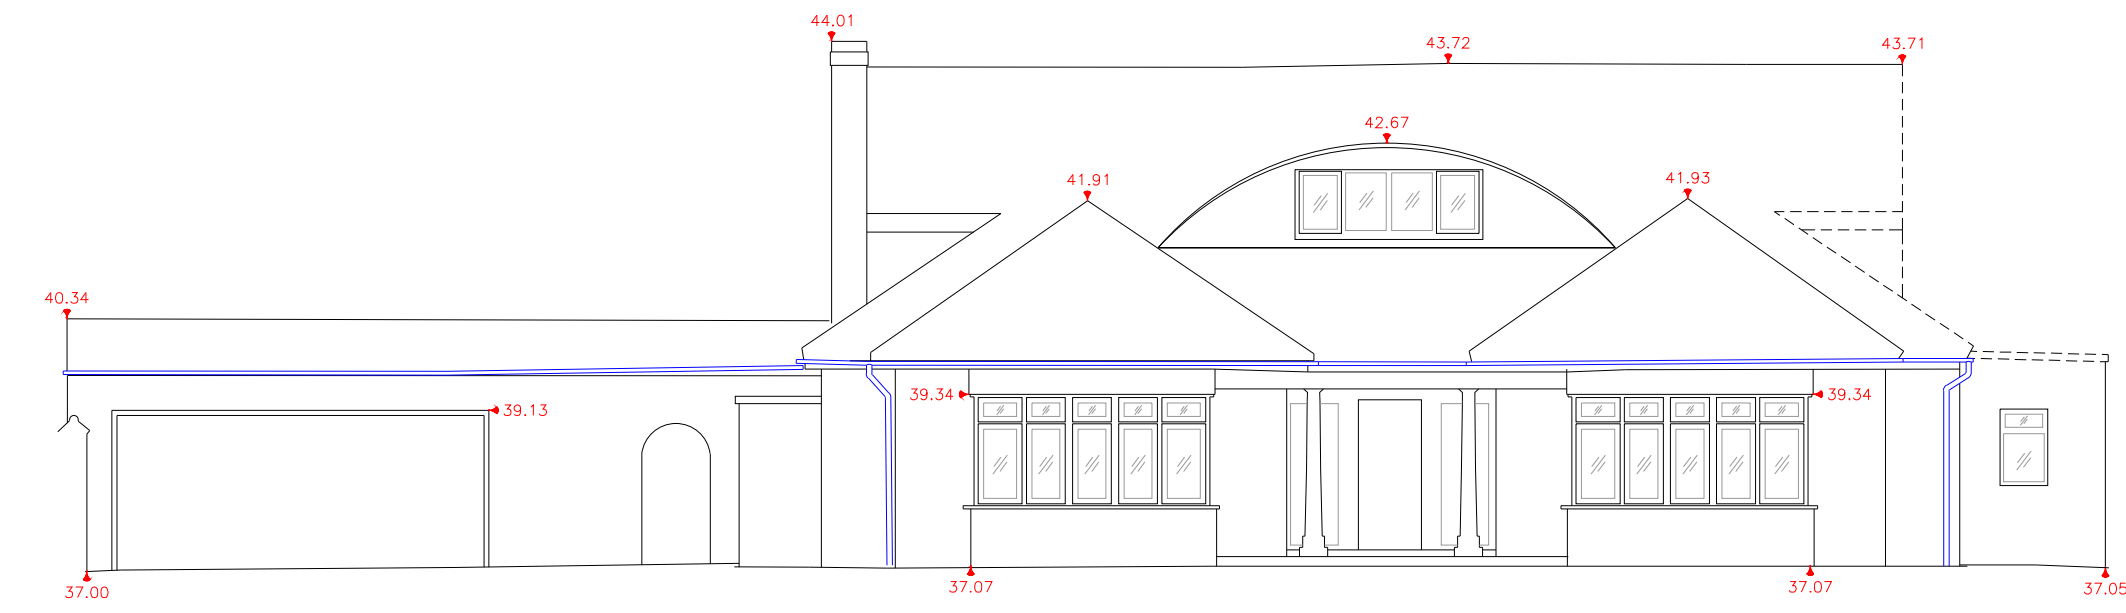


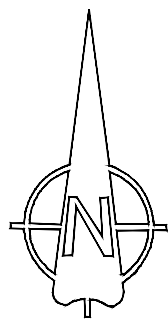


Datum 35.00mts

Front Elevation

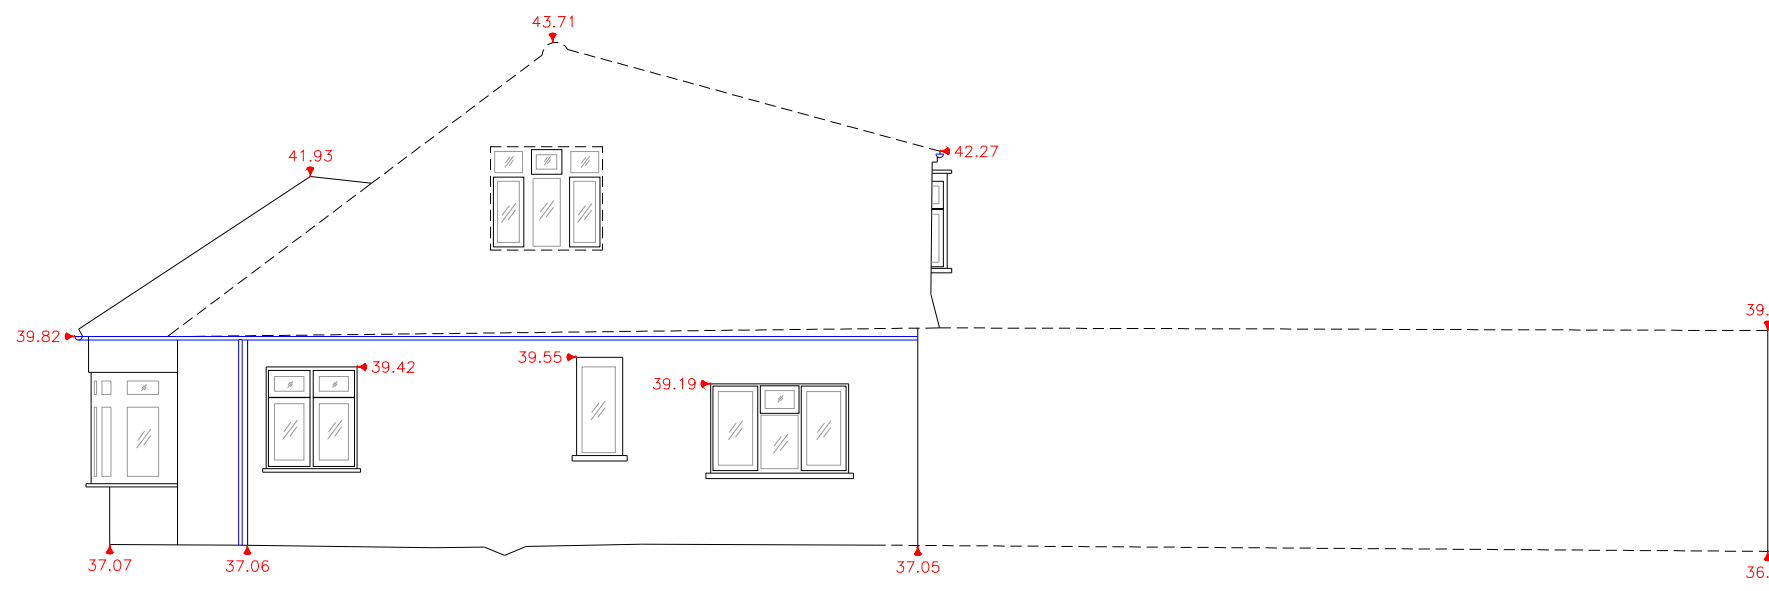


Datum 35.00mts

Right Elevation

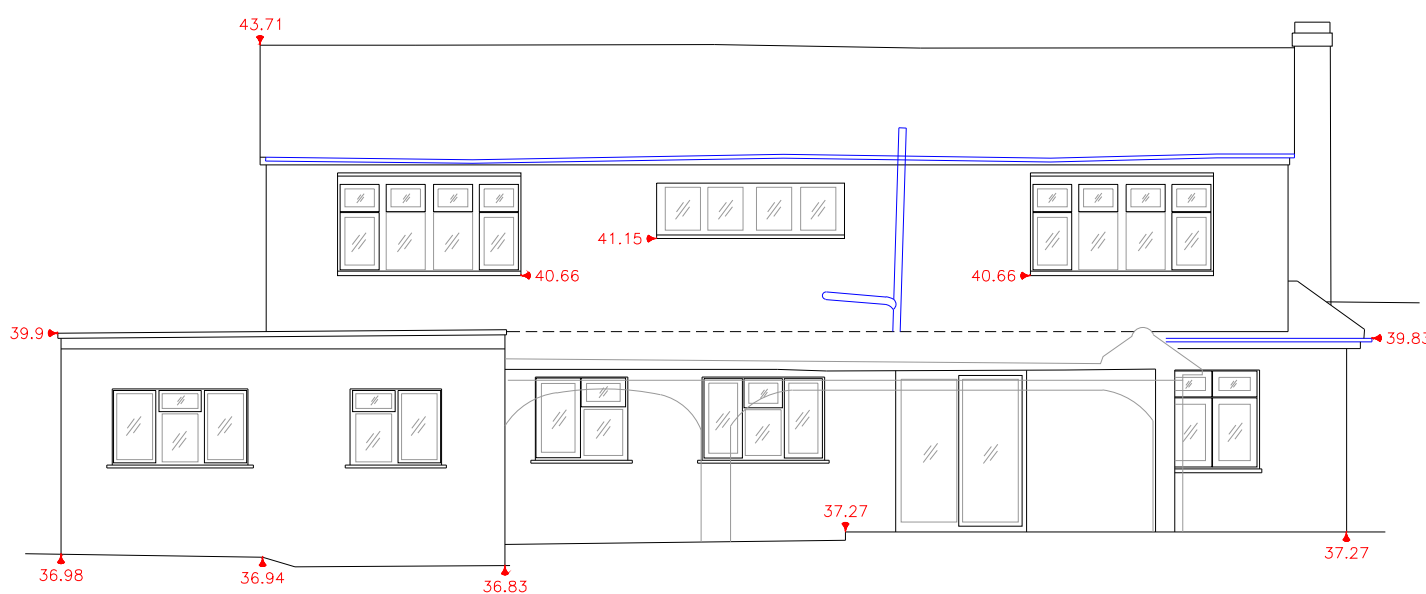

Datum 35.00mts

Rear Elevation

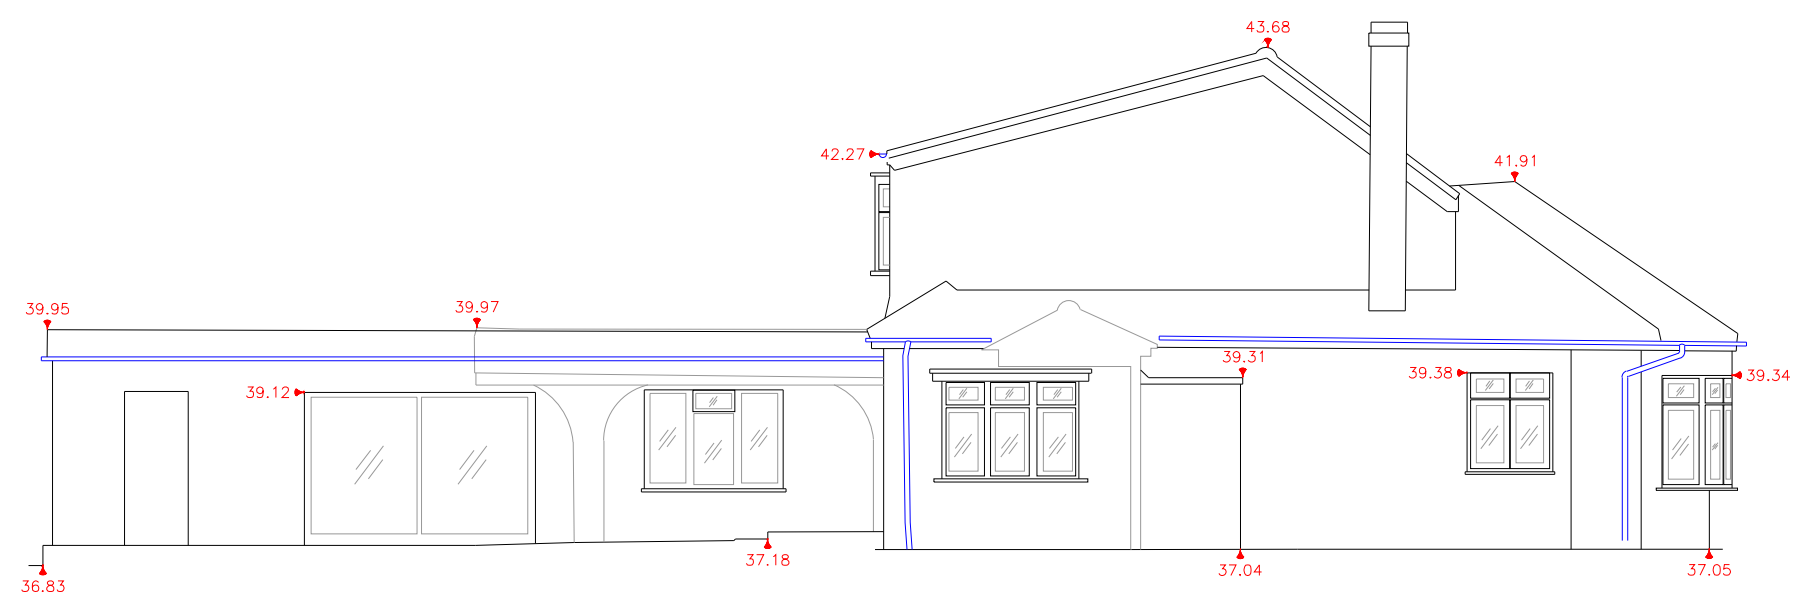

Datum 35.00mts

Left Elevation



NOTES:
Whilst every effort has been made to correctly identify species of trees on the site, we advise that an arboriculturist be consulted before any final decisions are made.
Grid coordinates are based on Ordnance Survey National Grid.

ABBREVIATION KEY – TOPOGRAPHIC SURVEY

AV	Air Valve
BO	Bollard
BIG	Back Inlet Gully
BT	British Telecom
CPS	Concrete Paving Slabs
CL=	Cover Level
CATV	Cable Television Cover
DY	Double Yellow Line
DR	Double Red Line
DW	Dashed White Line
ECB	Electric Cable Cabinet
ECP	Electric Cable Pit
EP	Electricity Pole
ER	Earth Rod
FAI	Fresh Air Inlet
FH	Fire Hydrant
F/B	Flower Bed
GV	Gas Valve
Gy	Gully
IL=	Invert Level
LC	Lamp Column
LP	Lamp Post
MB	Multi Bole
MK	Service Marker
PM	Parking Meter
RE	Road Sign
RS	Road Sign
RWP	Rain Water Pipe
SC	Stop Cock
SW	Single White Line
SY	Single Yellow Line
SV	Stop Valve
SVP	Soil and Vent Pipe
TCB	Telephone Cable Cabinet
TP	Telephone Pole
UTL	Unable To Lift
WG	Weir Gully
NM	Water Meter
WO	Wash Out

ABBREVIATION KEY – BUILDING SURVEY

□	Floor To Ceiling
AB	Floor To False Ceiling
AS	Air Brick
DS	Double Socket
DH	Door Head Level
CL	Ceiling Level
FA	Fire Alarm
FL	Floor Level
FS-	Floor To Sill
FS	Fuse Box
GL	Ground Line
HT=	Height
LS	Light Switch
RWP	Rain Water Pipe
SA	Smoke Alarm
SD	Smoke Detector
SH-	Sill To Head
SS	Single Socket
Stat	Thermostat
SW	Switch
tel	Telephone/Outlet
TV	Arial/Cable Socket
UA=	Under Arch (centre)
UO=	Under Opening
UB=	Under Beam
UD=	Under Duct
UP=	Under Pipe
WL	Wall Light
Wh=	Window Head Level
Ws=	Window Sill Level

Co-ordinate Table

ID	Easting	Northing	Height

REV. SUFFIX	DATE	INITIAL	REVISION DETAILS

LEVELLING: DATUM
Related To Ordnance Survey Utilising GPS

CAD OPERATOR	RFRC	APPROVED BY	BED	DATE	01.06.23
--------------	------	-------------	-----	------	----------

Survey and Engineering Services Ltd



CLIENT

Towers Associates

LOCATION

90 Long Lane
Ickenham
UB10 8SX

DRAWING TITLE

Elevations

ORIGINAL JOB No.

JOB No. 150523

DRAWING No. 150523/Elev

REVISION SUFFIX

SCALE 1:100 @A1

DATE 1st June 2023

The Grintry
Lee Farm
Lee Lane
Princes Risborough
SLA 6PP

Registered Company No: 5366478

Tel No / Fax: +44 (0) 1295 675 781
e-mail: sales@seeservices.co.uk