


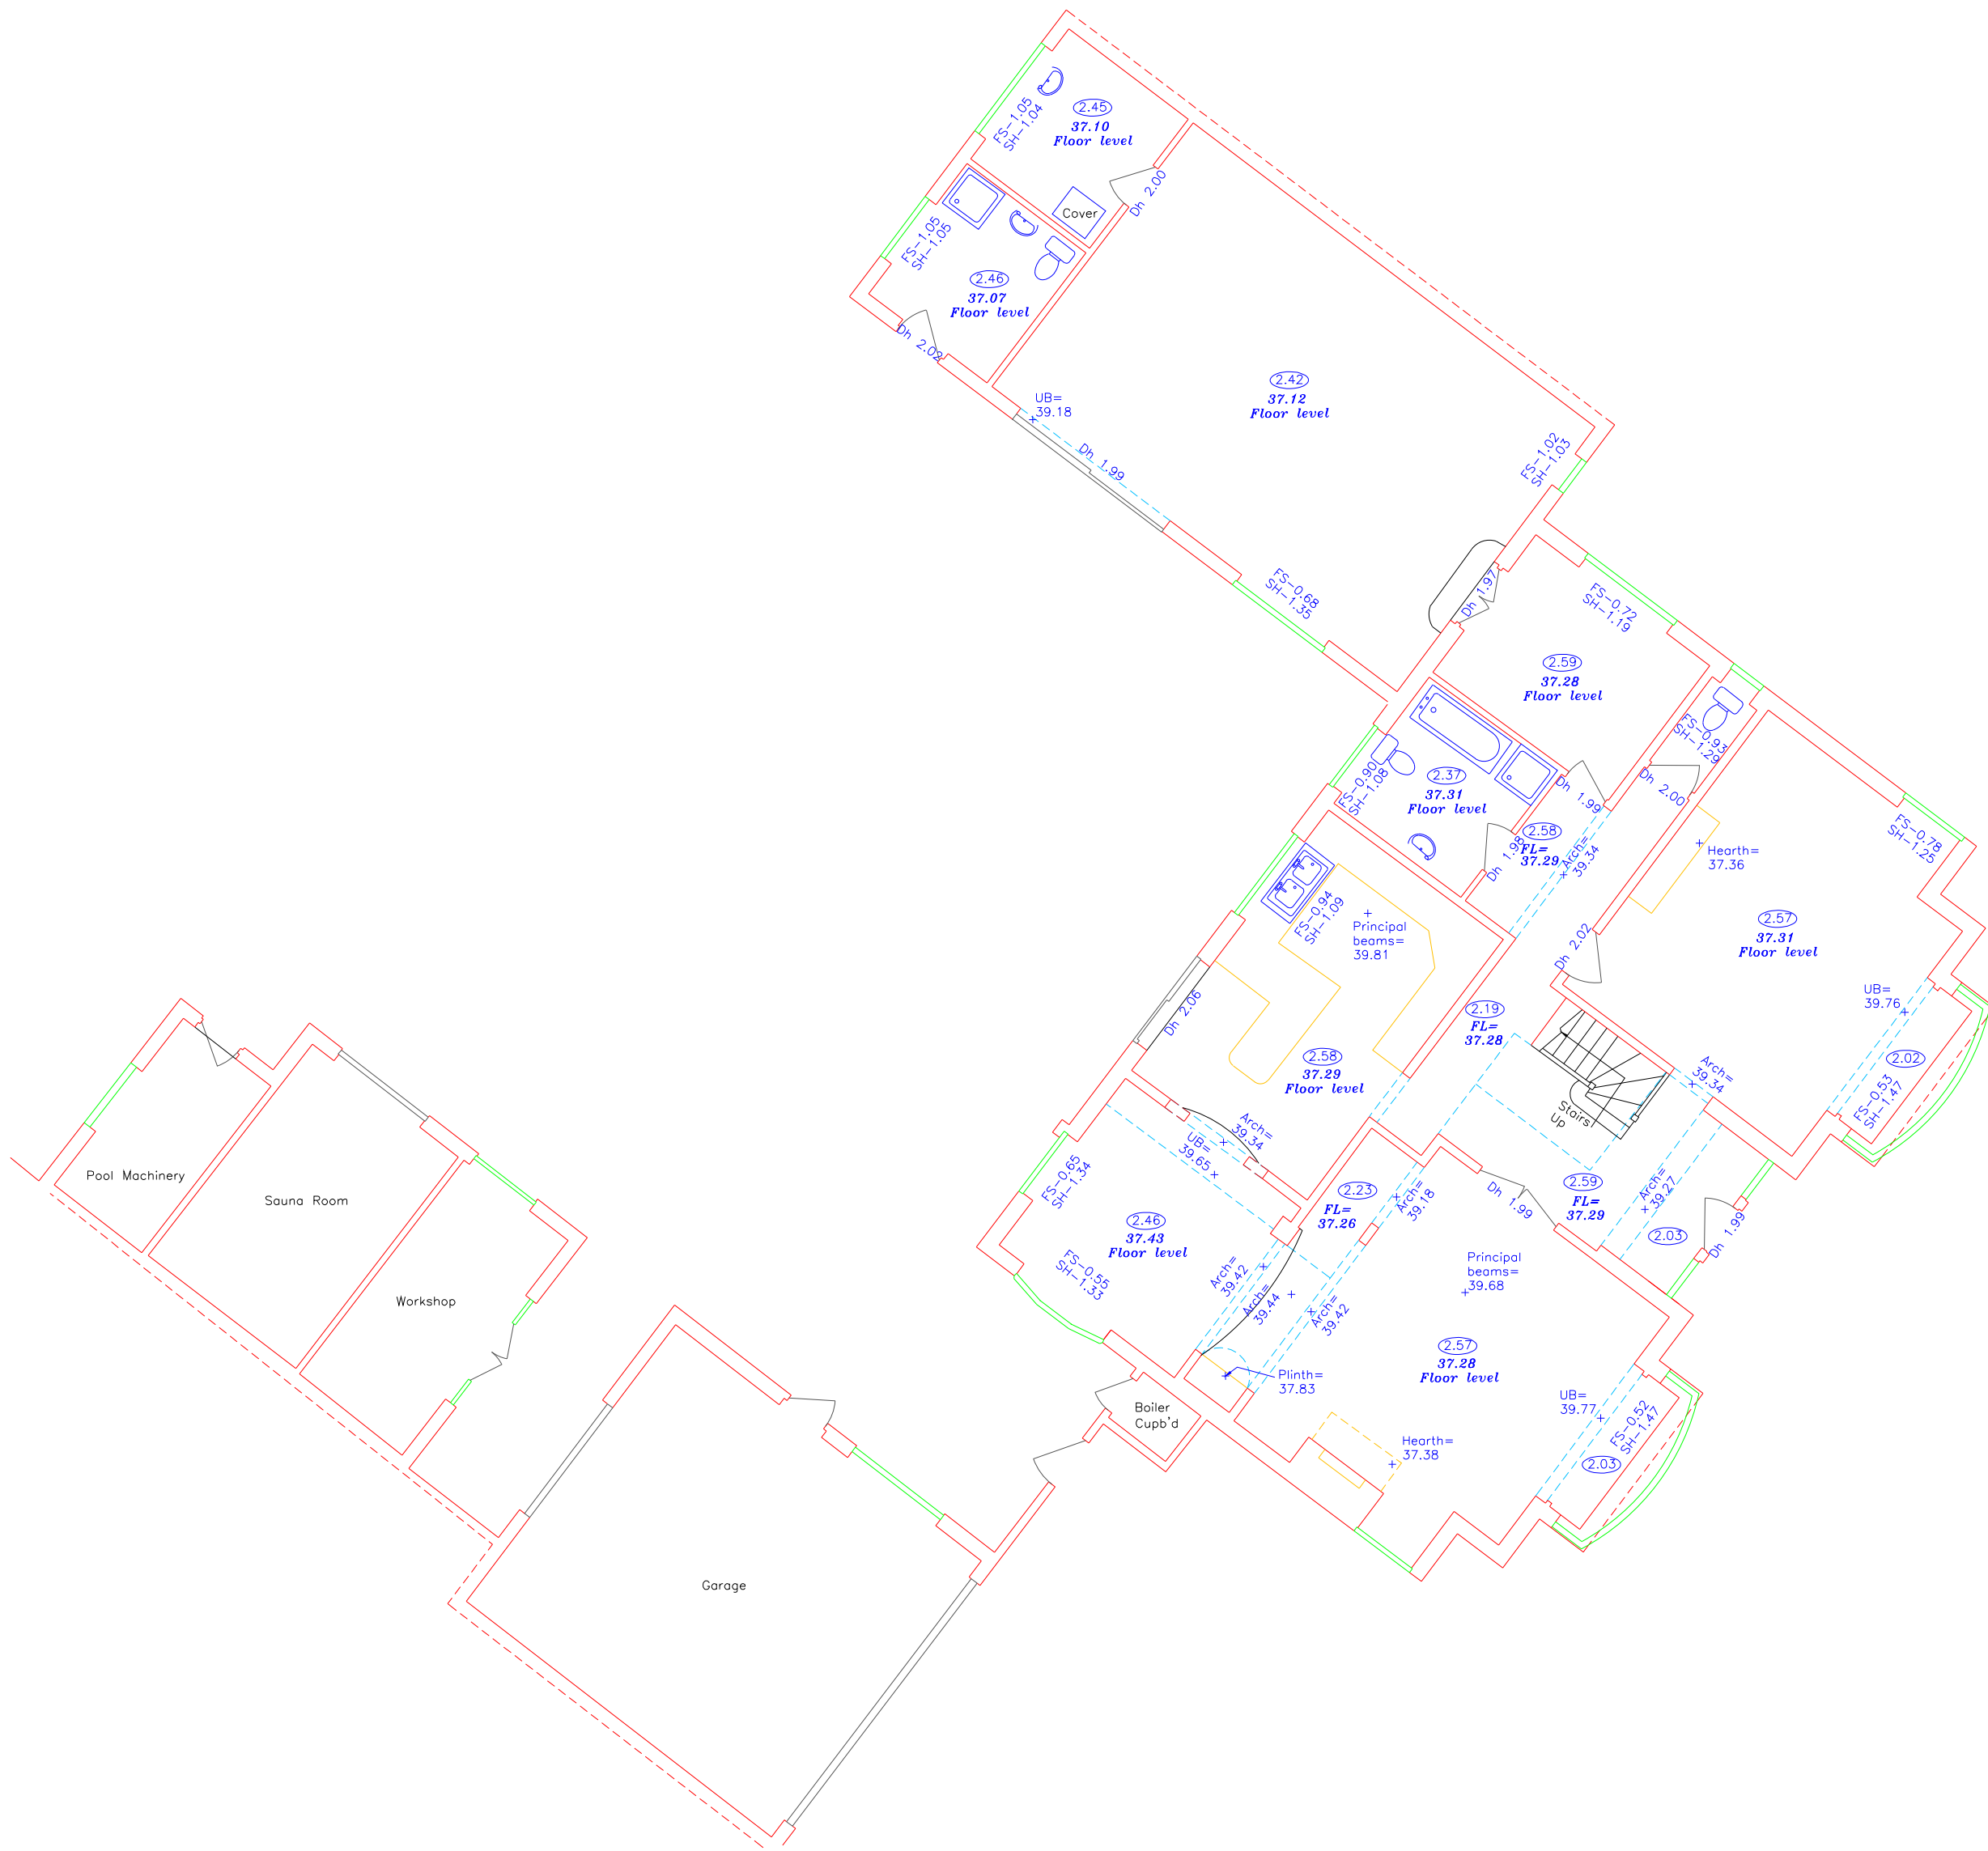

NOTES:

Whilst every effort has been made to correctly identify species of trees on the site, we advise that an arborologist be consulted before any final decisions are made.

Grid coordinates are based on Ordnance Survey National Grid

AV	Air Valve
BO	Boiler
BP	Back Inlet Gully
BT	British Telecom
CP	Cover Paving Slabs
CL	Cover Level
CT	Cable Television Cover
CA/V	Double Yellow Line
DR	Double Red Line
DW	Dried White Line
ECB	Electric Cable Cabinet
ECP	Electric Cable Pit
EP	Electricity Pole
ER	Earth Road
FI	Fire Inlet
FR	Fire Hydrant
F/B	Flower Bed
GV	Gas Valve
GL	Gully
IL	Invert Level
LC	Lamp Column
LP	Lamp Post
MB	Multi Bole
MK	Service Marker
PM	Parking Meter
RE	Rodding Eye
RS	Road Sign
RWP	Rain Water Pipe
SC	Stop Cack
SW	Single White Line
SY	Single Yellow Line
SV	Stop Valve
SVP	Soil and Vent Pipe
TCL	Telephone Cable Cabinet
TP	Traffic Pole
UB	Unable To Lift
WG	Weir Gully
WM	Water Meter
WO	Wash Out

AO	Floor To Ceiling
AB	Floor To False Ceiling
AD	Brick
DBS	Double Socket
th	Door Head Level
Cell HF	Ceiling Level
FA	Fire Alarm
FL	Floor Level
FS	Floor To Sill
FL	Fuse Box
GL	Ground Line
ht	Height
LS	Light Switch
RWP	Rain Water Pipe
SA	Smoke Alarm
SD	Smoke Detector
SH	Sill To Head
SS	Singlet Socket
ST	Thermostat
SW	Switch
Te	Telephone/Outlet
AV	Audio/Cable Socket
UA	Under Arch (centre)
UB	Under Opening
UB=	Under Beam
UD	Under duct
UP=	Under Pipe
WL	Wall Light
Wn	Window Head Level
Ws=	Window Sill Level

ID	Easting	Northing	Height

REV. SUFFIX	DATE	INITIAL	REVISION DETAILS

Related To Ordnance Survey Utilising GPS

CAD OPERATOR	RFRC	APPROVED BY	BED	DATE	01.06
-----------------	------	----------------	-----	------	-------

Survey and Engineering Services Ltd 

CLIENT	
--------	--

Towers Associates

LOCATION
*90 Long Lane
Ickenham
UB10 8SX*

DRAWING TITLE

Ground Floor

ORIGINAL JOB No.	JOB No. <i>150523</i>
---------------------	--------------------------

DRAWING No.	REVISION SUFFIX
150523/Grd	

SCALE	DATE
1:100 @A1	1st June 2023

Land
The Granary
Lee Farm
Lee Lane
Pinkneys Green
Maidenhead
SL6 6PE

Registered Company No: 5366478

Tel No / Fax: +44 (0) 1628 611111
e-mail: mail@sw-surveys.co.uk