



AS BUILT REAR ELEVATION

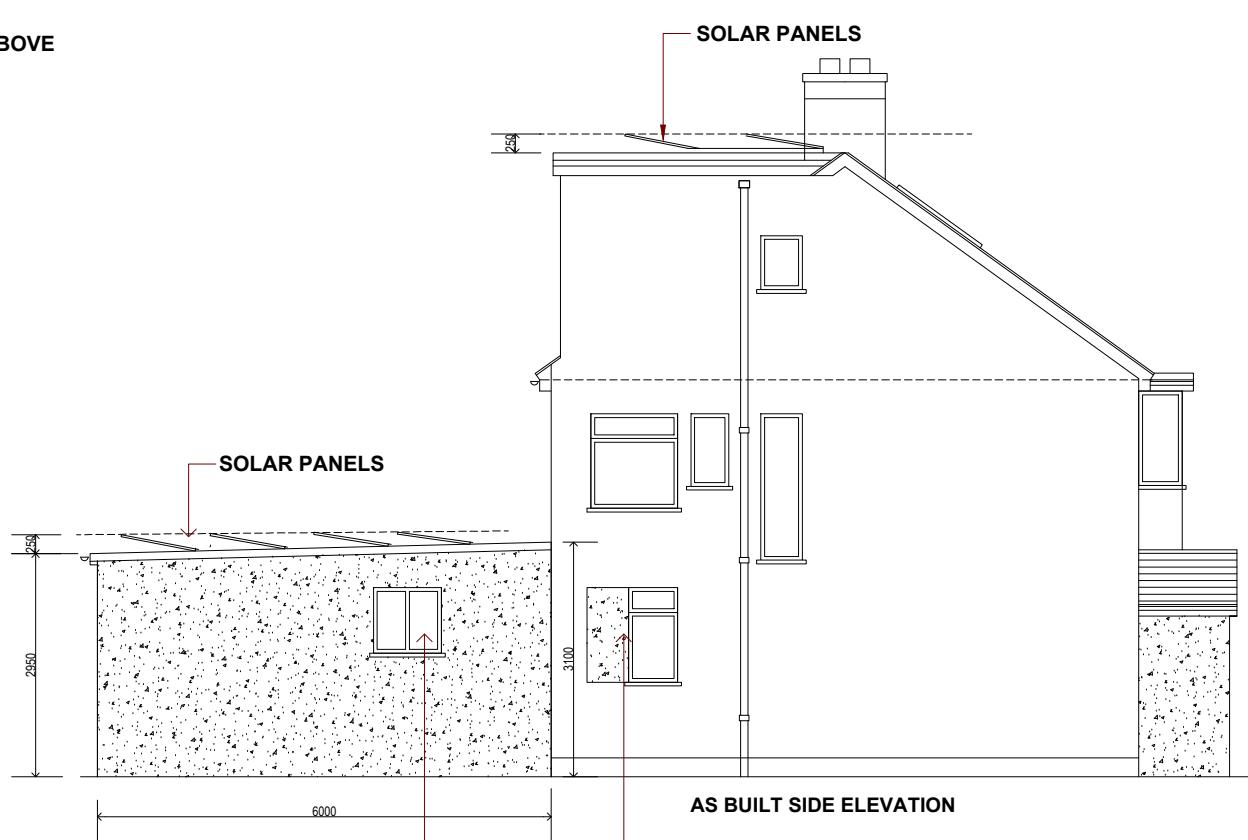


AS BUILT SIDE ELEVATION

WINDOW SIZE REDUCED AND TO
BE MADE OBSCURED

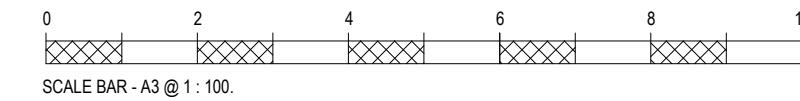

AS BUILT FRONT ELEVATION

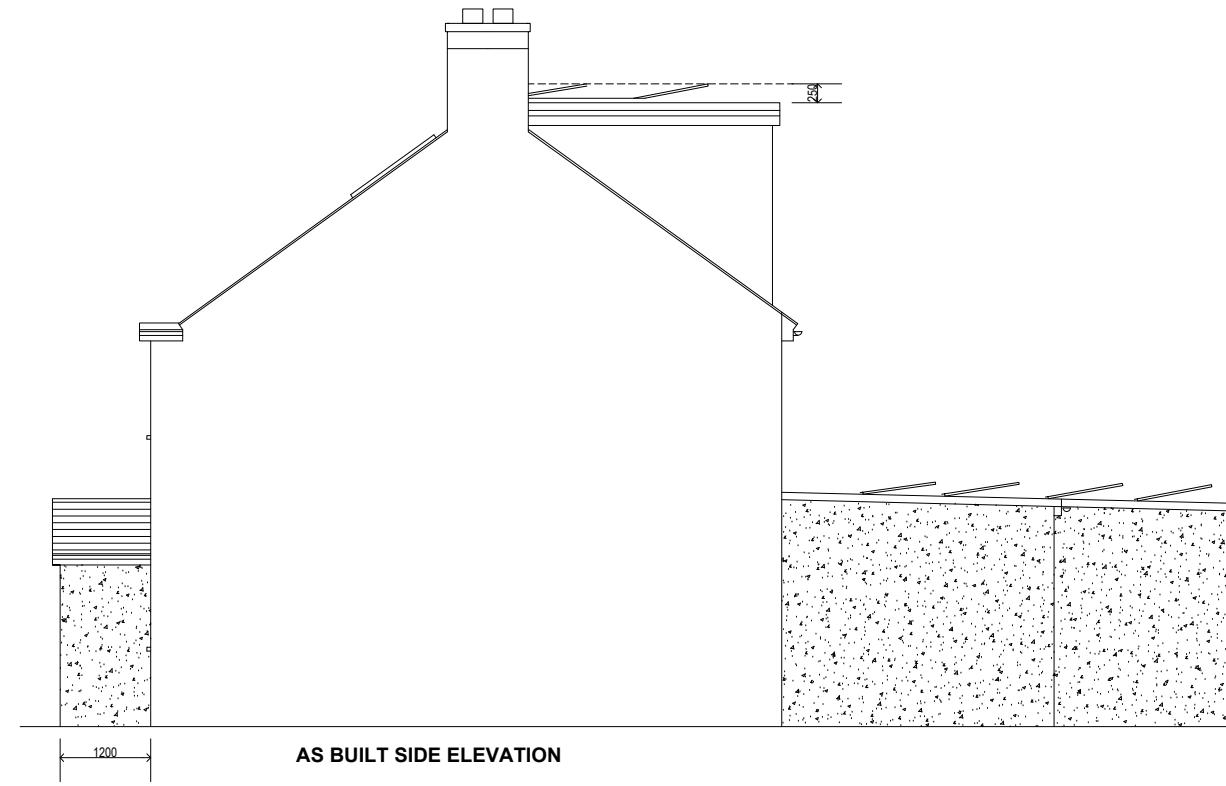

AS BUILT SIDE ELEVATION

JOB TITLE	
236 WOODLANDS AVENUE EASTCOTE HA4 9QY	
DRAWING TITLE	
AS BUILT ELEVATIONS	DRAWN
DATE JULY 2022	SCALE 1: 100.
DRAWING No.	Size A3
P	06