



AS BUILT FIRST FLOOR PLAN

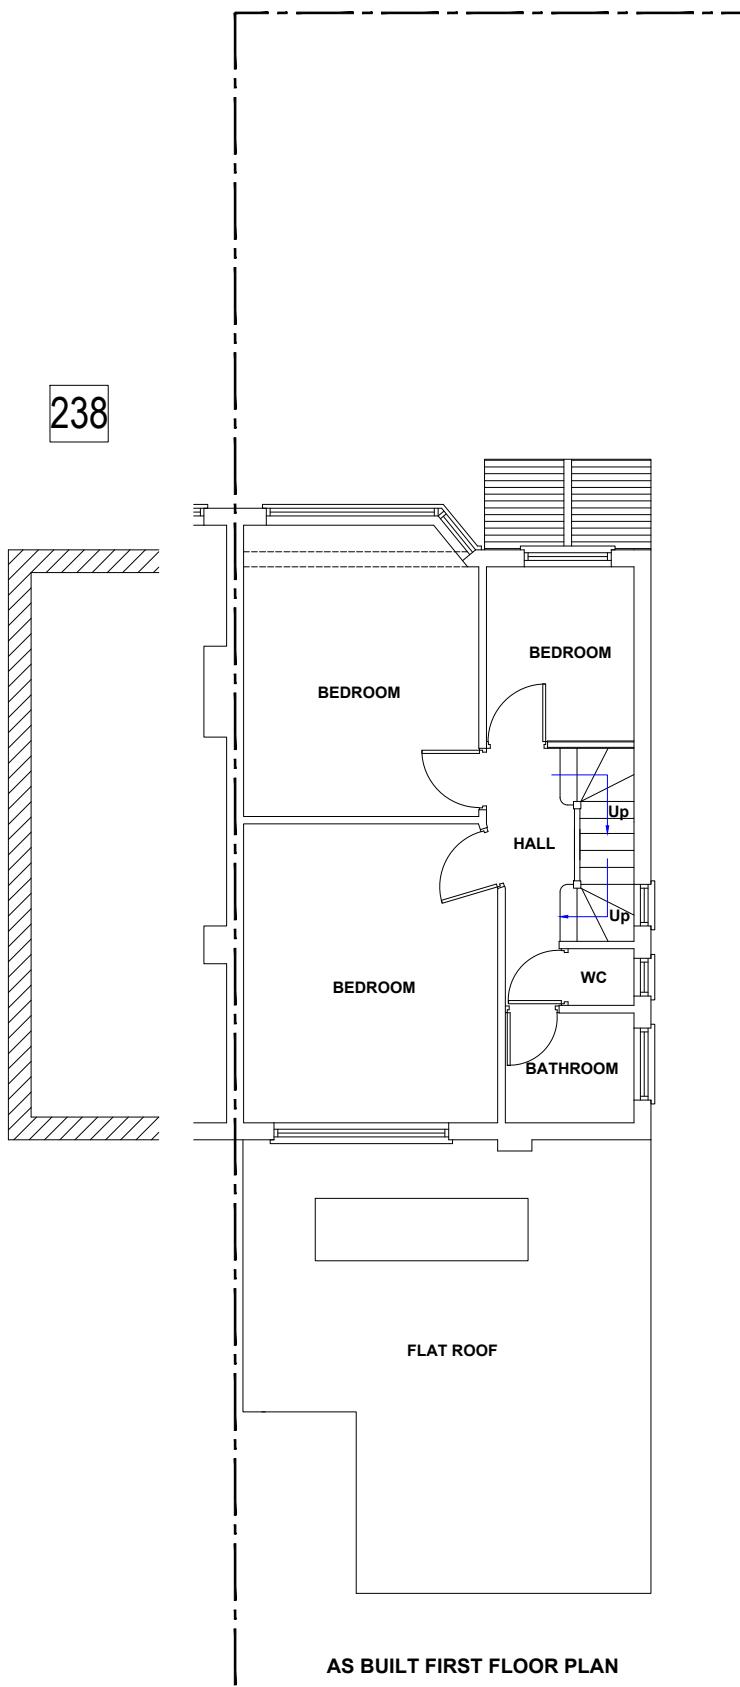

AS BUILT SECOND FLOOR PLAN

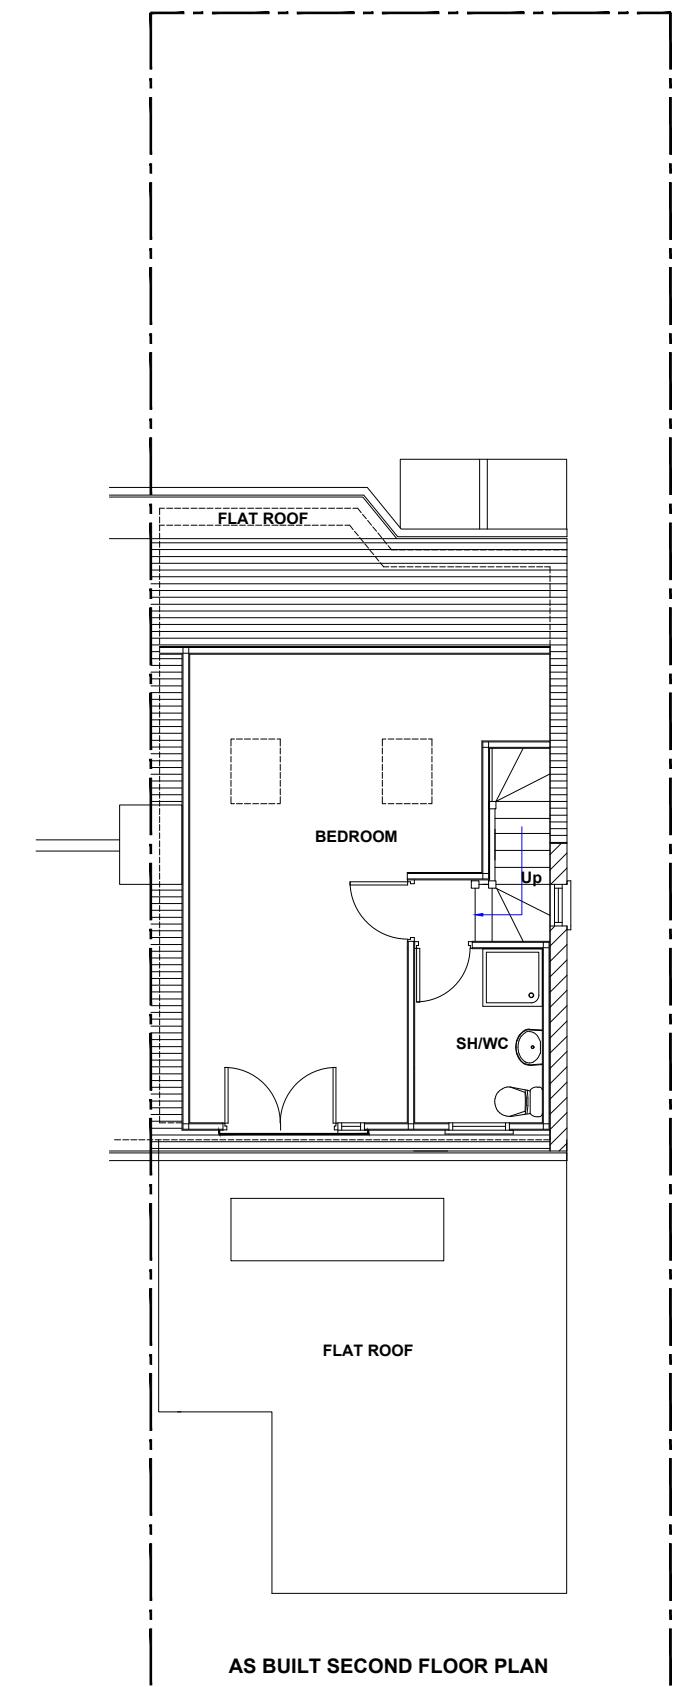

AS BUILT PROPOSED ROOF PLAN

JOB TITLE		
236 WOODLANDS AVENUE		
EASTCOTE		
HA4 9QY		
DRAWING TITLE		
AS BUILT FLOOR PLANS		
		DRAWN
DATE		SCALE
JULY 2022		1: 100.
Size		A3
DRAWING No.		P
		05