


Appendix A

RETROSPECTIVE APPLICATION

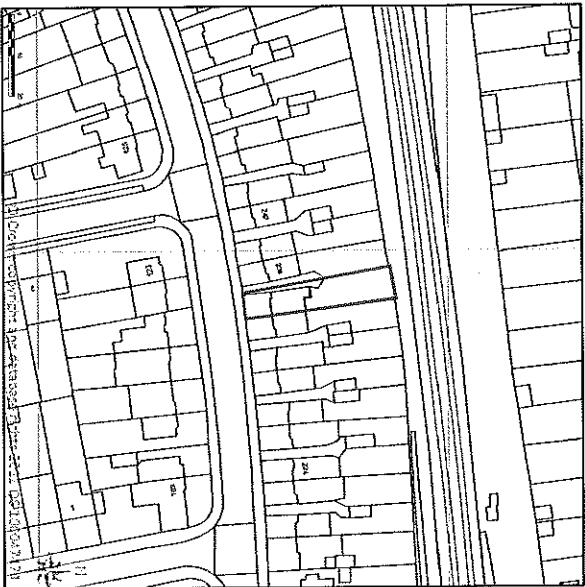


236 WOODLANDS AVENUE EASTCOTE HA4 9QY
SITE LOCATION PLAN
AREA 2 HA
SCALE 1:1250 on A4
CENTRE COORDINATES: 511511, 187662



Supplied by Streetwise Maps Ltd
www.streetwise.net
Licence No: 100047474
10/08/2021 15:45

LOCATION PLAN
SCALE - 1:1250.

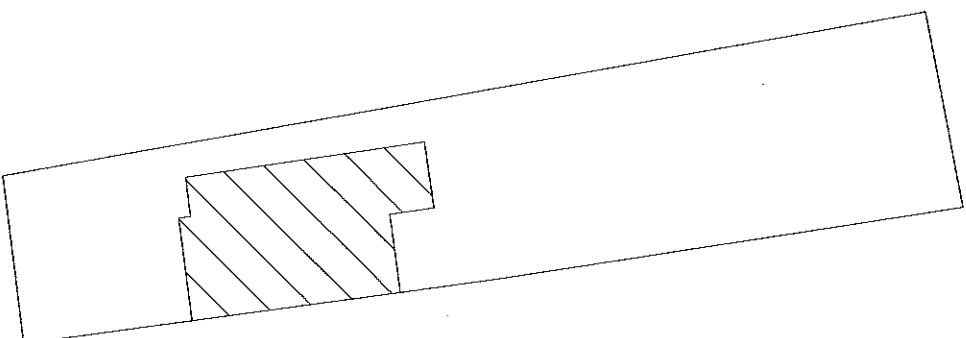

SITE PLAN
SCALE - 1:200.

JOB TITLE			
236 WOODLANDS AVENUE EASTCOTE HA4 9QY			
DRAWING TITLE			
LOCATION PLAN & SITE PLAN			
DATE		SCALE	
JULY 2022		1:1250 / 1:200 / A3	
DRAWING No.		P	01

Appendix B

HILLINGDON
LONDON

London Borough of Hillingdon, Residents Services, 3N Civic Centre, High Street, Uxbridge, Middlesex UB8 1UW
Tel: 01895 250230 Web: www.hillingdon.gov.uk

Householder Application for Planning Permission for works or extension to a dwelling

Town and Country Planning Act 1990 (as amended)

Publication of applications on planning authority websites

Please note that the information provided on this application form and in supporting documents may be published on the Authority's website. If you require any further clarification, please contact the Authority's planning department.

Site Location

Disclaimer: We can only make recommendations based on the answers given in the questions.

If you cannot provide a postcode, the description of site location must be completed. Please provide the most accurate site description you can, to help locate the site - for example "field to the North of the Post Office".

Number

236

Suffix

Property Name

Address Line 1

Woodlands Avenue

Address Line 2

Address Line 3

Hillingdon

Town/city

Ruislip

Postcode

HA4 9QY

Description of site location must be completed if postcode is not known:

Easting (x)

511511

Northing (y)

187662

Description

Applicant Details

Name/Company

Title

Mr

First name

Srujan

Surname

Yakkati

Company Name

Address

Address line 1

236

Address line 2

Woodlands Avenue

Address line 3

Hillingdon

Town/City

Ruislip

Country

Postcode

HA4 9QY

Are you an agent acting on behalf of the applicant?

☒ Yes

☐ No

Contact Details

Primary number

***** REDACTED *****

Secondary number

Fax number

Email address

Agent Details

Name/Company

Title

First name

Surname

Company Name

Address

Address line 1

Address line 2

Address line 3

Town/City

Country

Postcode

Contact Details

Primary number

Secondary number

Fax number

Email address

Description of Proposed Works

Please describe the proposed works

Has the work already been started without consent?

☒ Yes

☐ No

If Yes, please state when the development or work was started (date must be pre-application submission)

Has the work already been completed without consent?

☐ Yes

☒ No

Site information

Please note: This question is specific to applications within the Greater London area.

The Mayor can request relevant information about spatial planning in Greater London under [Section 346 of the Greater London Authority Act 1999](#).

[View more information on the collection of this additional data and assistance with providing an accurate response.](#)

Title number(s)

Please add the title number(s) for the existing building(s) on the site. If the site has no title numbers, please enter "Unregistered"

Energy Performance Certificate

Do any of the buildings on the application site have an Energy Performance Certificate (EPC)?

☐ Yes

☒ No

Further information about the Proposed Development

Please note: This question is specific to applications within the Greater London area.

The Mayor can request relevant information about spatial planning in Greater London under [Section 346 of the Greater London Authority Act 1999](#).

[View more information on the collection of this additional data and assistance with providing an accurate response.](#)

What is the Gross Internal Area to be added to the development?

44.00

square metres

Number of additional bedrooms proposed

1

Number of additional bathrooms proposed

1

Development Dates

Please note: This question is specific to applications within the Greater London area.

The Mayor can request relevant information about spatial planning in Greater London under [Section 346 of the Greater London Authority Act 1999](#).

[View more information on the collection of this additional data and assistance with providing an accurate response.](#)

When are the building works expected to commence?

08/2021



When are the building works expected to be complete?

09/2022



Materials

Does the proposed development require any materials to be used externally?

☒ Yes

☐ No

Please provide a description of existing and proposed materials and finishes to be used externally (including type, colour and name for each material)

Type: Walls Existing materials and finishes: Pebbledash Proposed materials and finishes: Pebbledash
Type: Roof Existing materials and finishes: Tiled Proposed materials and finishes: Flat
Type: Windows Existing materials and finishes: UPVC Proposed materials and finishes: UPVC
Type: Doors Existing materials and finishes: UPVC Proposed materials and finishes: UPVC

Are you supplying additional information on submitted plans, drawings or a design and access statement?

- ☒ Yes
☐ No

If Yes, please state references for the plans, drawings and/or design and access statement

Pre-existing, approved and as built floor plans and elevations and location plan

Trees and Hedges

Are there any trees or hedges on the property or on adjoining properties which are within falling distance of the proposed development?

- ☐ Yes
☒ No

Will any trees or hedges need to be removed or pruned in order to carry out your proposal?

- ☐ Yes
☒ No

Pedestrian and Vehicle Access, Roads and Rights of Way

Is a new or altered vehicle access proposed to or from the public highway?

- ☐ Yes
☒ No

Is a new or altered pedestrian access proposed to or from the public highway?

- ☐ Yes
☒ No

Do the proposals require any diversions, extinguishment and/or creation of public rights of way?

- ☐ Yes
☒ No

Vehicle Parking

Please note: This question contains additional requirements specific to applications within Greater London.

The Mayor can request relevant information about spatial planning in Greater London under [Section 346 of the Greater London Authority Act 1999](#).

[View more information on the collection of this additional data and assistance with providing an accurate response.](#)

Does the site have any existing vehicle/cycle parking spaces or will the proposed development add/remove any parking spaces?

- ☐ Yes
☒ No

Site Visit

Can the site be seen from a public road, public footpath, bridleway or other public land?

- ☐ Yes
☒ No

If the planning authority needs to make an appointment to carry out a site visit, whom should they contact?

- ☐ The agent
☒ The applicant
☐ Other person

Pre-application Advice

Has assistance or prior advice been sought from the local authority about this application?

- ☒ Yes
☐ No

If Yes, please complete the following information about the advice you were given (this will help the authority to deal with this application more efficiently):

Officer name:

Title

First Name

Surname

***** REDACTED *****

Reference

ENF/294/22

Date (must be pre-application submission)

22/06/2022

Details of the pre-application advice received

Apply for planning permission to retain extension built.

Authority Employee/Member

With respect to the Authority, is the applicant and/or agent one of the following:

- (a) a member of staff
- (b) an elected member
- (c) related to a member of staff
- (d) related to an elected member

It is an important principle of decision-making that the process is open and transparent.

For the purposes of this question, "related to" means related, by birth or otherwise, closely enough that a fair-minded and informed observer, having considered the facts, would conclude that there was bias on the part of the decision-maker in the Local Planning Authority.

Do any of the above statements apply?

- ☐ Yes
☒ No

Ownership Certificates and Agricultural Land Declaration

Certificates under Article 14 - Town and Country Planning (Development Management Procedure) (England) Order 2015 (as amended)

Please answer the following questions to determine which Certificate of Ownership you need to complete: A, B, C or D.

Is the applicant the sole owner of all the land to which this application relates; and has the applicant been the sole owner for more than 21 days?

- ☒ Yes
☐ No

Is any of the land to which the application relates part of an Agricultural Holding?

- ☐ Yes
☒ No

Certificate Of Ownership - Certificate A

I certify/The applicant certifies that on the day 21 days before the date of this application nobody except myself/ the applicant was the owner* of any part of the land or building to which the application relates, and that none of the land to which the application relates is, or is part of, an agricultural holding**

* "owner" is a person with a freehold interest or leasehold interest with at least 7 years left to run.

** "agricultural holding" has the meaning given by reference to the definition of "agricultural tenant" in section 65(8) of the Act.

NOTE: You should sign Certificate B, C or D, as appropriate, if you are the sole owner of the land or building to which the application relates but the land is, or is part of, an agricultural holding.

Person Role

- ☐ The Applicant
☒ The Agent

Title

Mr

First Name

Joga

Surname

Jutley

Declaration Date

12/07/2022

☒ Declaration made

Declaration

I / We hereby apply for Householder planning permission as described in this form and accompanying plans/drawings and additional information. I / We confirm that, to the best of my/our knowledge, any facts stated are true and accurate and any opinions given are the genuine options of the persons giving them. I / We also accept that: Once submitted, this information will be transmitted to the Local Planning Authority and, once validated by them, be made available as part of a public register and on the authority's website; our system will automatically generate and send you emails in regard to the submission of this application.


☒ I / We agree to the outlined declaration

Signed


Joga Jutley

Date

12/07/2022


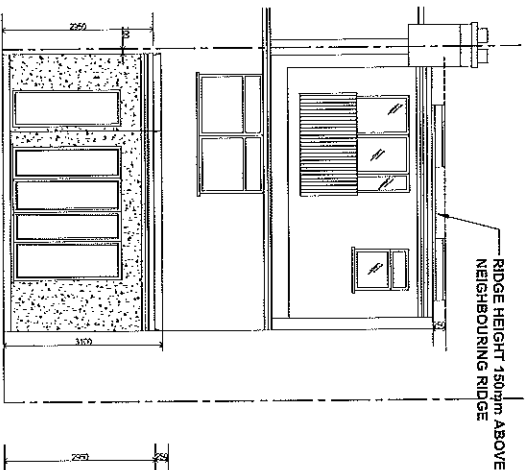


AS BUILT REAR ELEVATION

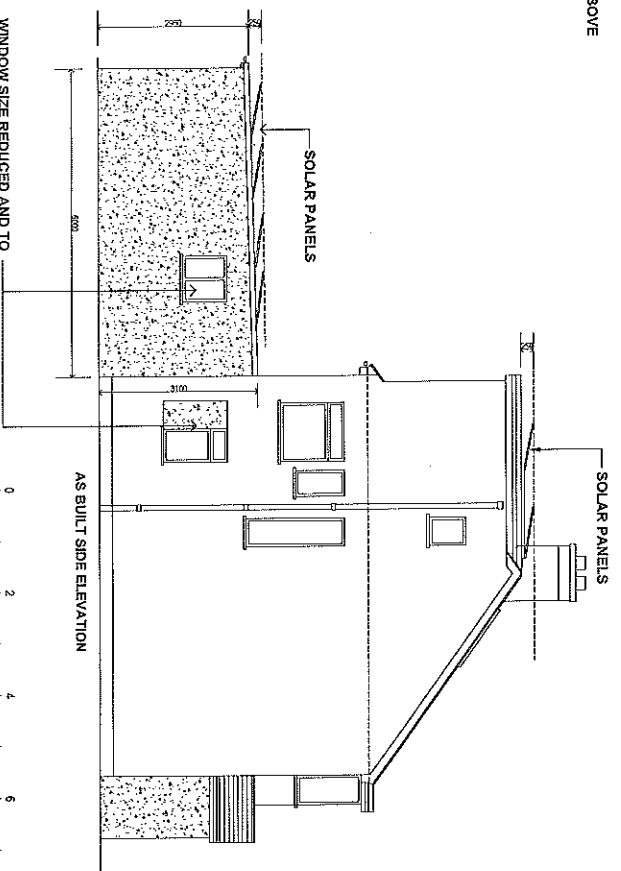


AS BUILT SIDE ELEVATION

WINDOW SIZE REDUCED AND TO
BE MADE OBSCURED

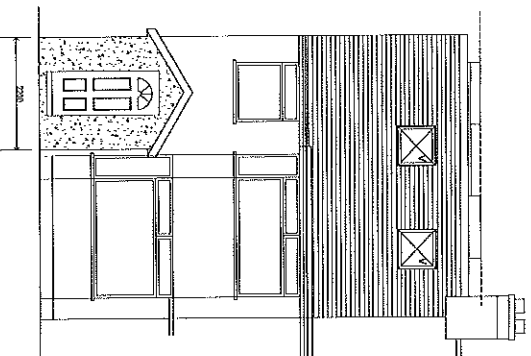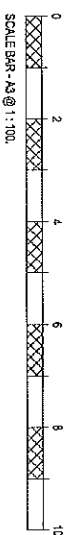

AS BUILT FRONT ELEVATION

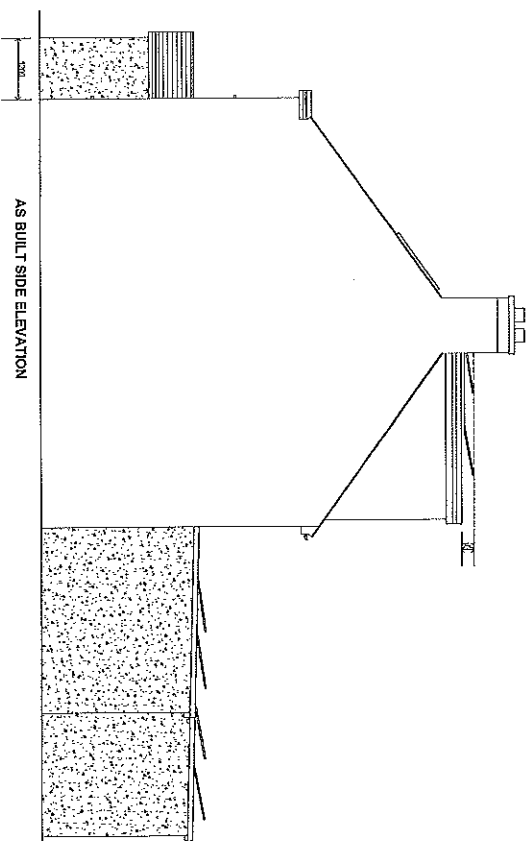





AS BUILT SIDE ELEVATION

JOB TITLE		28 WOODLANDS AVENUE	
EASTOOTE		H44 BOX	
DRAWING TITLE		AS BUILT ELEVATIONS	
DATE	SCALE	DATE	SCALE
JULY 2022	1:100.	JULY 2022	1:100.
DRAWING No.	P	06	



FRONT GARDEN

236

238

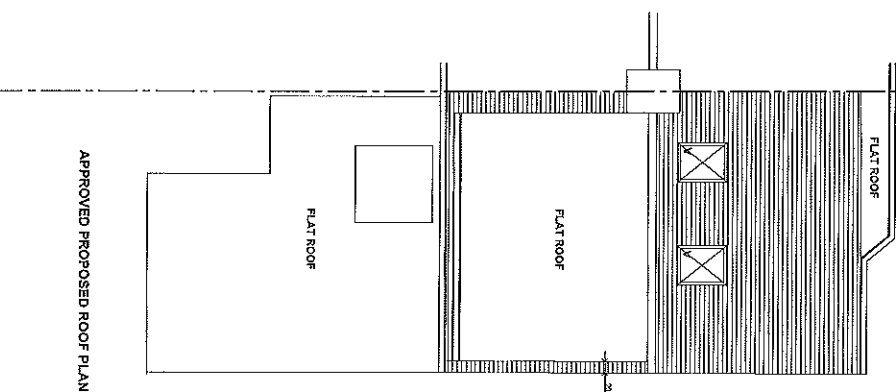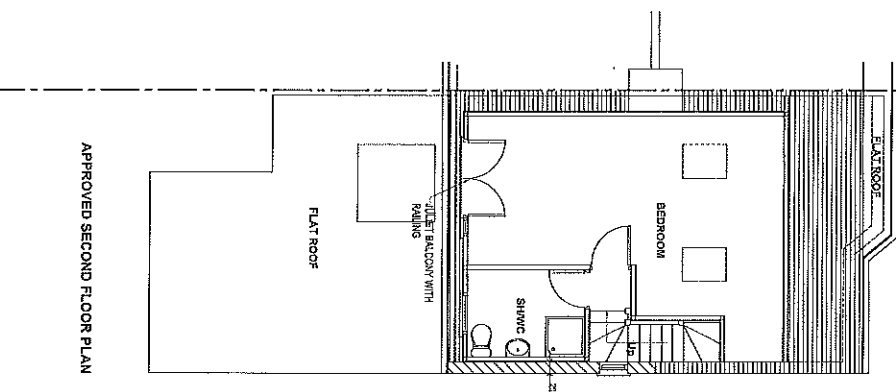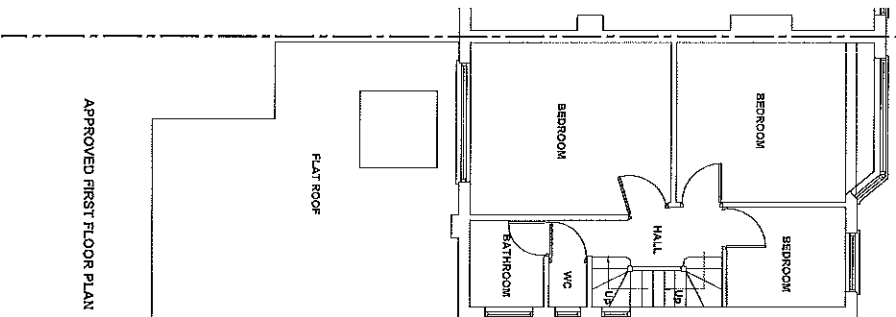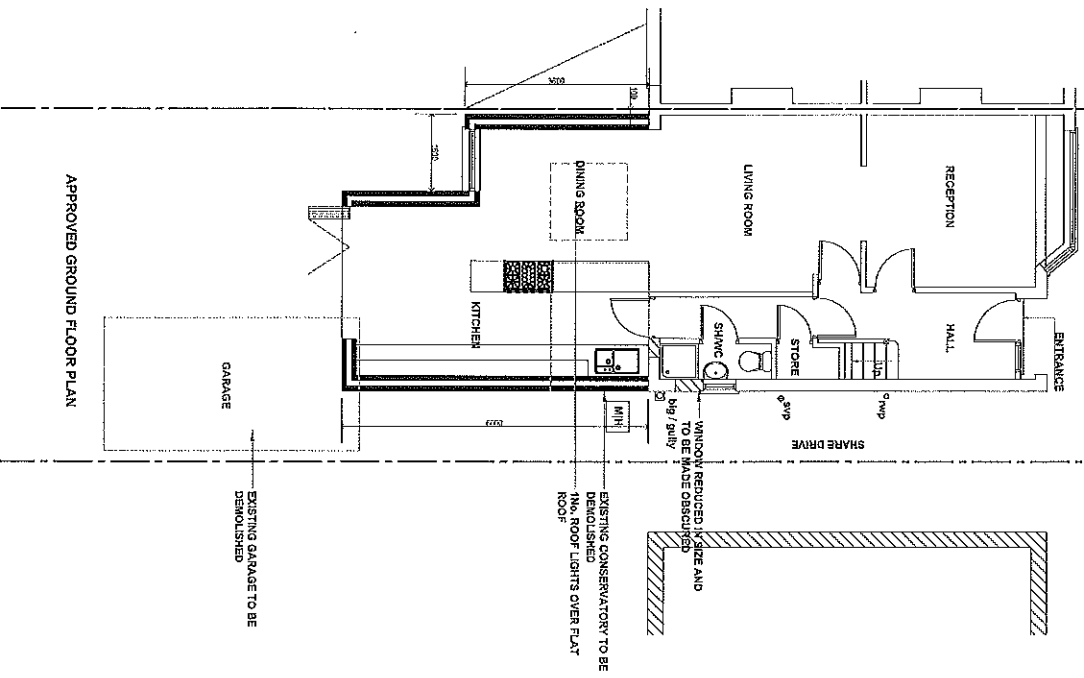

JOB TITLE			
238 WOODLANDS AVENUE			
EASTCOTE			
H44 90Y			
DRAWING TITLE			
APPROVED FLOOR PLANS			
DATE	SCALE	SHEET	
JULY 2022	1:100	A3	
DRAWN BY	P	03	

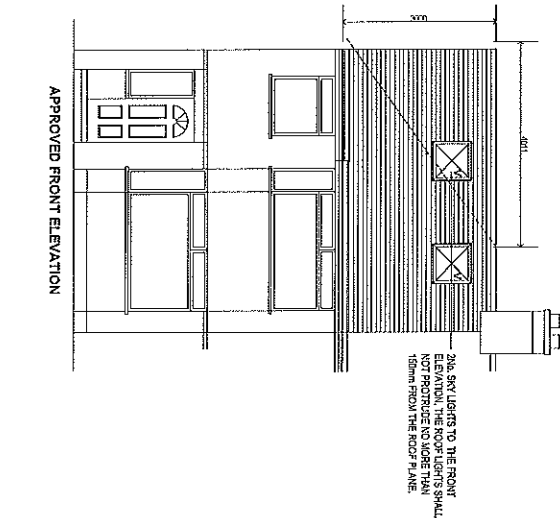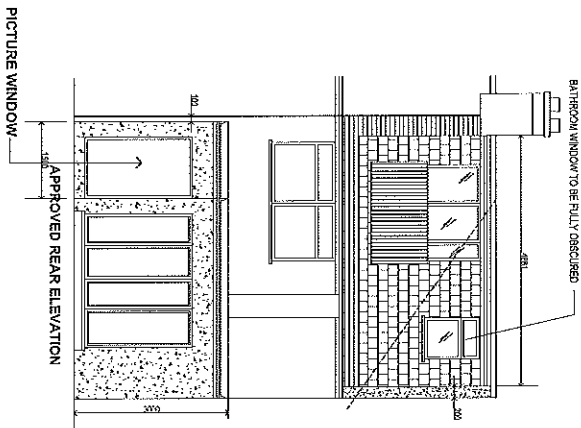

NOTE:
LOFT CONSTRUCTED UNDER
PERMITTED DEVELOPMENT.

NOTE:
ALL MATERIALS TO BE USED IN
ANY EXTERIOR WORK SHALL BE
SIMILAR APPEARANCE TO THOSE
USED IN THE CONSTRUCTION OF
THE EXISTING OF THE EXISTING
DWELLING HOUSE.

LAWFUL DEVELOPMENT

Volume of the rear dormer:-



$$\frac{1}{2} \times 4.85m \times 3.55m \times 2.55m = 22.54m^3$$

Volume increase in roof space (gable side):-

$$\frac{1}{2} \times 8.1m \times 4.01m \times 3.00m = 16.24m^3$$

Total volume:-

$$22.54 + 16.24 = 38.78m^3 < 50m^3 \text{ which is permitted}$$

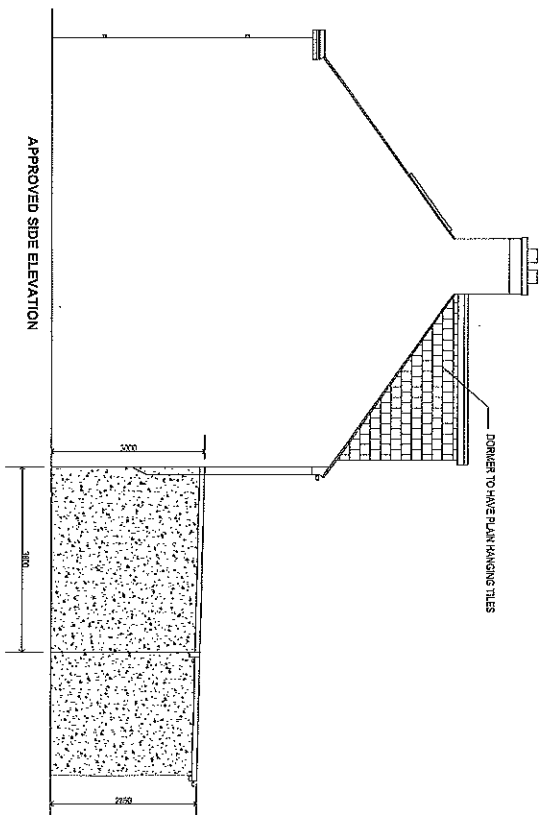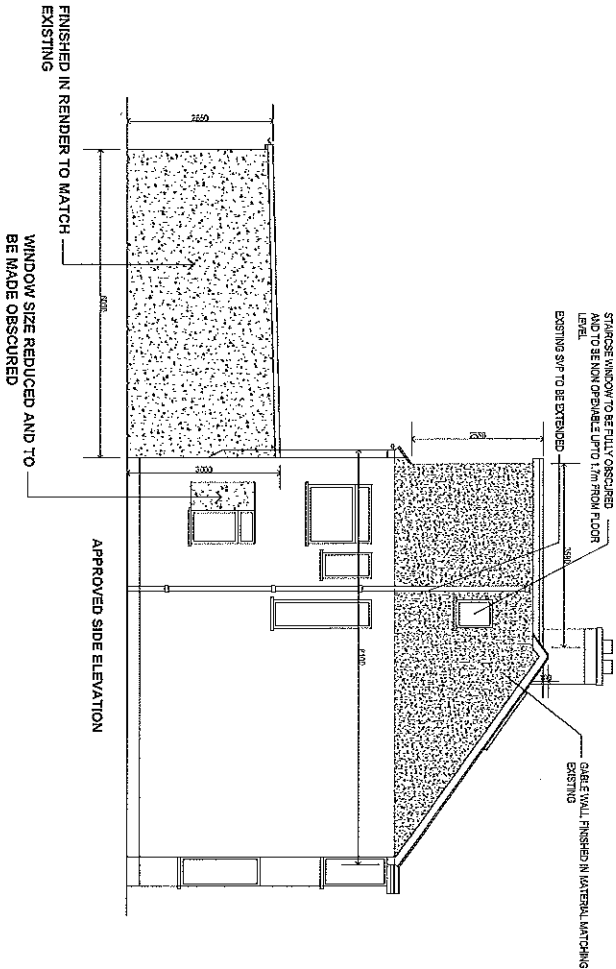





JOB TITLE
236 WOOLLANDS AVENUE
EASTCOTE
HA4 9QY

APPROVED ELEVATIONS








DATE
JULY 2022

SCALE
1:100

DRAWING No.
P 04

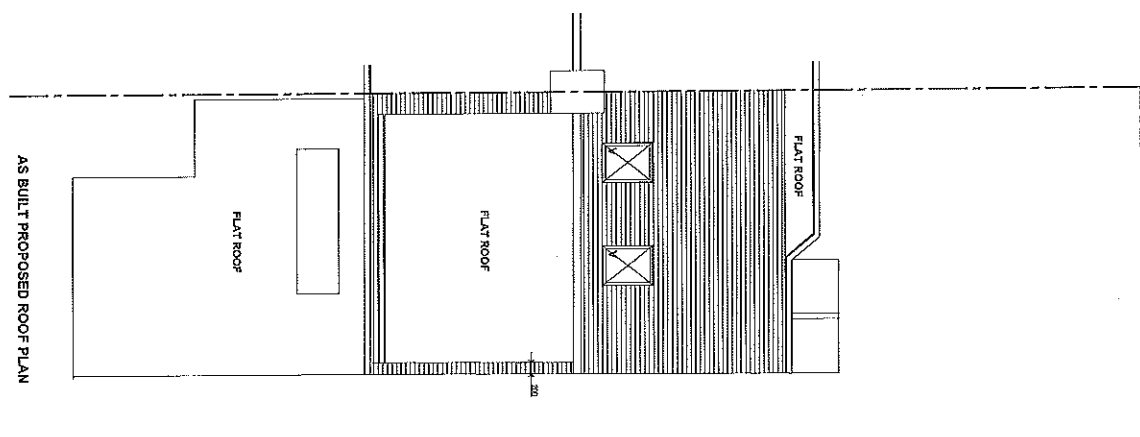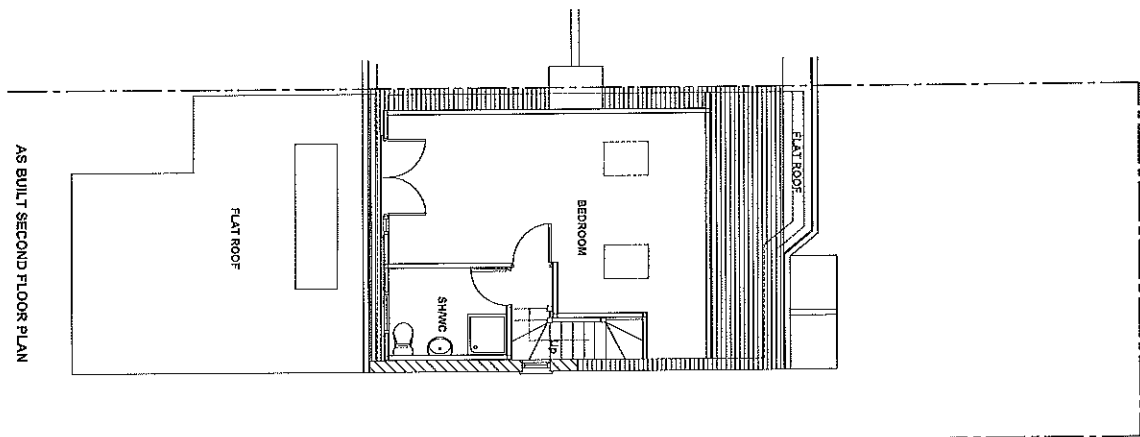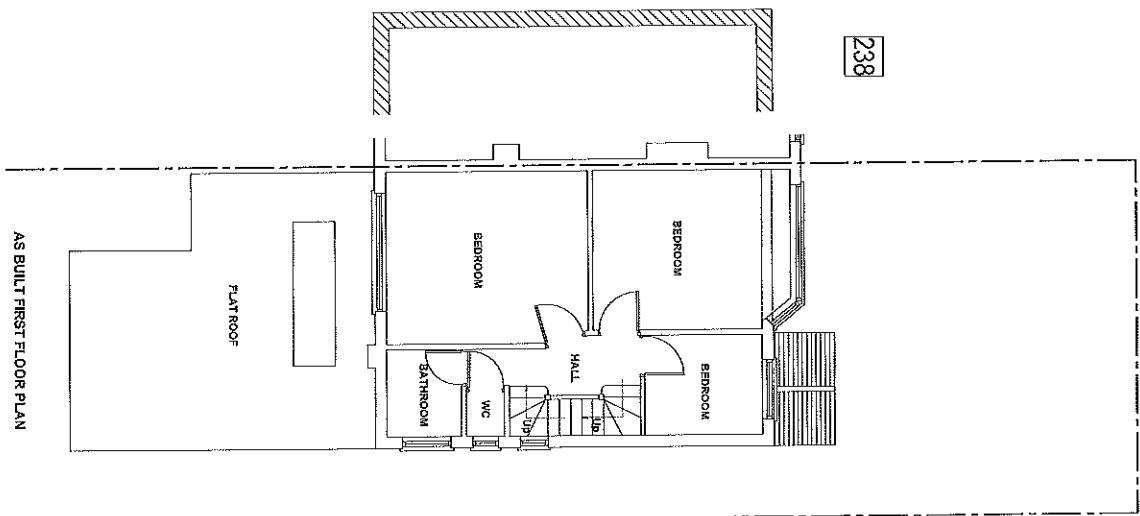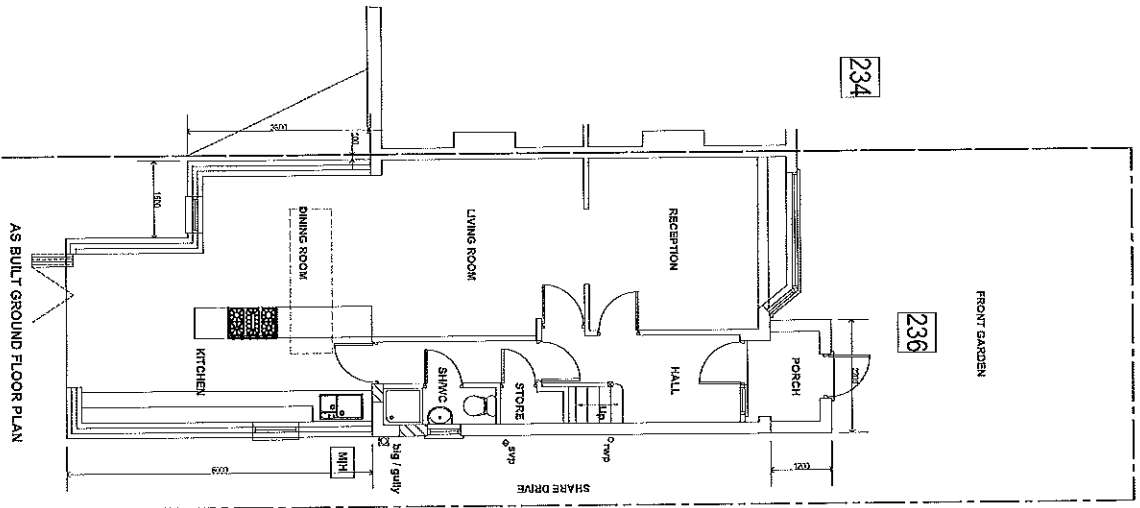

JOB TITLE		238 WOODLANDS AVENUE	
DRAWING TITLE		EASTCOTE	
DATE		H44 80Y	
JULY 2022		AS BUILT FLOOR PLANS	
DRAWING NO.		P 05	
SCALE		1:100.	
SHEET		A3	

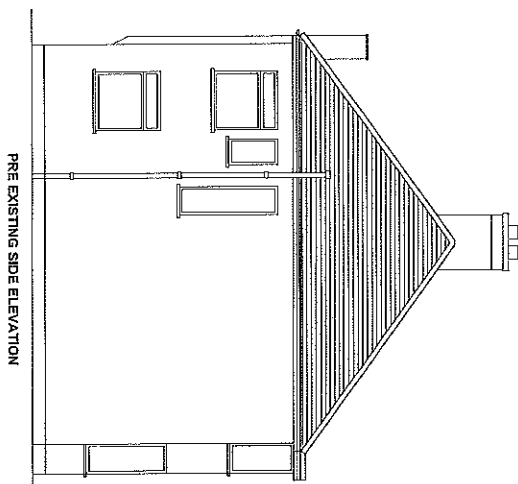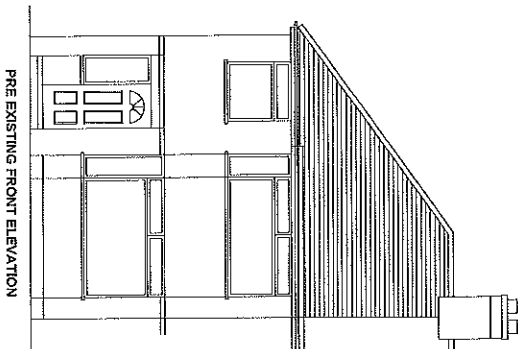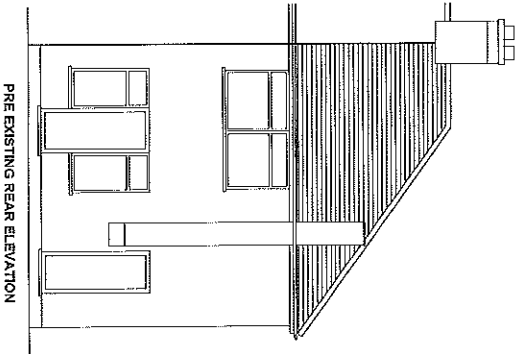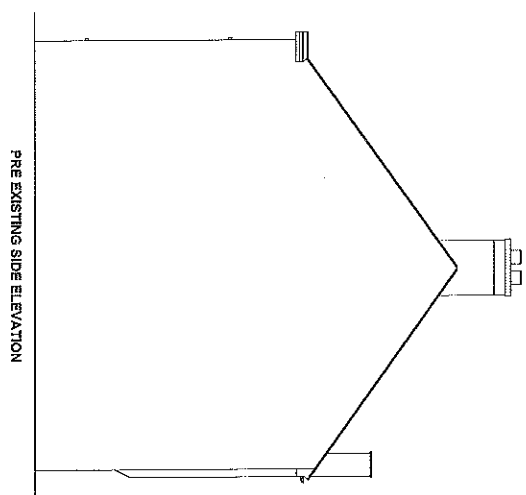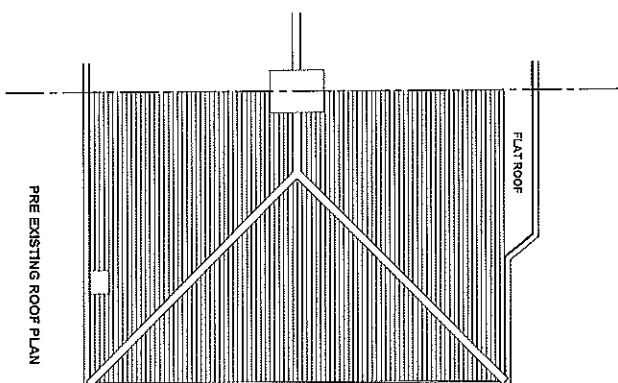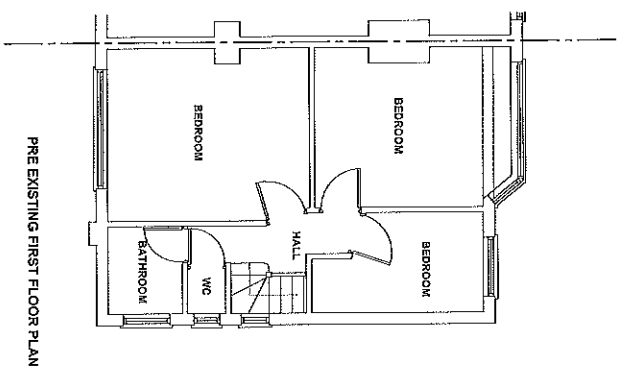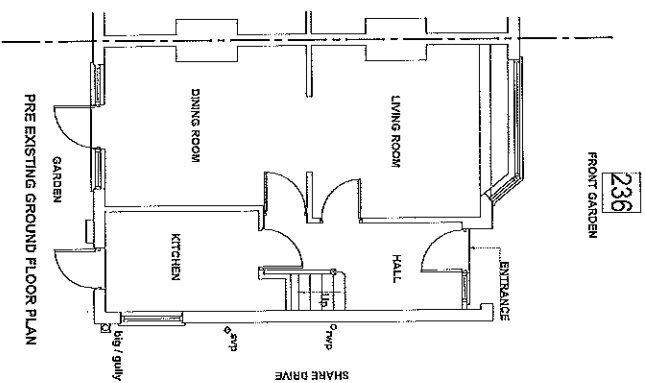

JOB TITLE			
236 WOODLANDS AVENUE			
EASTCOTE			
HAM 904			
PRE-EXISTING FLOOR PLANS & ELEVATIONS			
DATE	SCALE	SHEET	
JULY 2022	1:100	A3	
DRAWING No.	P	02	

Appendix C

Mr Joga Jutley
JSJ Designs
17
Gledwood Crescent
Hayes
UB4 0AX

Application Ref: 9248/APP/2022/2237

Date of Decision: 7th September 2022

TOWN AND COUNTRY PLANNING ACT 1990 (AS AMENDED)

REFUSAL OF PLANNING PERMISSION

The Council of the London Borough of Hillingdon as the Local Planning Authority within the meaning of the above Act and associated Orders **REFUSES** permission for the following:-

Application number: 9248/APP/2022/2237

Date your planning application was submitted: 13th July 2022

Site location: 236 Woodlands Avenue Ruislip

Description:
Retention of hip to gable loft and single storey rear extension as constructed, rear dormer and front porch.

Application submitted by: Mr Joga Jutley

Plans that this decision was based on: See attached Schedule of Plans

Permission is refused for the reason(s) listed below:-

1. The roof alterations/extension, by reason of its size, scale, bulk, design, raised roof ridge and the introduction of new exterior materials and solar panels that project above the main roof ridge, would fail to harmonise with the architectural composition of the original dwelling and would be detrimental to the character, appearance and symmetry of the pair of semi-detached dwellings of which it forms a part of and harmful to the visual amenities of the street scene and the surrounding area. Therefore the proposal would be contrary to Policy BE1 of the Hillingdon Local Plan: Part One - Strategic Policies (November 2012), Policies DMHB 11, DMHB 12 and DMHD 1 of the Hillingdon Local plan - Part Two (2020), Policy D4 of the London Plan (2021) and Paragraph 134 of the National Planning Policy

INFORMATIVES

1. On this decision notice policies from the Councils Local Plan: Part 1 - Strategic Policies appear first, then relevant Local Plan Part 2 (2020), then London Plan Policies (2021). Hillingdon's Full Council adopted the Hillingdon Local Plan: Part 1 - Strategic Policies on 8 November 2012 and the Hillingdon Local Plan Part 2 on 16 January 2020.
2. In dealing with the application the Council has implemented the requirement in the National Planning Policy Framework to work with the applicant in a positive and proactive way. We have made available detailed advice in the form of our statutory policies from the Local Plan Part 1, Local Plan Part 2, Supplementary Planning Documents, Planning Briefs and other informal written guidance, as well as offering a full pre-application advice service.

We have however been unable to seek solutions to problems arising from the application as the principal of the proposal is clearly contrary to our statutory policies and negotiation could not overcome the reasons for refusal.

STANDARD INFORMATIVES

1. The decision to **REFUSE** planning permission has been taken having regard to the policies and proposals in the Hillingdon Local Plan Part 1 (2012) and Part 2 (2020) set out below, including Supplementary Planning Guidance, and to all relevant material considerations, including The London Plan - The Spatial Development Strategy for London consolidated with alterations since 2011 (2016) and national guidance.

Part 1. Policies

PT1.BE1 (2012) Built Environment

Part 2 Policies

DMHB 11 Design of New Development

DMHB 12 Streets and Public Realm

DMHD 1 Alterations and Extensions to Residential Dwellings

DMT 6 Vehicle Parking

LPP D1 (2021) London's form, character and capacity for growth


LPP D4 (2021) Delivering good design

LPP D6 (2021) Housing quality and standards

NPPF12 NPPF 2021 - Achieving well-designed places

2. The decision to **REFUSE** planning permission has been taken having regard to all relevant planning legislation, regulations, guidance, circulars and Council policies, including The Human Rights Act (1998) (HRA 1998) which makes it unlawful for the Council to act incompatibly with Convention rights, specifically Article 6 (right to a fair hearing); Article 8 (right to respect for private and family life); Article 1 of the First Protocol (protection of property) and Article 14 (prohibition of discrimination).
-

Date of Decision: 7th September 2022

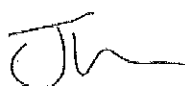

Julia Johnson
Interim Director of Planning, Regeneration & Public Realm

END OF SCHEDULE

Address:
Development Management
Directorate of Place
Hillingdon Council
3 North, Civic Centre, High Street, Uxbridge UB8 1UW
www.hillingdon.gov.uk

TOWN AND COUNTRY PLANNING ACT 1990 (AS AMENDED)

REFUSAL OF PLANNING PERMISSION

Application Ref: 9248/APP/2022/2237

SCHEDULE OF PLANS

P01.	Received	13-07-2022
P06.	Received	13-07-2022
P02.	Received	13-07-2022
P05.	Received	13-07-2022
P04.	Received	13-07-2022
P03.	Received	13-07-2022

WHAT TO DO WHEN A HOUSEHOLDER PLANNING APPLICATION IS REFUSED

If your planning application is refused but you still want to pursue it, contact your local planning department.

If you think you could make changes that resolve the reasons for refusal, you may be able to amend your application and submit it again.

Amending your planning application

If you think you could change your application to respond to the reasons for refusal, contact us about what to do next. We can give you more information about deadlines and any fees for submitting an amended application

Residents Services
London Borough of Hillingdon
3 North, Civic Centre,
High Street, Uxbridge UB8 1UW

Email: planning@hillingsdon.gov.uk

www.hillingdon.gov.uk

Appealing to the Planning Inspectorate

If you think the decision to refuse your application was incorrect, you may want to appeal to the Planning Inspectorate, which is an independent and impartial body.





If you want to appeal, the deadline is 12 weeks from the date on the decision letter, or 4 weeks if you've received an enforcement notice. Around 1 in 3 appeals is successful.






You'll need some documents to hand, so before you start, read the guidance and access the service at:





<https://appeal-planning-decision.planninginspectorate.gov.uk>





If you're unable to complete your appeal online call the Planning Inspectorate helpline on 0303 444 5000 (charges at a local rate).

Appendix D

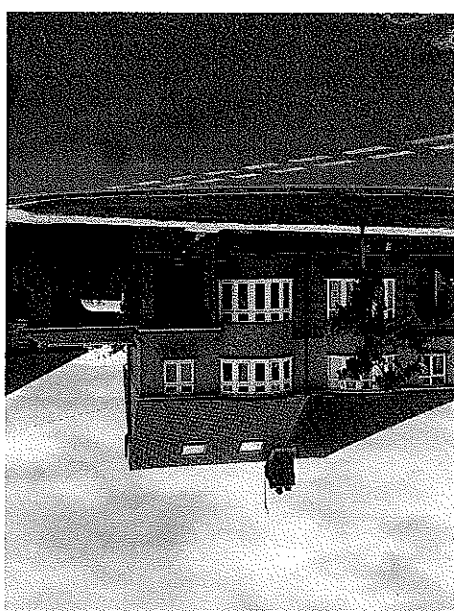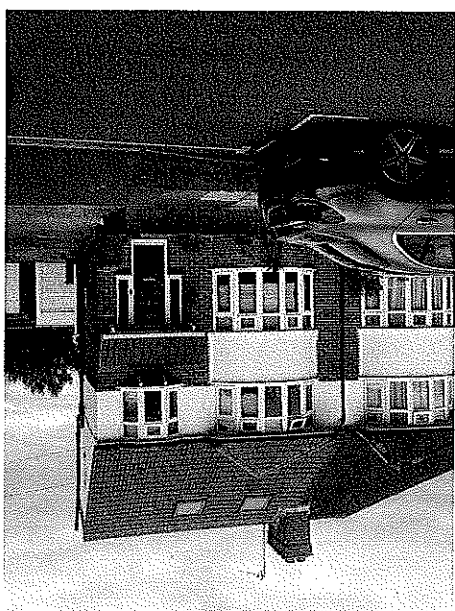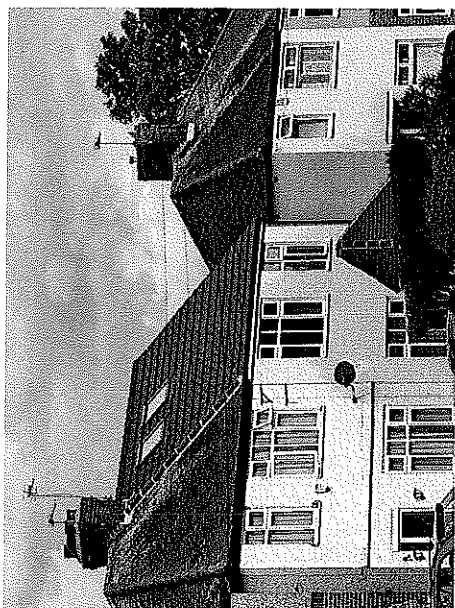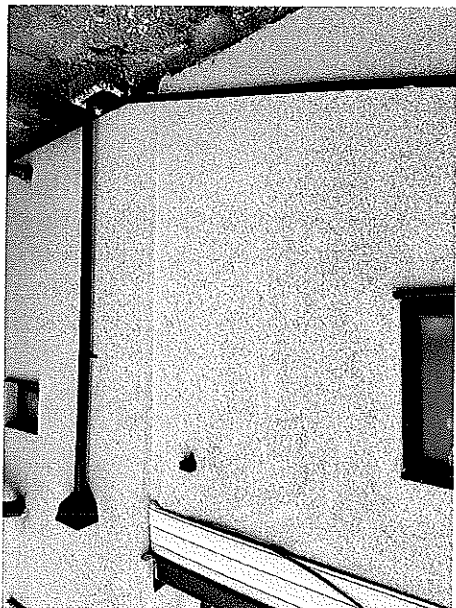

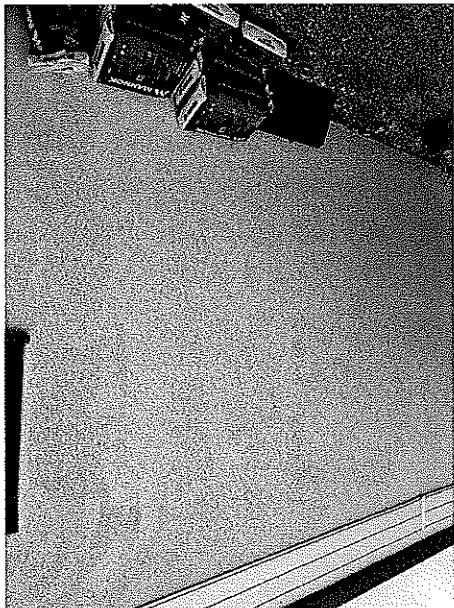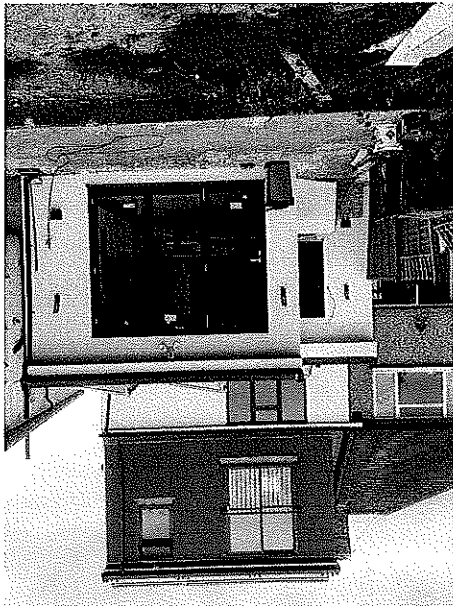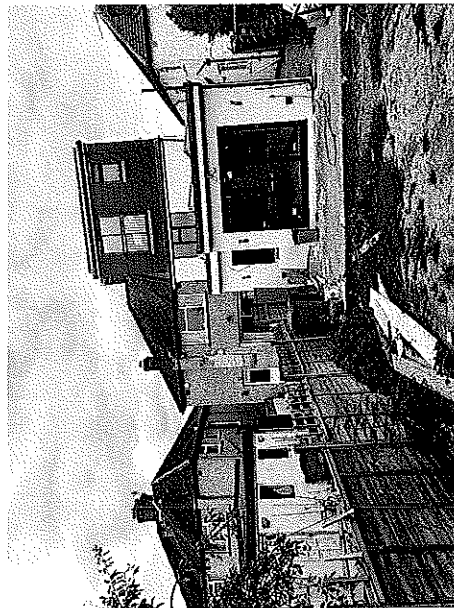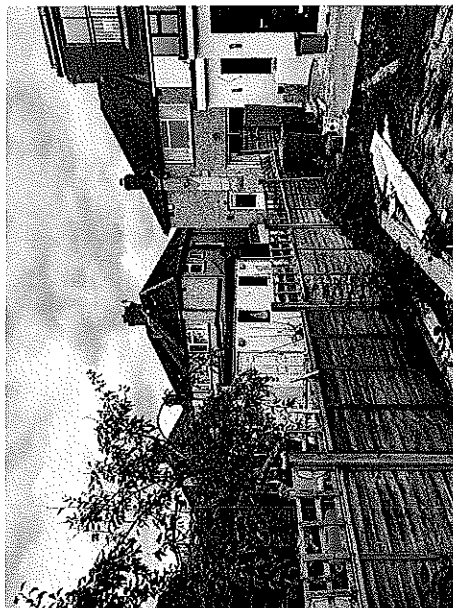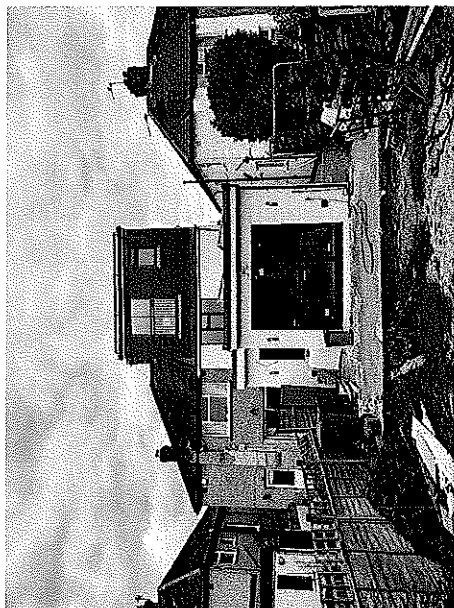

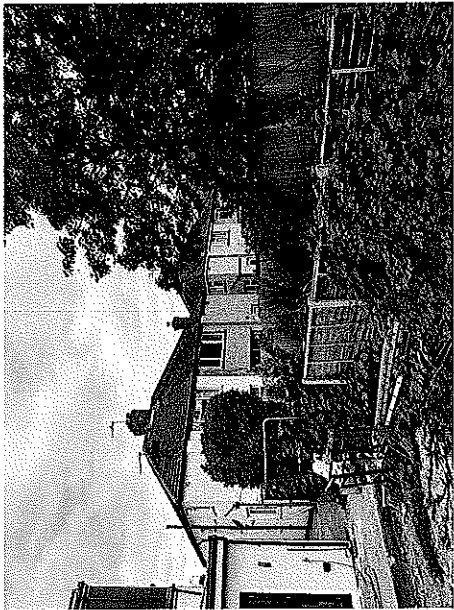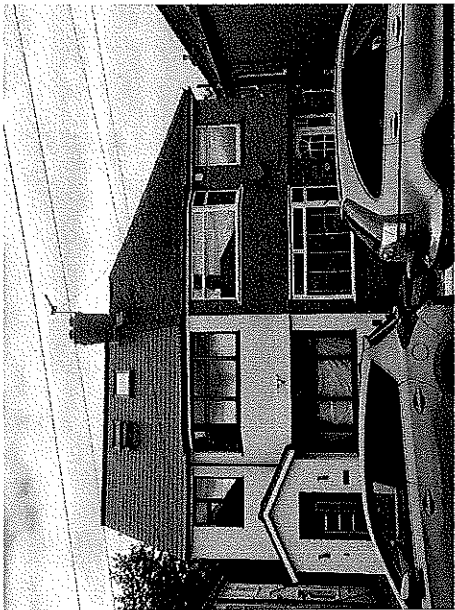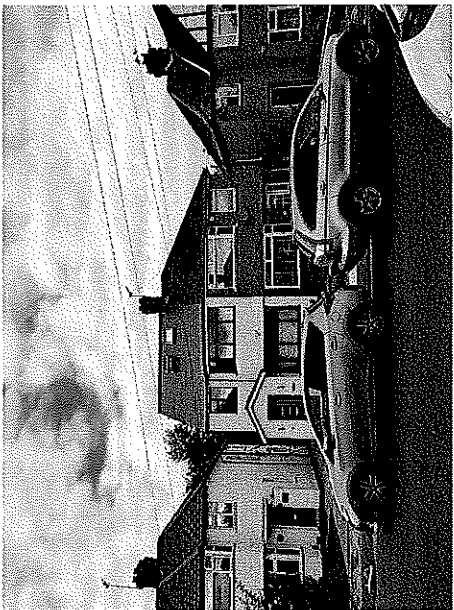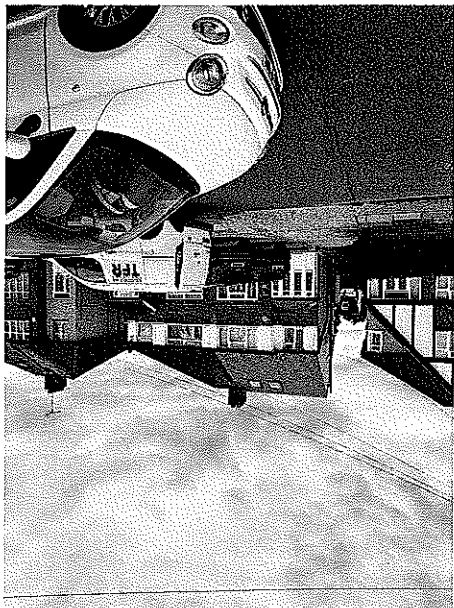

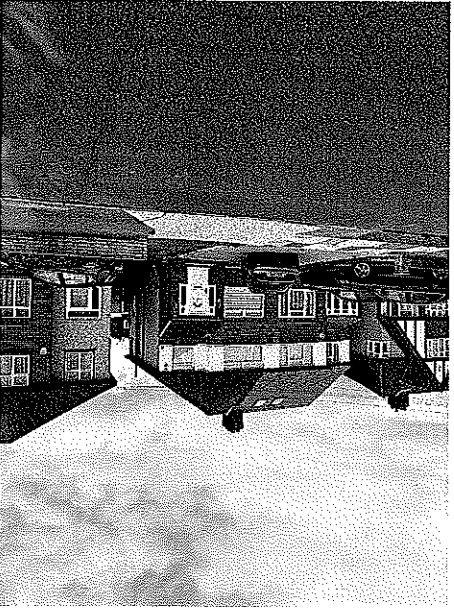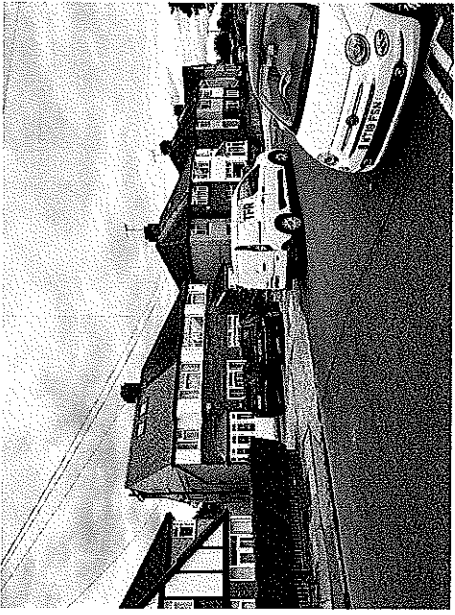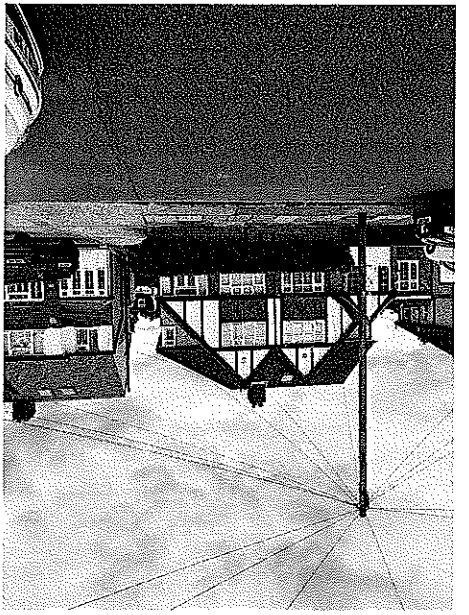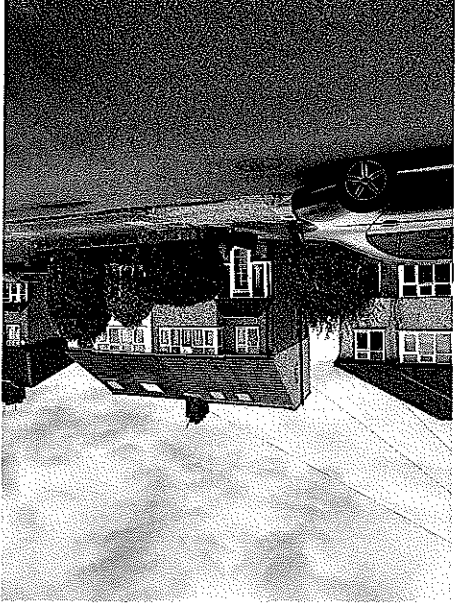

Appendix E



**Sections 191 and 192
(as amended by section 10 of the Planning and Compensation Act 1991)**

**TOWN AND COUNTRY PLANNING (GENERAL DEVELOPMENT PROCEDURE) ORDER 2015
ARTICLE 39**

CERTIFICATE OF LAWFUL USE OR DEVELOPMENT

Mr Faluck Patel
27 Priors Gardens
Ruislip
HA4 6UG

Ref: 3844/APP/2021/2695

The Council of the London Borough of Hillingdon as the Local Planning Authority, hereby certifies that the proposed development referred to below would be lawful within the meaning of Section 192 of the above Act.

Description of development: Conversion of roof space to habitable use to include a rear dormer with juliette balcony, 2 front roof lights and conversion of roof from hip to gable end with new gable end window (Application for a Certificate of Lawful Development for a Proposed Development)

Location of development: 593 FIELD END ROAD, RUISLIP,

Date of Application: 8 July 2021

Plan Numbers: See attached Schedule of Plans

The grounds for the Council's decision are listed on the attached schedule:-

Head of Planning, Transportation and Regeneration

Date: 27 August 2021

Notes: Your attention is drawn to the attached sheet which sets out the rights of applicants who are aggrieved by the decision of the Local Planning Authority.

**Sections 191 and 192
(as amended by section 10 of the Planning and Compensation Act 1991)**

**TOWN AND COUNTRY PLANNING (GENERAL DEVELOPMENT PROCEDURE) ORDER 2015
ARTICLE 39**

CERTIFICATE OF LAWFUL USE OR DEVELOPMENT

Application Ref: 3844/APP/2021/2695

SCHEDULE

The grounds for the Council's decision are as follows:-

- 1 . The proposed development constitutes permitted development by virtue of the provisions of Schedule 2, Part 1, Class B and Class C of the Town and Country Planning (General Permitted Development) (England) Order 2015 (as amended).

This determination is based on your submitted plans. All measurements are taken from existing ground level.

INFORMATIVES

- 2 . The Council will recover from the applicant the cost of highway and footway repairs, including damage to grass verges.

Care should be taken during the building works hereby approved to ensure no damage occurs to the verge or footpaths during construction. Vehicles delivering materials to this development shall not override or cause damage to the public footway. Any damage will require to be made good to the satisfaction of the Council and at the applicant's expense.

For further information and advice contact - Highways Maintenance Operations, Central Depot - Block K, Harlington Road Depot, 128 Harlington Road, Hillingdon, Middlesex, UB3 3EU (Tel: 01895 277524).

For Private Roads: Care should be taken during the building works hereby approved to ensure no damage occurs to the verge of footpaths on private roads during construction. Vehicles delivering materials to this development shall not override or cause damage to a private road and where possible alternative routes should be taken to avoid private roads. The applicant may be required to make good any damage caused.

- 3 . Nuisance from demolition and construction works is subject to control under The Control of Pollution Act 1974, the Clean Air Acts and other related legislation. In particular, you should ensure that the following are complied with:-

A. Demolition and construction works which are audible at the site boundary shall only be carried out between the hours of 08.00 and 18.00 hours Monday to Friday and between the hours of 08.00 hours and 13.00 hours on Saturday. No works shall be carried out on Sundays, Bank or Public Holidays.

B. All noise generated during such works shall be controlled in compliance with British Standard Code of Practice BS 5228:2009.

C. Dust emissions shall be controlled in compliance with the Mayor of London's Best Practice Guidance' The Control of dust and emissions from construction and demolition.

D. No bonfires that create dark smoke or nuisance to local residents.

You are advised to consult the Council's Environmental Protection Unit (www.hillingdon.gov.uk/noise Tel. 01895 250155) or to seek prior approval under Section 61 of the Control of Pollution Act if you anticipate any difficulty in carrying out construction other than within the normal working hours set out in (A) above, and by means that would minimise disturbance to adjoining premises.

- 4 . The applicant should note that if any part of the dormer is higher than the existing ridge of the roof, then this will invalidate this Certificate and planning permission will be required.

END OF SCHEDULE

Address:

Residents Services
London Borough of Hillingdon
3 North Civic Centre, High Street, Uxbridge UB8 1UW
Tel: 01895 250230
www.hillingdon.gov.uk

Sections 191 and 192
(as amended by section 10 of the Planning and Compensation Act 1991)

TOWN AND COUNTRY PLANNING (GENERAL DEVELOPMENT PROCEDURE) ORDER 2015
ARTICLE 39

CERTIFICATE OF LAWFUL USE OR DEVELOPMENT

Application Ref: 3844/APP/2021/2695

Schedule of Plans

2021/99-02 - received 08 Jul 2021

2021/99-03 - received 08 Jul 2021

2021/99-01 - received 08 Jul 2021

2021/99-04 - received 08 Jul 2021

**RIGHTS OF APPLICANTS AGGRIEVED BY DECISION
OF LOCAL PLANNING AUTHORITY**

TOWN AND COUNTRY PLANNING ACT 1990

Application for Certificate of Lawfulness

Notes

If you are aggrieved by the decision of the Local Planning Authority to refuse an application for a certificate under Sections 191 or 192 of the Town and Country Planning Act 1990 (as amended) or to refuse it in part, you may appeal to the Department of Communities and Local Government (DCLG), under Section 195 of the Act (as amended).

Notice of appeal must be given in writing to the Planning Inspectorate, 3/02 Kite Wing, Temple Quay House, 2 The Square, Temple Quay, Bristol, BS1 6PN (Tel: - 0117 372 8428).

Appeal forms can be downloaded from the Planning Inspectorate's website at

<http://www.planning-inspectorate.gov.uk>. Copies of all relevant documents, including the application, the notice of decision and all plans, drawings and correspondence, must be supplied to the Inspectorate.

You are advised to consult the brief official guide and appeals, published by the Department of Communities and Local Government (DCLG), this and appeal forms can be obtained from the Planning Inspectorate on request.

Address:

Residents Services
London Borough of Hillingdon
3 North Civic Centre, High Street, Uxbridge UB8 1UW
Tel: 01895 250230
www.hillingdon.gov.uk



Mr Daustin
21 Clifton Avenue
Stanmore
HA7 2HR

Application Ref: 25683/APP/2018/681

TOWN AND COUNTRY PLANNING ACT 1990 (AS AMENDED)

GRANT OF PLANNING PERMISSION

The Council of the London Borough of Hillingdon as the Local Planning Authority within the meaning of the above Act and associated Orders **GRANTS** permission for the following:-

Description of development:

Single storey side/rear extension, first floor side extension and conversion of roof space to habitable use to include a rear dormer and 3 front roof lights.

Location of development: 87 Bideford Road, Ruislip

Date of application: 07 March 2018

Plan Numbers: See attached Schedule of plans

Permission is subject to the condition(s) listed on the attached schedule:-

Head of Planning, Transportation and Regeneration

Date: 2 May 2018

- NOTES:
- (i) Please also see the informatives included in the Schedule of Conditions.
 - (ii) Should you wish to appeal against any of the conditions please read the attached sheet which explains the procedure.
 - (iii) This decision does not convey any approval or consent which may be required under any by-laws, building regulations or under any Act other than the Town and Country Planning Act 1990 (as amended).

TOWN AND COUNTRY PLANNING ACT 1990 (AS AMENDED)

GRANT OF PLANNING PERMISSION

Application Ref: 25683/APP/2018/681

SCHEDULE OF CONDITIONS

- 1 . The development hereby permitted shall be begun before the expiration of three years from the date of this permission.

REASON

To comply with Section 91 of the Town and Country Planning Act 1990.

- 2 . The development hereby permitted shall not be carried out except in complete accordance with the details shown on the submitted plans, number 87BR/P01 Rev. C.

REASON

To ensure the development complies with the provisions of the Hillingdon Local Plan: Part Two Saved UDP Policies (November 2012) and the London Plan (2016).

- 3 . The materials to be used in the construction of the external surfaces of the development hereby permitted shall match those used in the existing building and shall thereafter be retained as such.

REASON

To safeguard the visual amenities of the area and to ensure that the proposed development does not have an adverse effect upon the appearance of the existing building in accordance with Policy BE15 of the Hillingdon Local Plan: Part Two Saved UDP Policies (November 2012)

- 4 . Prior to the commencement of development details of a soakaway or tank to control surface water from the proposed development shall be submitted to and be approved in writing by the Local Planning Authority. The details should ensure that any new pipework would not be connected to any existing surface water network which drains to any road or sewer. Water run off from any hard paving associated with the development should also be directed to a soakaway, or made permeable. The development shall only be undertaken in accordance with those approved details, and the approved scheme shall be implemented prior to the first use of the development hereby permitted and retained for the duration of the development.

REASON:

To ensure that surface water run off is controlled and is handled as close to its source as possible to ensure the development does not increase the risk of flooding in compliance with Policy EM6 of the Hillingdon Local Plan: Part One - Strategic Policies (Nov 2012), Policies 5.12, 5.13 and 5.15 of The London Plan (2016), the National Planning Policy Framework (March 2012) and the Planning Practice Guidance (March 2014).

INFORMATIVES:

- 1 . On this decision notice policies from the Councils Local Plan: Part 1 - Strategic Policies appear first, then relevant saved policies (referred to as policies from the Hillingdon Unitary Development Plan - Saved Policies September 2007), then London Plan Policies (2016). On the 8th November 2012 Hillingdon's Full Council agreed the

SCHEDULE OF CONDITIONS

adoption of the Councils Local Plan: Part 1 - Strategic Policies. Appendix 5 of this explains which saved policies from the old Unitary Development (which was subject to a direction from Secretary of State in September 2007 agreeing that the policies were 'saved') still apply for development control decisions.

- 2 . The Council will recover from the applicant the cost of highway and footway repairs, including damage to grass verges.

Care should be taken during the building works hereby approved to ensure no damage occurs to the verge or footpaths during construction. Vehicles delivering materials to this development shall not override or cause damage to the public footway. Any damage will require to be made good to the satisfaction of the Council and at the applicant's expense.

For further information and advice contact - Highways Maintenance Operations, Central Depot - Block K, Harlington Road Depot, 128 Harlington Road, Hillingdon, Middlesex, UB3 3EU (Tel: 01895 277524).

- 3 . In dealing with the application the Council has implemented the requirement in the National Planning Policy Framework to work with the applicant in a positive and proactive way. We have made available detailed advice in the form of our statutory policies from the 'Saved' UDP 2007, Local Plan Part 1, Supplementary Planning Documents, Planning Briefs and other informal written guidance, as well as offering a full pre-application advice service, in order to ensure that the applicant has been given every opportunity to submit an application which is likely to be considered favourably.

Standard Informatives

- 1 The decision to GRANT planning permission has been taken having regard to all relevant planning legislation, regulations, guidance, circulars and Council policies, including The Human Rights Act (1998) (HRA 1998) which makes it unlawful for the Council to act incompatibly with Convention rights, specifically Article 6 (right to a fair hearing); Article 8 (right to respect for private and family life); Article 1 of the First Protocol (protection of property) and Article 14 (prohibition of discrimination).
- 2 The decision to GRANT planning permission has been taken having regard to the policies and proposals in the Hillingdon Unitary Development Plan Saved Policies (September 2007) as incorporated into the Hillingdon Local Plan (2012) set out below, including Supplementary Planning Guidance, and to all relevant material considerations, including The London Plan - The spatial development strategy for London consolidated with alterations since 2011 (2016) and national guidance:

Part 1 Policies:

PT1.BE1 (2012) Built Environment

Part 2 Policies:

AM14 New development and car parking standards.

BE13 New development must harmonise with the existing street scene.

SCHEDULE OF CONDITIONS

BE15	Alterations and extensions to existing buildings
BE19	New development must improve or complement the character of the area.
BE20	Daylight and sunlight considerations.
BE21	Siting, bulk and proximity of new buildings/extensions.
BE23	Requires the provision of adequate amenity space.
BE24	Requires new development to ensure adequate levels of privacy to neighbours.
BE38	Retention of topographical and landscape features and provision of new planting and landscaping in development proposals.
HDAS-EXT	Residential Extensions, Hillingdon Design & Access Statement, Supplementary Planning Document, adopted December 2008
LPP 3.5	(2016) Quality and design of housing developments

- 3 You are advised this permission is based on the dimensions provided on the approved drawings as numbered above. The development hereby approved must be constructed precisely in accordance with the approved drawings. Any deviation from these drawings requires the written consent of the Local Planning Authority.
- 4 You are advised that if any part of the development hereby permitted encroaches by either its roof, walls, eaves, gutters, or foundations, then a new planning application will have to be submitted. This planning permission is not valid for a development that results in any form of encroachment.
- 5 Your attention is drawn to the need to comply with the relevant provisions of the Building Regulations, the Building Acts and other related legislation. These cover such works as - the demolition of existing buildings, the erection of a new building or structure, the extension or alteration to a building, change of use of buildings, installation of services, underpinning works, and fire safety/means of escape works. Notice of intention to demolish existing buildings must be given to the Council's Building Control Service at least 6 weeks before work starts. A completed application form together with detailed plans must be submitted for approval before any building work is commenced. For further information and advice, contact - Resident Services, Building Control, 3N/01 Civic Centre, Uxbridge (Telephone 01895 558170).
- 6 You have been granted planning permission to build a residential extension. When undertaking demolition and/or building work, please be considerate to your neighbours and do not undertake work in the early morning or late at night or at any time on Sundays or Bank Holidays. Furthermore, please ensure that all

SCHEDULE OF CONDITIONS

vehicles associated with the construction of the development hereby approved are properly washed and cleaned to prevent the passage of mud and dirt onto the adjoining highway. You are advised that the Council does have formal powers to control noise and nuisance under The Control of Pollution Act 1974, the Clean Air Acts and other relevant legislation. For further information and advice, please contact - Environmental Protection Unit, 4W/04, Civic Centre, High Street, Uxbridge, UB8 1UW (Tel. 01895 250190).

- 7 The Party Wall Act 1996 requires a building owner to notify, and obtain formal agreement from, any adjoining owner, where the building owner proposes to:
- carry out work to an existing party wall;
 - build on the boundary with a neighbouring property;
 - in some circumstances, carry out groundworks within 6 metres of an adjoining building.
- Notification and agreements under this Act are the responsibility of the building owner and are quite separate from Building Regulations, or Planning Controls. The Building Control Service will assume that an applicant has obtained any necessary agreements with the adjoining owner, and nothing said or implied by the Council should be taken as removing the necessity for the building owner to comply fully with the Party Wall Act. Further information and advice is to be found in "the Party Walls etc. Act 1996 - explanatory booklet" published by the ODPM, available free of charge from the Residents Services Reception, Civic Centre, Uxbridge, UB8 1UW.
- 8 Your attention is drawn to the fact that the planning permission does not override property rights and any ancient rights of light that may exist. This permission does not empower you to enter onto land not in your ownership without the specific consent of the owner. If you require further information or advice, you should consult a solicitor.
- 9 Nuisance from demolition and construction works is subject to control under The Control of Pollution Act 1974, the Clean Air Acts and other related legislation. In particular, you should ensure that the following are complied with: -
- A) Demolition and construction works should only be carried out between the hours of 08.00 hours and 18.00 hours Monday to Friday and between the hours of 08.00 hours and 13.00 hours on Saturday. No works shall be carried out on Sundays, Bank and Public Holidays.
- B) All noise generated during such works should be controlled in compliance with British Standard Code of Practice BS 5228: 1984.
- C) The elimination of the release of dust or odours that could create a public health nuisance.
- D) No bonfires that create dark smoke or nuisance to local residents.

You are advised to consult the Council's Environmental Protection Unit, 3S/02, Civic Centre, High Street, Uxbridge, UB8 1UW (Tel.01895 277401) or to seek prior approval under Section 61 of the Control of Pollution Act if you anticipate any difficulty in carrying out construction other than within the normal working hours set out in (A) above, and by means that would minimise disturbance to adjoining premises.

SCHEDULE OF CONDITIONS

- 10 You are advised that care should be taken during the building works hereby approved to avoid spillage of mud, soil or related building materials onto the pavement or public highway. You are further advised that failure to take appropriate steps to avoid spillage or adequately clear it away could result in action being taken under the Highways Act.
- 11 To promote the development of sustainable building design and construction methods, you are encouraged to investigate the use of renewable energy resources which do not produce any extra carbon dioxide (CO2) emissions, including solar, geothermal and fuel cell systems, and use of high quality insulation.
- 12 You are advised that care should be taken during the building works hereby approved to ensure no damage occurs to the verge or footpaths during construction. Vehicles delivering materials to this development shall not override or cause damage to the public footway. Any damage will require to be made good to the satisfaction of the Council and at the applicant's expense. For further information and advice contact - Highways Maintenance Operations, Central Depot - Block K, Harlington Road Depot, 128 Harlington Road, Hillingdon, Middlesex, UB3 3EU (Tel: 01895 277524).

END OF SCHEDULE

Address:

Residents Services
London Borough of Hillingdon
3 North Civic Centre, High Street, Uxbridge UB8 1UW
Tel: 01895 250230
www.hillingdon.gov.uk

GRANT OF PLANNING PERMISSION

Application Ref.No.: 25683/APP/2018/681

SCHEDULE OF PLANS

87BR/P01 Rev. C - received 02 May 2018

RIGHTS OF APPLICANTS AGGRIEVED BY DECISION OF LOCAL PLANNING AUTHORITY

TOWN AND COUNTRY PLANNING ACT 1990 (AS AMENDED)

Appeals to the Secretary of State

- If you are aggrieved by the decision of your local planning authority to refuse permission for the proposed development or to grant it subject to conditions, then you can appeal to the office of the First Secretary of State under Section 78 of the Town and Country Planning Act 1990.
- If you want to appeal, then you must do so within six months of the date of this notice
- Appeals must be made using a form which you can get from the Planning Inspectorate at Customer Support Unit, Room 3/15 Eagle Wing, Temple Quay House, 2 The Square, Temple Quay, Bristol, BS1 6PN or online at www.planningportal.gov.uk/pes.
- The Secretary of State can allow a longer period for giving notice of an appeal, but he will not normally be prepared to use this power unless there are special circumstances, which excuse the delay in giving notice of appeal.
- The Secretary of State need not consider an appeal if it seems to him that the local planning authority could not have granted planning permission for the proposed development or could not have granted it without the conditions they imposed, having regard to the statutory requirements, to the provisions of any development order and to any directions given under a development order.
- In practice, the Secretary of State does not refuse to consider appeals solely because the local planning authority based their decision on a direction given by him.

Purchase Notices.

- If either the local planning authority or the office of the First Secretary of State refuses permission to develop land or grants it subject to conditions, the owner may claim that he can neither put the land to a reasonably beneficial use in its existing state nor render the land capable of a reasonably beneficial use by carrying out of any development which has been or would be permitted.
- In these circumstances, the owner may serve a purchase notice on the Council (District Council, London Borough Council or Common Council of the City of London) in whose area the land is situated. This notice will require the Council to purchase his interest in the land in accordance with the provisions of Part VI of the Town and Country Planning Act 1990.