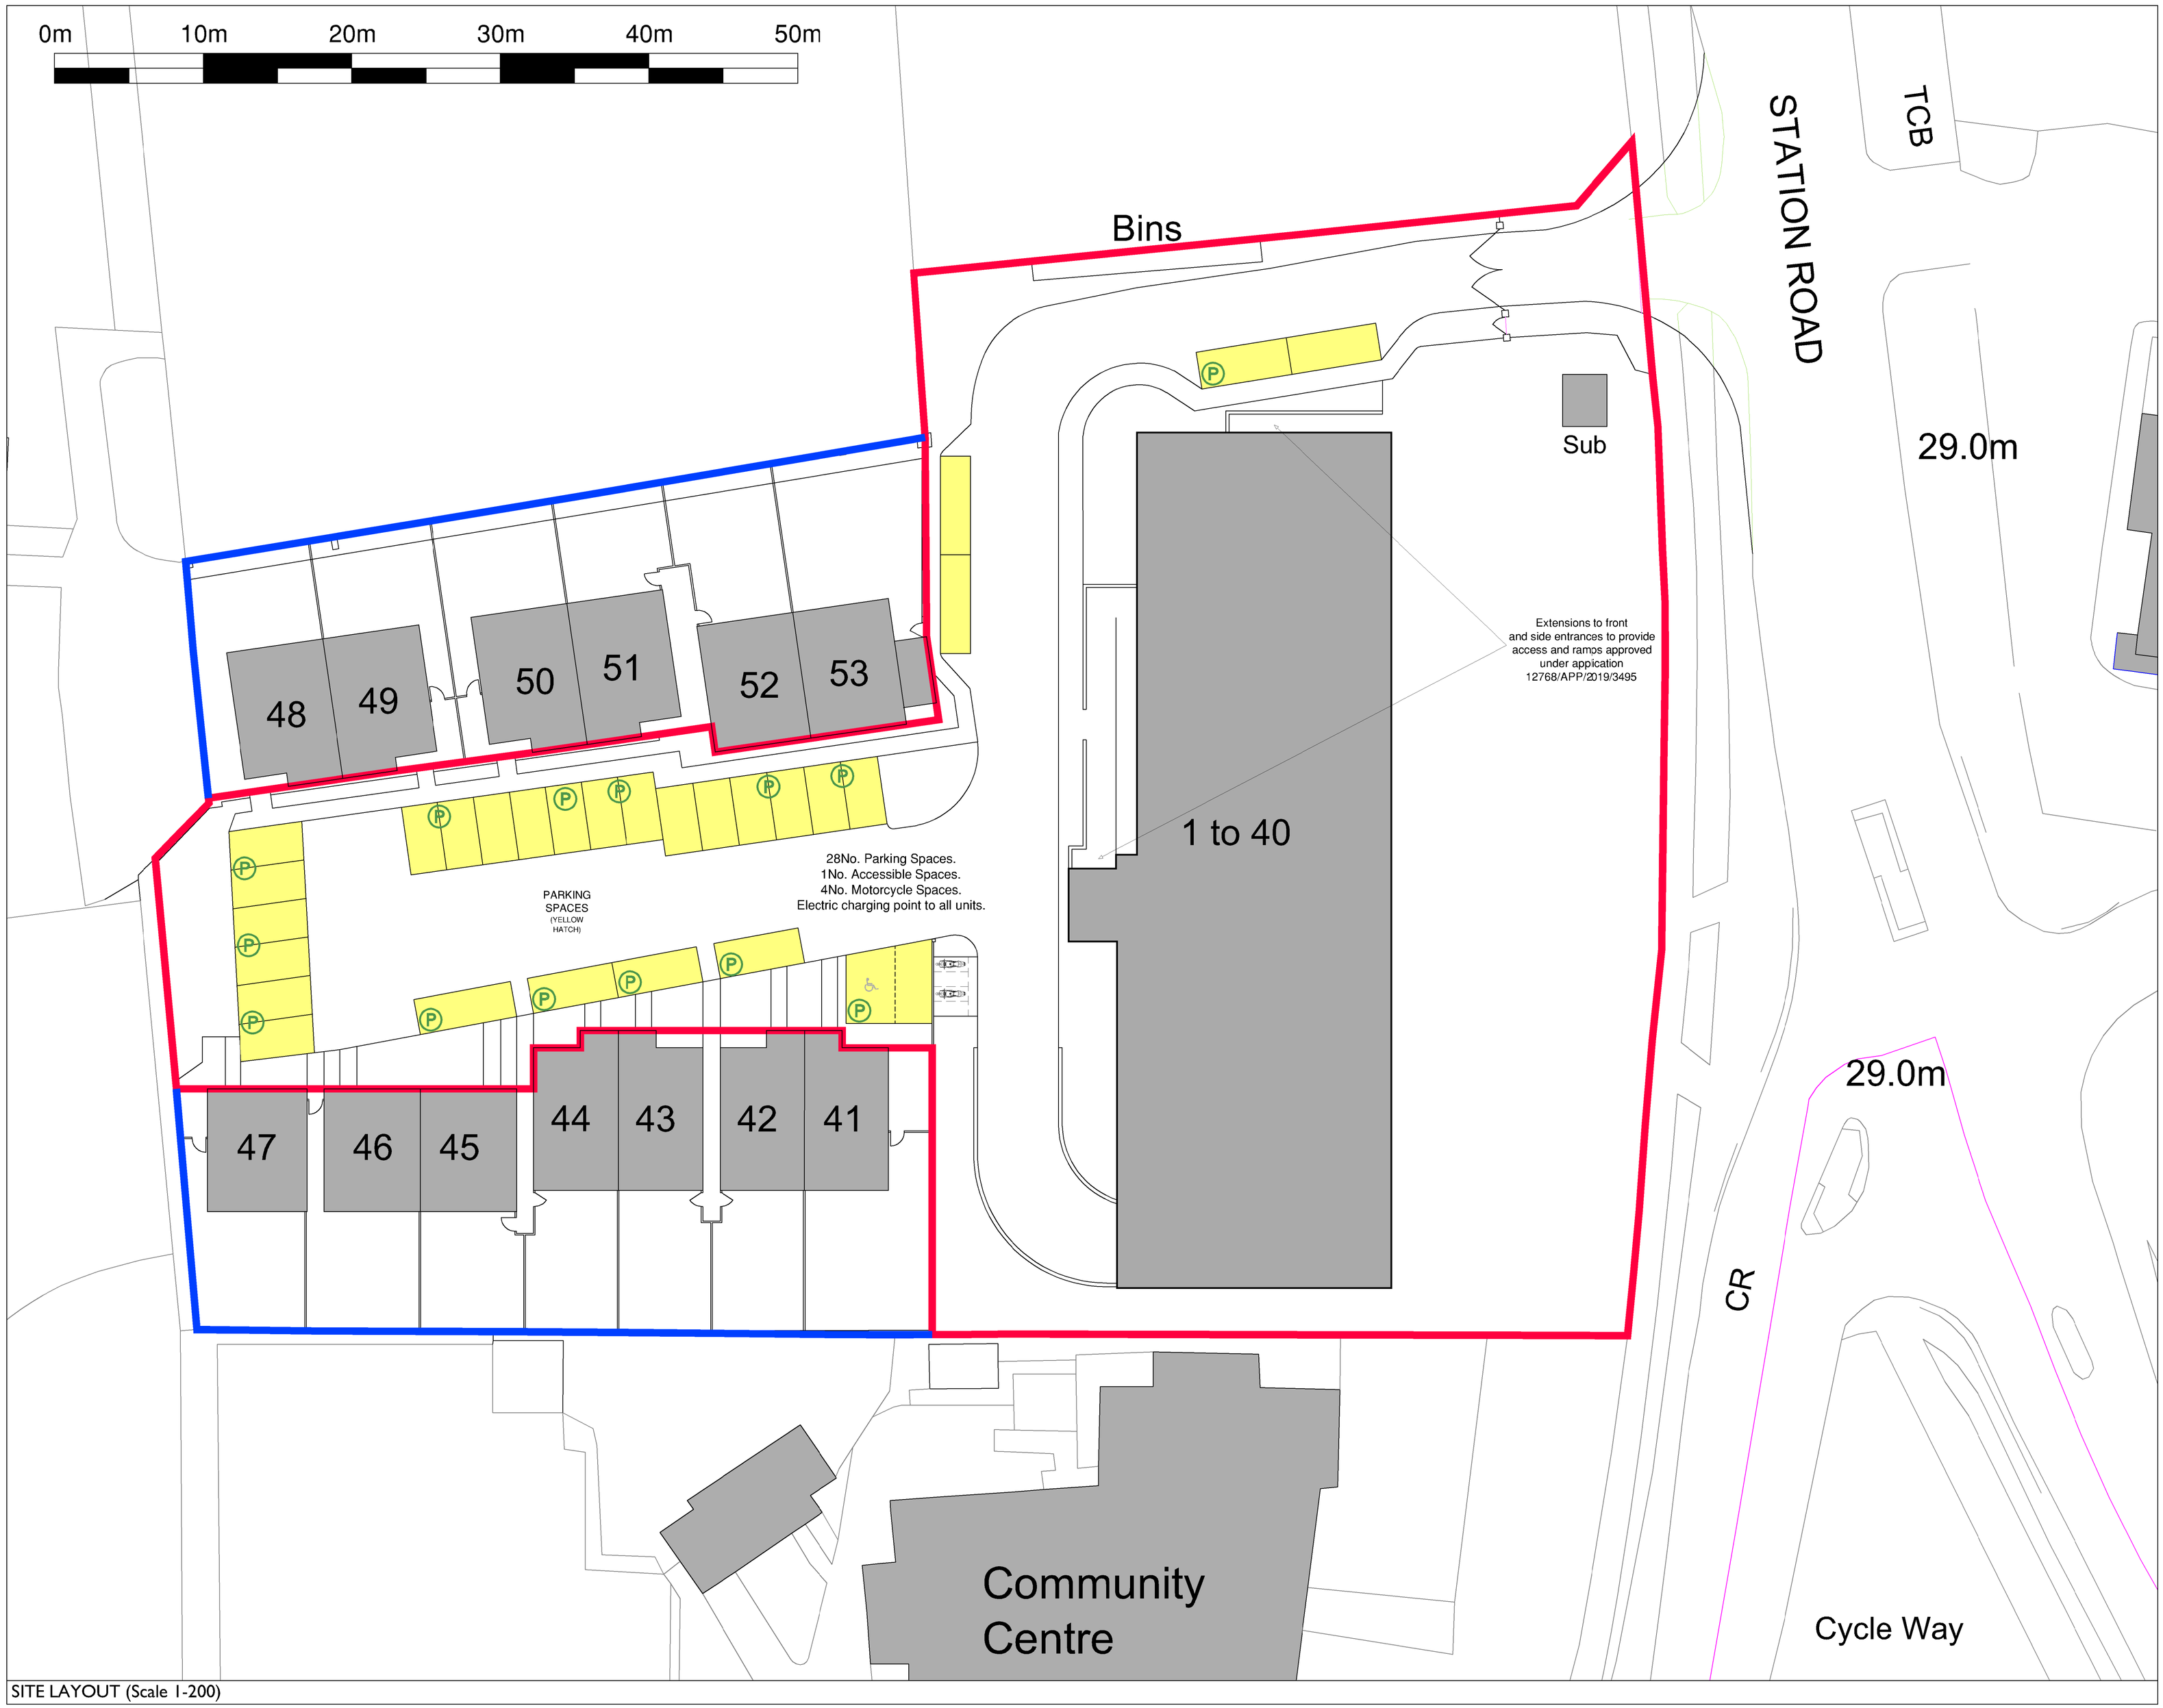

SITE LAYOUT (Scale 1-200)

NOTE

THIS DRAWING IS THE COPYRIGHT OF AMASIA ARCHITECTS LTD AND MAY NOT BE COPIED, ALTERED OR REPRODUCED IN ANY FORM, OR PASSED TO A THIRD PARTY WITHOUT THE WRITTEN CONSENT OF AMASIA ARCHITECTS LTD. DIMENSIONS SHOULD BE CHECKED AND VERIFIED ON SITE AND ANY DISCREPANCIES SHOULD BE REPORTED TO THE ARCHITECT. USE FIGURED DIMENSIONS ONLY.
IF IN DOUBT ASK FOR CONFIRMATION.

KEY:

AS BUILT PARKING SPACES

ROLEC EVWP2010 ACTIVE ELECTRIC VEHICLE CHARGING POINT (16 AMP)

NORTH

REV.	DESCRIPTION	DRAWN	DATE
A	MOTORCYCLE SPACES ADDED, ELECTRIC CHARGING POINTS UPDATE, PARKING MIX ADDED	SG	26-03-21

REVISIONS

Issued for
PROPOSALS

SITE ADDRESS
FORMER WEST DRAYTON
POLICE STATION
CONSTABULARY CLOSE
WEST DRAYTON
LONDON, UB7 7GE

CLIENT
KEARNS PREMIER HOMES

SCALE	SHEET SIZE	DRAWN	DATE
1-200	A1	SG	JAN 21

DRAWING TITLE
AS BUILT PARKING
LAYOUT

DRAWING NUMBER
AAL-20-235-P01

REVISION
A

AMASIA
ARCHITECTS LTD

ALBURY ESTATE
LOWER BARN
WESTON FARM
ALBURY
SURREY
GU5 9BZ

T: 01483 205724

www.amasiaarchitects.com
enquiries@amasiaarchitects.com

Company Reg. No. 6809033
VAT Reg. No. 946 3191 10