

X01 **Main Residential Entrance Door**
 Access: residents, visitors, management, postman, fire brigade
 Fob & video entry, push button for exit
 Locking to suit security rating
 Glass to suit security rating

X02 **Secondary Residential Entrance Door (Rear Access)**
 Access: residents, visitors, management, fire escape
 Fob & audio entry, push button for exit
 Locking to suit security rating
 Glass to suit security rating

X03 **Refuse & Cycle Store Door**
 Access: residents, management, fire brigade, fire escape
 Fob door entry, push button for exit
 Locking mechanism to suit security rating

X05 **Private Terrace Door (Ground Floor)**
 Access: residents of individual units (from inside only)
 Cylinder operated multi-point lock. Lever & key internally, blank externally
 Lockable restricted opening to 100mm for night cooling
 Glass to security rating
 Friction stay

X06 **Upper Floor Balcony / Terrace Door**
 Access: residents of individual units (from inside only)
 Cylinder operated multi-point lock. Lever & key internally, lever only externally
 Friction stay

X09 **Opening Windows (Upper Floors)**
 Cylinder-operated lock

X10 **Opening Windows (Ground Floor)**
 Cylinder-operated lock
 Lockable restricted opening to 100mm for night cooling
 Glass to security rating

X11 **Roof Access Hatch**
 Access: management (trained / qualified personnel only)
 Cylinder-operated lock inside and out
 Retractable zip ladder with locking ceiling hatch
 Retractable handrail and guard on roof

X14 **External Gate to Side**
 Access: Tenants/visitors of storage/commercial unit, management, fire brigade
 Fob entry, push button for exit
 Magnetic locking mechanism

X15 **Commercial Store Door**
 Access: Commercial unit tenant
 High security cylinder lock inside and out
 Full specification to be confirmed

X16 **Roof Access Door**
 Access: Management, fire brigade
 Euro cylinder lock

A01 **Apartment Entry Door**
 Access: residents of individual units
 TS007 3 Star rated Cylinder-operated multi-point lock
 Thumbturn internally, key externally
 Door viewer
 No letterbox

C01 **Main Communal Door**
 Access: residents, visitors, management, postman, fire brigade, fire escape
 Fob & audio intercom door entry, push button for exit
 Magnetic locking mechanism

C02 **Secondary Communal Door (Core / Fire Stair)**
 Access: residents, management, fire brigade, fire escape
 Fob door entry, push button for exit
 Magnetic locking mechanism

C03 **Communal Ancillary / Plant Door**
 Access: management, fire brigade
 Euro cylinder lock


LIFTS GENERALLY
 Access: residents, visitors, management, firefighting access
 Fob & Audio intercom entry outside lift door at ground floor with selective landing control
 Without fob, only onward travel to ground possible



date rev revisions

26.09.22 C1 For Construction
09.06.23 C2 Record Drawings

keyplan

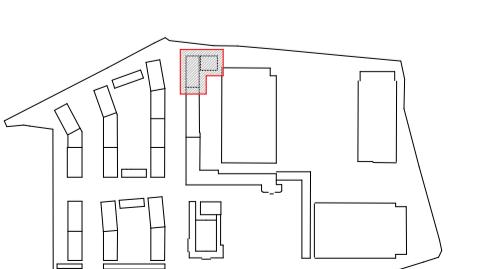

notes

dMFK Architects Ltd take no responsibility for dimensions obtained by scaling from this drawing. If no dimension is shown the recipient must ascertain the dimension specifically from the architect or by site measurement and may not rely on the drawing. Supply of the drawing in digital form is solely for convenience and no reliance may be placed on any data in digital form. All data must be checked against hard copy. This drawing is issued for design intent only and should not be used for construction unless stated.

copyright
This drawing is the property of dMFK Architects Ltd. No disclosure or copy of it may be made without the written permission of dMFK Architects Ltd.

0 1 2 3 4 5 10
scale at A1 scale at A3
1 : 100 1 : 200
Drawn by Checked by
LS TC
2177 Barratt London FNF-A-F3-dMFK-DR-68-105
Nestlé Factory, F3 Access and Security - Fifth Floor Plan
project no. client drawing no.
the old library 119 chalcot gardens london nw6 1sa
t 020 7425 1144 f 020 7425 0084 mail info@dmfk.co.uk

 dMFK
DE METZ FORBES KNIGHT ARCHITECTS

C2