

Technical design note

Project name	Nestle Block B		
Design note title	Flood Risk response to LLFA March 2024		
Document reference	C-01669_TN-C-0125		
Author	GJ		
Revision	P02		
Date	3 May 2024	Approved	<input type="checkbox"/>

1. Introduction

The purpose of this technical note is to provide clear responses and supporting information for Hillingdon Planning and Regeneration in regards to flood risk queries from the LLFA concerning Nestle Block B issued on 28th March 2024. The following correspondence has been received by Boyer Planning: -

- *Confirms the total site area for Block B (including both permeable and impermeable areas).*
- *Clarifies the changes that have been made to the approved drainage strategy during the detailed design stage.*
- *The calculations show there to be flooding in the 1 in 100 year event. The location and extent of this flooding should be marked on a drainage diagram, demonstrating that there will be no flooding to any buildings.*
- *Provide the maintenance tasks or frequencies for the proposed green roofs.*
- *Provide details on the interim drainage solutions during development to ensure that surface water runoff will not increase the risk of flooding to or from development.*
- *Provide the named Landscape Architect's drawing in Appendix I showing the details of rainwater harvesting.*
- *The application has changed in the following way: The applicant provided a document responding to each of the matters, including an updated drainage strategy and calculations.*

We object to the application for the following reasons:

- *MORE INFORMATION REQUIRED – The impermeable areas provided are not consistent throughout the documentation. The applicant should confirm both the total impermeable AND permeable area of the site.*
- *MORE INFORMATION REQUIRED – The applicant has provided updated calculations showing no flooding in a 1 in 100 year plus climate change event. However, the calculations do not incorporate the whole of the Block B development area.*

- *MORE INFORMATION REQUIRED – The applicant must provide maintenance tasks and frequencies for the proposed green roofs. The location of the green and blue roofs should be shown on the drainage plan.*
- *To address the above, please can the applicant submit information which:*

2. Responses

2.1 Catchment Areas

Confirms the total site area for Block B (including both permeable and impermeable areas)

The total existing impermeable catchment area within Block B site area is shown on drawing FNF-C-B-HYD-SK-01-0101 P01 Rain water catchment area. Refer to Appendix A.

Note the drawing includes total catchment area discharging to the western outfall to the canal.

○ External impermeable areas	= 2,783 m ²
○ Building roofs (Blue Roofs)	= 5,037 m ²
○ Podium B	= 4,713 m ²
○ Permeable paving	= 2,543m ²
○ Total area captured by positive drainage	= 15,076m²
○ Verges	= 2869 m ²

Note Microdrainage calculations (appendix D) includes maximum discharge rates from the Blue and Block H roofs (under the Base Flow l/s column) and consequently the total impermeable area will not comply with total above.

Existing Total Catchment areas discharging to the canal are shown in Appendix C: -

○ Existing external impermeable areas	= 32,391 m ²
○ Existing external permeable areas	= 3,891 m ²
○ Total area	= 36,282m²

The existing positively drained catchment area from the extents of Block B catchment area = 19,833 m². This is 4,757 m² less than existing.

Refer to Appendix F for Application Information summarising the catchment areas in section j).

2.2 Clarification of changes made to the drainage strategy

Clarifies the changes that have been made to the approved drainage strategy during the detailed design stage

The latest drainage layout capturing the minor changes to the landscape area is shown on Block B Drainage Layout. The drainage strategy remains unchanged. Refer to Appendix B.

- FNF-C-B-HYD-DR-01-0200 C19 Drainage Layout Block B Sheet 1 of 3
- FNF-C-B-HYD-DR-01-0201 C14 Drainage Layout Block B Sheet 2 of 3
- FNF-C-B-HYD-DR-01-0202 C24 Drainage Layout Block B Sheet 3 of 3

2.3 Block B Microdrainage calculations

The calculations show there to be flooding in the 1 in 100 year event. The location and extent of this flooding should be marked on a drainage diagram, demonstrating that there will be no flooding to any buildings.

The Microdrainage calculations show no flooding for a 1 in 100 = 40% c.c. Refer to Appendix D. .

2.4 Block B blue roof maintenance

Provide the maintenance tasks or frequencies for the proposed green/blue roofs

Alumasc blue roof system maintenance guidelines are found in Appendix D. Inspections and maintenance to be carried out every 4 months.

2.5 Site Wide Drainage


Provide details on the interim drainage solutions during development to ensure that surface water runoff will not increase the risk of flooding to or from development

The roof and impermeable hardstanding areas from Block B storm water system is part of a greater storm network associated with Block E (to the west) and Block F2 and F3 (to the east). The combined catchment area from these developments discharge to the canal to the north of the site at a restricted discharge of 45 l/s. Refer to drainage layout drawing FNF-C-B-HYD-DR-01-0200 to 0202. This stilling chamber is already installed, and consequently all positive drainage from site will be controlled and not risk flooding to or from the development.


2.6 Rain water Harvesting

The below ground rain water harvesting tank adjacent to the running track has now been replaced with an above ground tank within Block E Plant room. It stores water directly from a rain water down pipe. For further information contact Barratt London and the M&E Consultant OCSC.

3. Appendix A –Catchment Areas

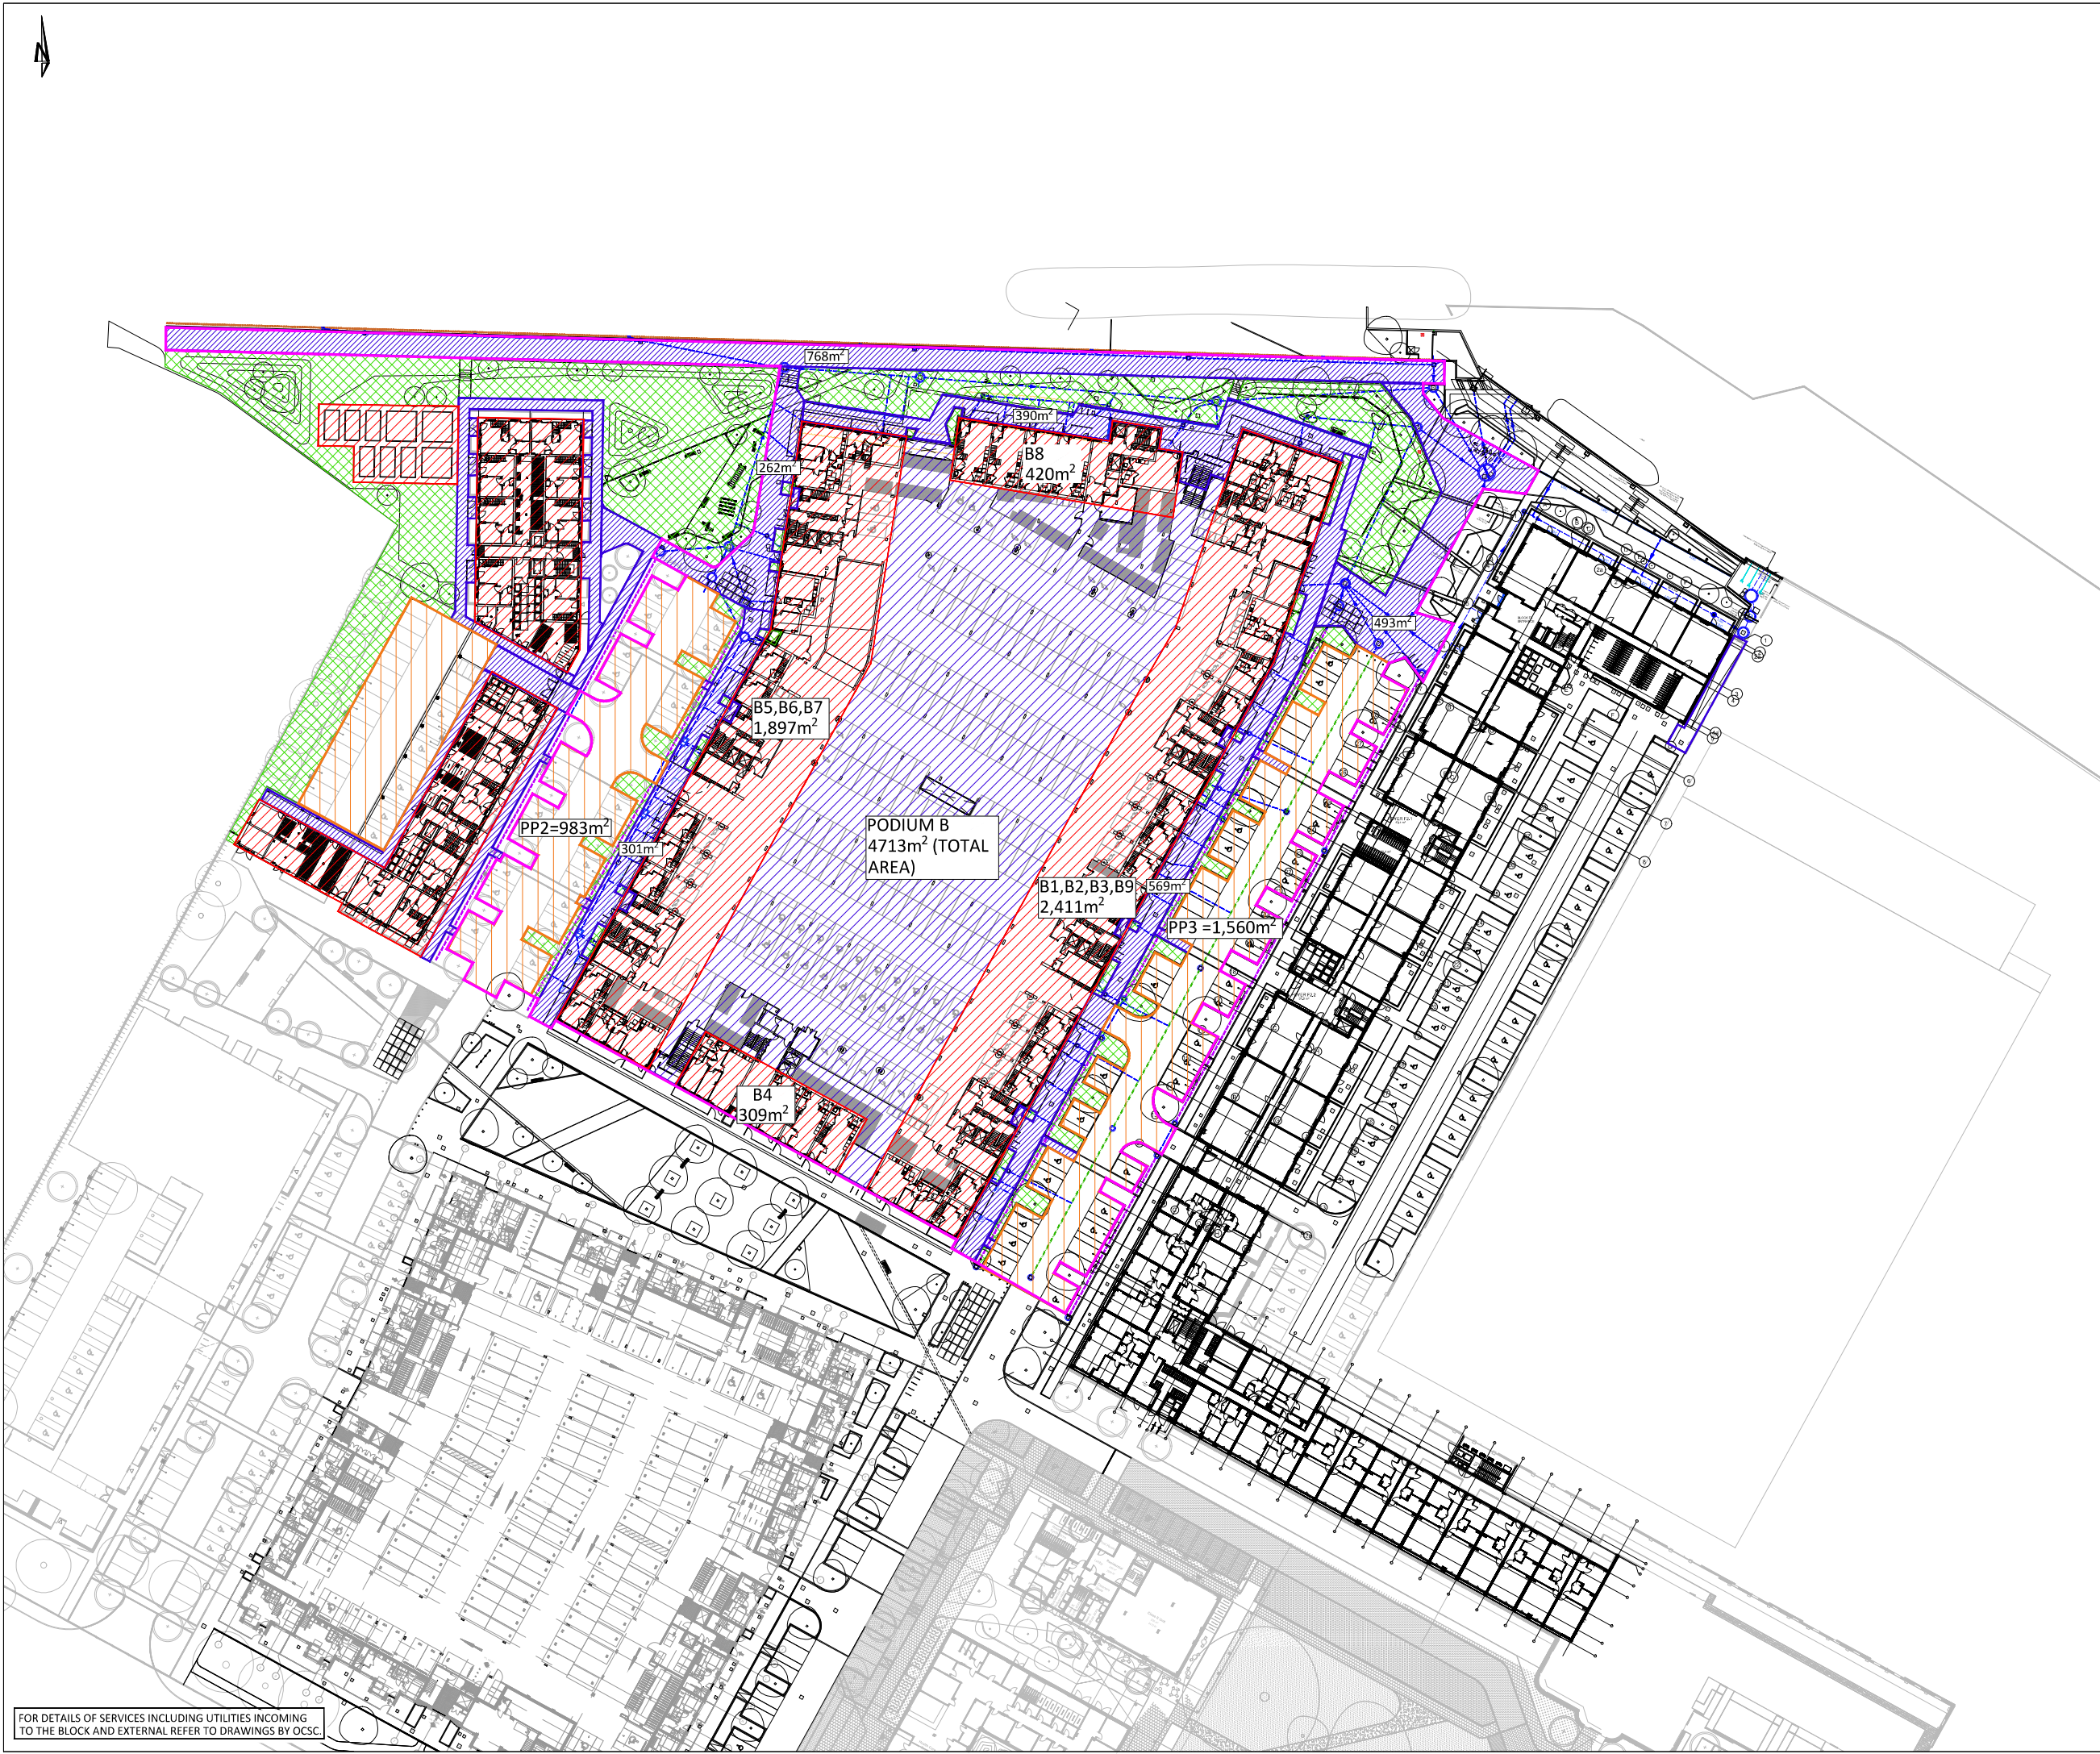

FOR DETAILS OF SERVICES INCLUDING UTILITIES INCOMING TO THE BLOCK AND EXTERNAL REFER TO DRAWINGS BY OCSC.

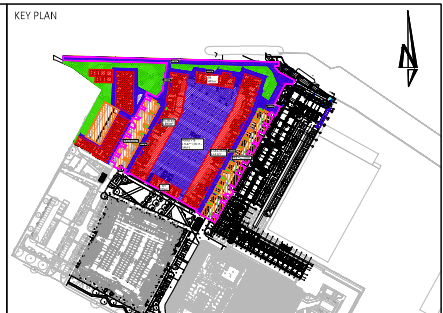

KEY:

	EXTERNAL IMPERMEABLE AREAS
	BUILDING ROOFS
	AREAS OF PERMEABLE PAVING
	PODIUM B
	SOFT LANDSCAPING
	BOUNDARY TO POSITIVELY DRAINED BY BLOCK B DRAINAGE NETWORK

TOTAL AREAS:

EXTERNAL IMPERMEABLE AREAS:	2783 m ²
BUILDING ROOFS:	5037 m ²
AREAS OF PERMEABLE PAVING:	2543 m ²
PODIUM B:	4713 m ²
TOTAL IMPERMEABLE AREA:	15076 m ²

REVISIONS

REV	DRAWN BY	DATE	CHECKED BY	DATE	APPROVED BY	DATE
P01	RS	12.03.2024	GJ	12.03.2024	GJ	12.03.2024


FIRST ISSUE

HYDROCK
HYDROCK
HYDROCK

HAYES
Limbridge Court
Gloucester
Gloucestershire
GL3 1JZ
t: +44 (0) 1452 783970
e: gloucester@hydrock.com

CLIENT	BARRATT LONDON	
PROJECT	FORMER NESTLE SITE HAYES	
TITLE	BLOCK B DRAINAGE IMPERMEABLE AND PERMEABLE AREAS	
HYDROCK PROJECT NO.	C-01669	SCALE @ A1 1:500
STATUS DESCRIPTION	SUITABLE FOR INFORMATION	STATUS S2
DRAWING NO. (PROJECT CODE-ORIGINATOR-ZONE-LEVEL-TYPE-ROLE-NUMBER)	FNF-C-B-HYD-SK-01-101	REVISION P01

4. Appendix B – Drainage Layout

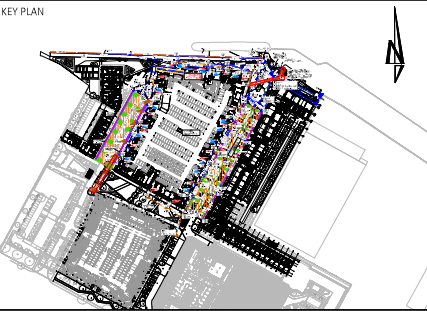

FOUL WATER SEWER

SURFACE WATER SEWER

FOUL WATER MANHOLE

FOUL WATER INSPECTION CHAMBER (PPIC)

SURFACE WATER MANHOLE

SURFACE WATER INSPECTION CHAMBER

SURFACE WATER CHANNEL (REFER TO DRAWING FOR TYPE)

PERMEABLE PAVING

RAIN GARDEN

100mm DIAMETER PERFORATED PIPE WITHIN RAIN GARDEN

Concrete rectangular manhole chamber 1200mm x 675mm

PERFORATED LAND DRAIN FOR CAR PARK SURFACE WATER

CONCRETE CHANNEL DRAIN, 150MM X 100MM (MARSHALLS OR SIMILAR PRODUCT). REFER TO SITE WIDE EXTERNAL DETAILS DRAWING FNF-C SITE-HYD-DR-02-0205. ASSOCIATE GULLIES TO BEEN 124, CLASS C250, 145MM, EJ PROPRIETARY GULLY (CODE D58) OR SIMILAR PRODUCT

FOUL WATER RISING MAIN

REVISIONS					
C19	Foul drainage run FMH13 to FMH-C-02 relocated				
	RS	01.02.24	GI	01.02.24	01.02.24
C18	Foul drainage run FMH13 to FMH-C-02 relocated. Storm drainage run SMH-X-01 to SMH-X-04 relocated.				
	GI	29.01.24	DB	29.01.24	29.01.24
C17	Landscape Architect site plan updated. New refuse area to have internal foul drain and downpipe connection. Pump chamber added to barge area				
	GI	18.01.2023	DB	18.01.2023	18.01.2023
C16	Foul drainage FMH08, 09, 10 updated				
	GI	23.03.2023	DB	23.03.2023	23.03.2023
C15	Foul drainage FMH08, 09, 10 & FMH-C-13 relocated to avoid existing utilities. Storm drainage arrangement SMH5.14, 21A, to 5.17 updated to reflect as built changes.				
	GI	22.03.2023	DB	22.03.2023	22.03.2023
C14	Foul and storm drainage updated on western side to avoid existing water main.				
	GI	17.02.2023	DB	16.02.2023	17.02.2023

Hydrock

 HAYES
Elmbridge Court
Gloucester
Gloucestershire
GL3 1JZ
t: +44 (0) 1452 783970
e: gloucester@hydrock.com

CLIENT

BARRATT LONDON

PROJECT

FORMER NESTLE SITE
HAYES

TITLE

DRAINAGE LAYOUT
BLOCK B
SHEET 1 OF 3

HYDROCK PROJECT NO. C-01669	SCALE @ A1 1:250
STATUS DESCRIPTION CONSTRUCTION (FULL APPROVAL)	STATUS A
DRAWING NO. (PROJECT CODE-ORIGINATOR-ZONE-LEVEL-TYPE-ROLE-NUMBER) FNF-C-B-HYD-DR-01-0200	REVISION C19

