


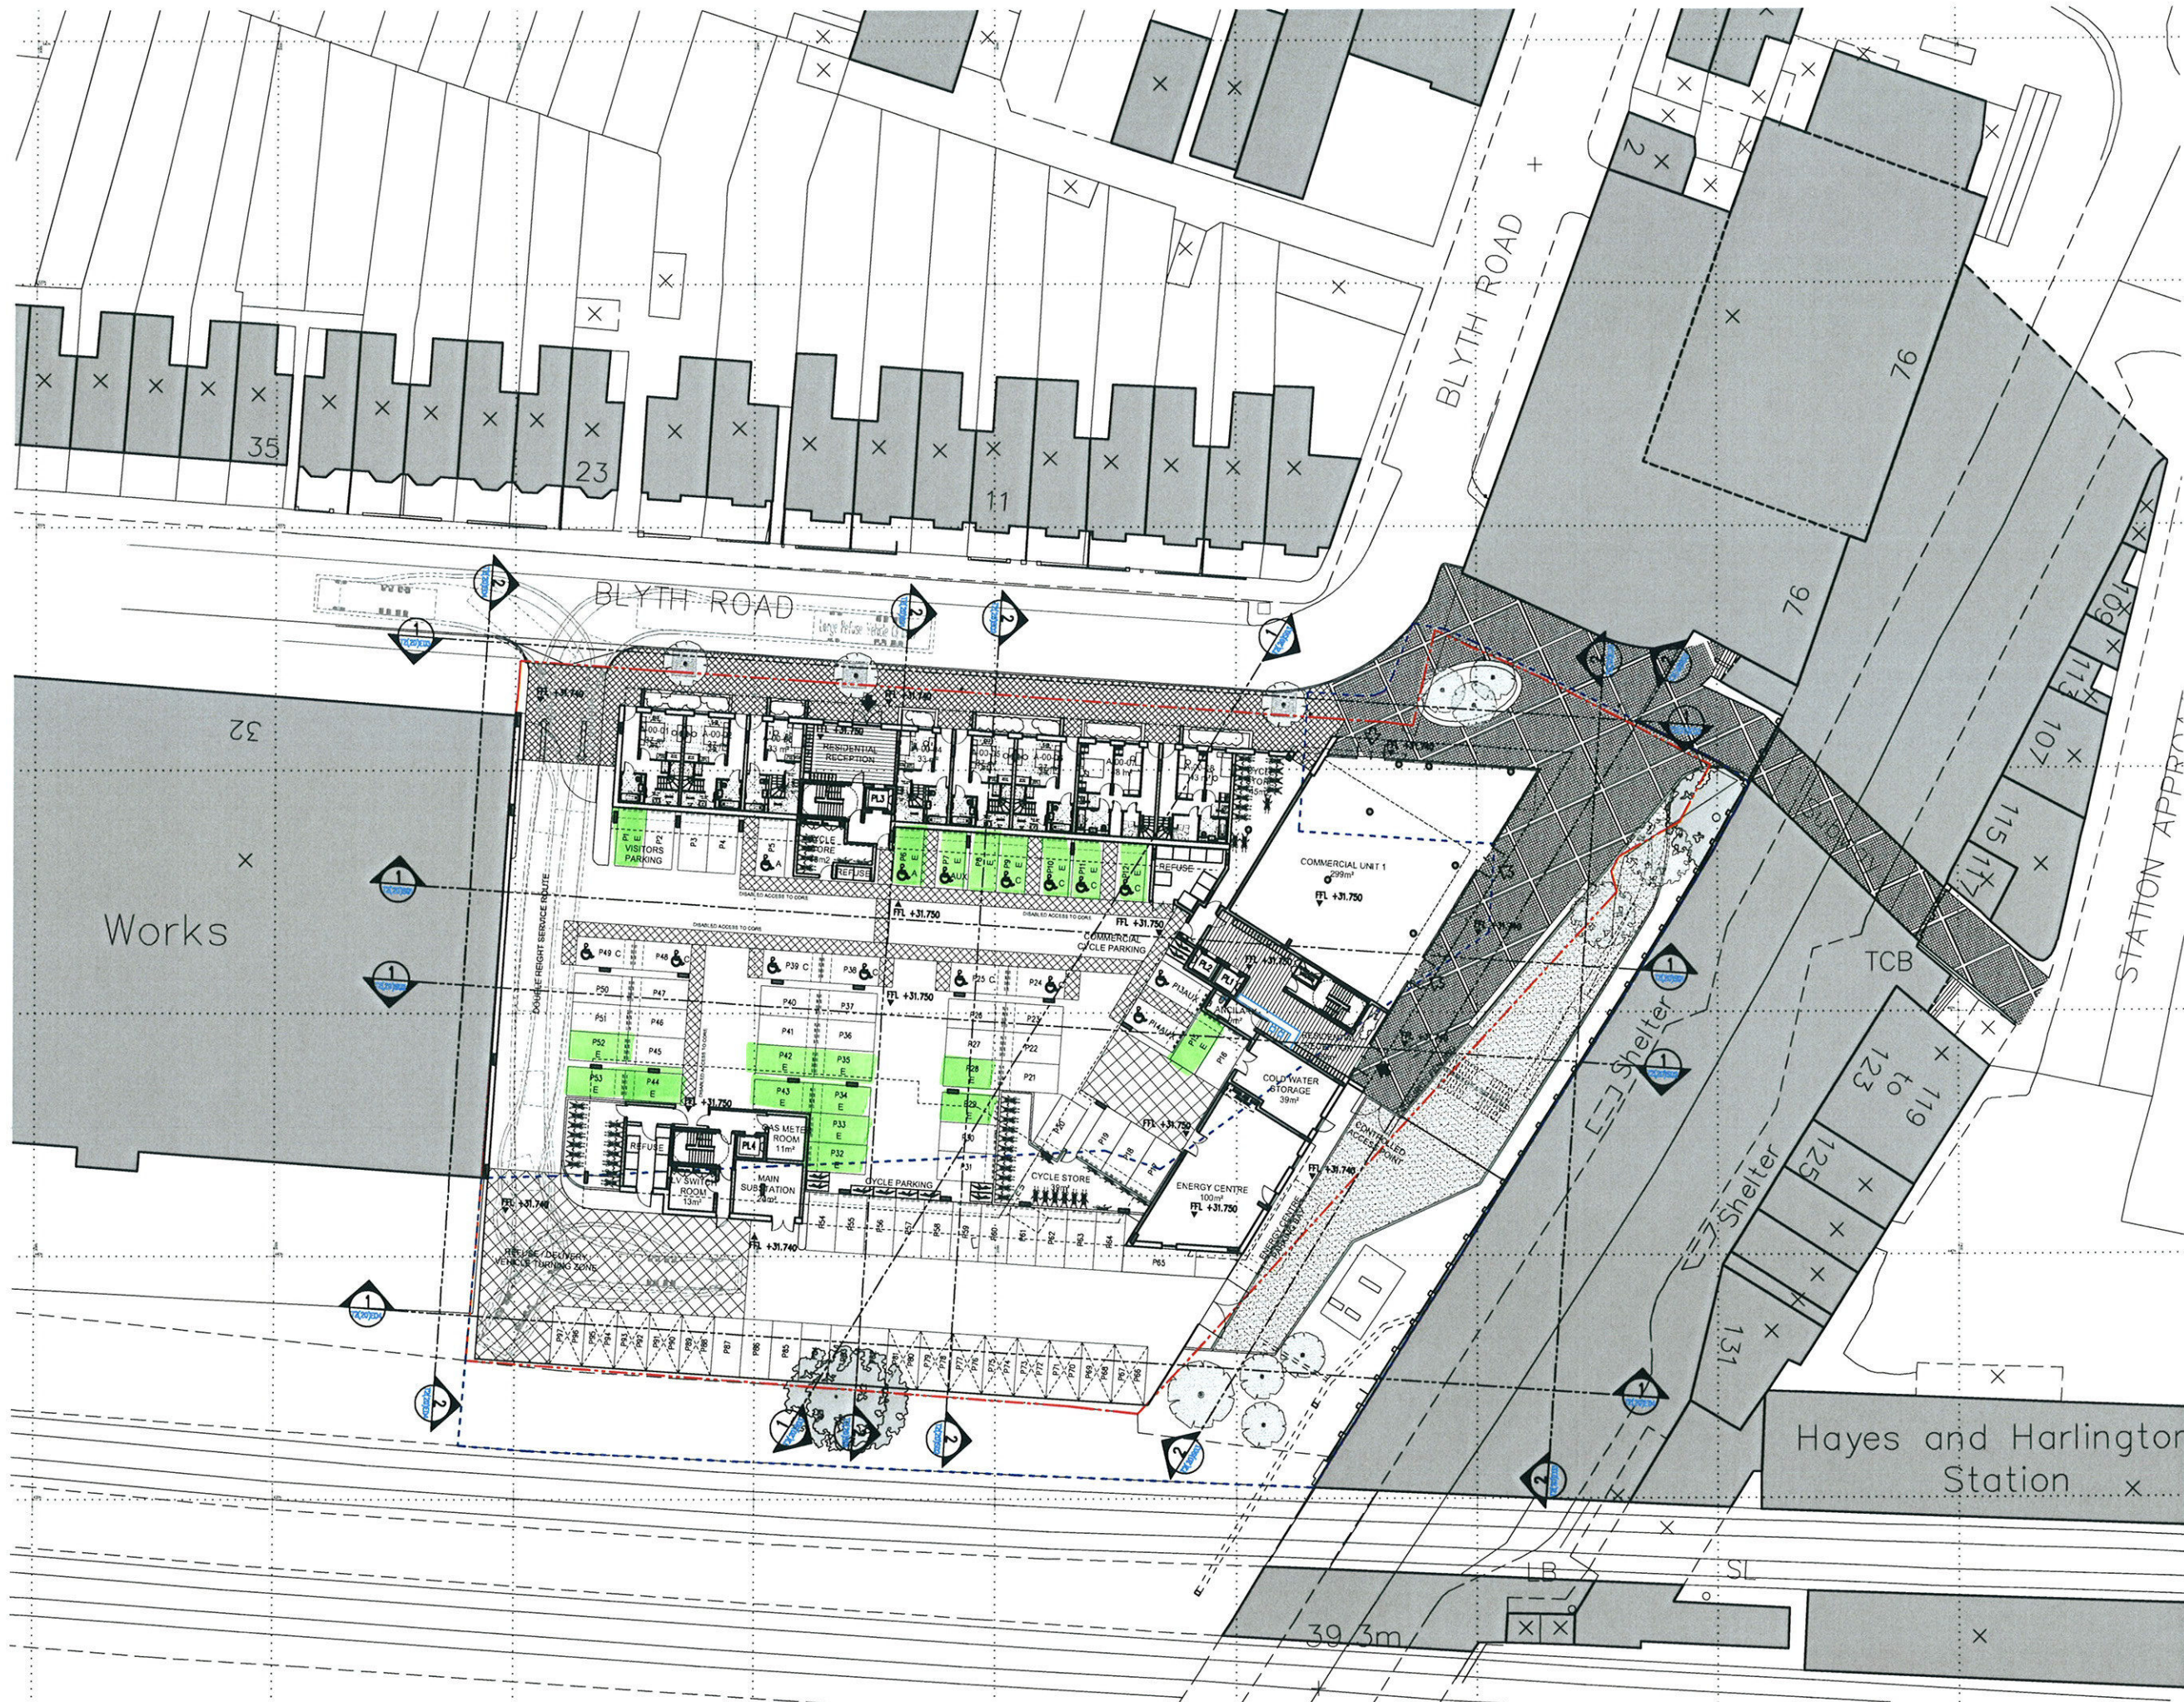

NOTES

- 1 The Contractor must check and confirm dimensions
- 2 All discrepancies must be reported and resolved by the Architect before works commence
- 3 This drawing is not to be scaled
- 4 All work and materials to be in accordance with current applicable Statutory Legislation and to comply with all relevant Codes of Practice and British Standards.

--- APPROXIMATE SITE BOUNDARY
--- NETWORK RAIL SAFEGUARDED AREA

CAR PARK PROVISION

PARKING BAYS	- 82
WHEELCHAIR ACCESSIBLE BAYS	- 15
IN TOTAL	- 97

NUMBER OF CYCLE SPACES

RESIDENTS	-179
COMMERCIAL	- 9
IN TOTAL	-188

LEGEND

- P56 PARKING BAY WITH SOFFIT MOUNTED CYCLE HANGER (1 CYCLE) - 64 SPACES
- P58/P57 DOUBLE PARKING BAY LIFTING PLATFORM - 13x2 SPACES
- P24/E PARKING BAY FOR ELECTRIC VEHICLES - 20 SPACES (20% OF TOTAL NUMBER)
- P59 PARKING BAY WITH FLOOR MOUNTED CYCLE RACK (2 CYCLES) - 98 SPACES
- P60 PARKING BAY WITH FLOOR MOUNTED CYCLE HANGERS (2 CYCLES STACKING) - 16 SPACES
- P61 CYCLE LOCKER (FRONT ACCESS) - 6 SPACES
- P62 CYCLE LOCKER (SIDE ACCESS) - 4 SPACES

P3 REVISED STREET TREE PLANTING
P2 REVISED PLANNING SUBMISSION
P1 REVISED PLANNING SUBMISSION
P PLANNING ISSUE

05/09/12
17/08/12
15/08/12
06/12/11

Rev _____ Date _____

CONDITION 7

ITEM 2D

Client
DOMAINE DEVELOPMENTS Ltd

Project
BLYTH ROAD

Drawing
GROUND FLOOR PLAN

Scale	Date	Drawn
1:250 (A1)	SEP 11	MB
Drawing No		Revision
4710 / T2(20)P00		P3
CAD Ref No		
Q:\4710\T2_Series\T2_20\T2_20P00		

This scale is 100mm in length when printed of the size indicated in the title block.