


- General Notes :
1. To be read in conjunction with other consultants drawings.
  2. Check site conditions prior to commencement of work.
  3. Any discrepancies to be reported directly to the Architect.
  4. Do not scale off drawing. Use figured dimensions only.
  5. All dimensions for existing buildings and openings to be checked on site.

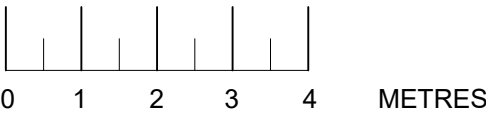

Proposed non-material  
amendments marked in red

Approved window position  
marked in blue

## NON MATERIAL AMENDMENTS

| Revision | Amendment | Date |
|----------|-----------|------|
|          |           |      |

**AA+D**  
Atelier Architecture + Design Ltd

Akeman Business Park, 72 - 80 Akeman Street  
Tring, Herts. HP23 6AF  
T: 01442 828201 E: info@atelier-architects.co.uk  
www.atelier-architects.co.uk

Project:  
New Almhouses, UUWT New Build Ltd  
Woodbridge House, New Windsor Street, Uxbridge  
Greater London, UB8 2TY

Drawing title:  
Ground Floor Plan

Scale: 1:100 @ A1

Date: 21.04.21

Drawing No:  
447 / NMA2 / 001

Rev:

copyright reserved