
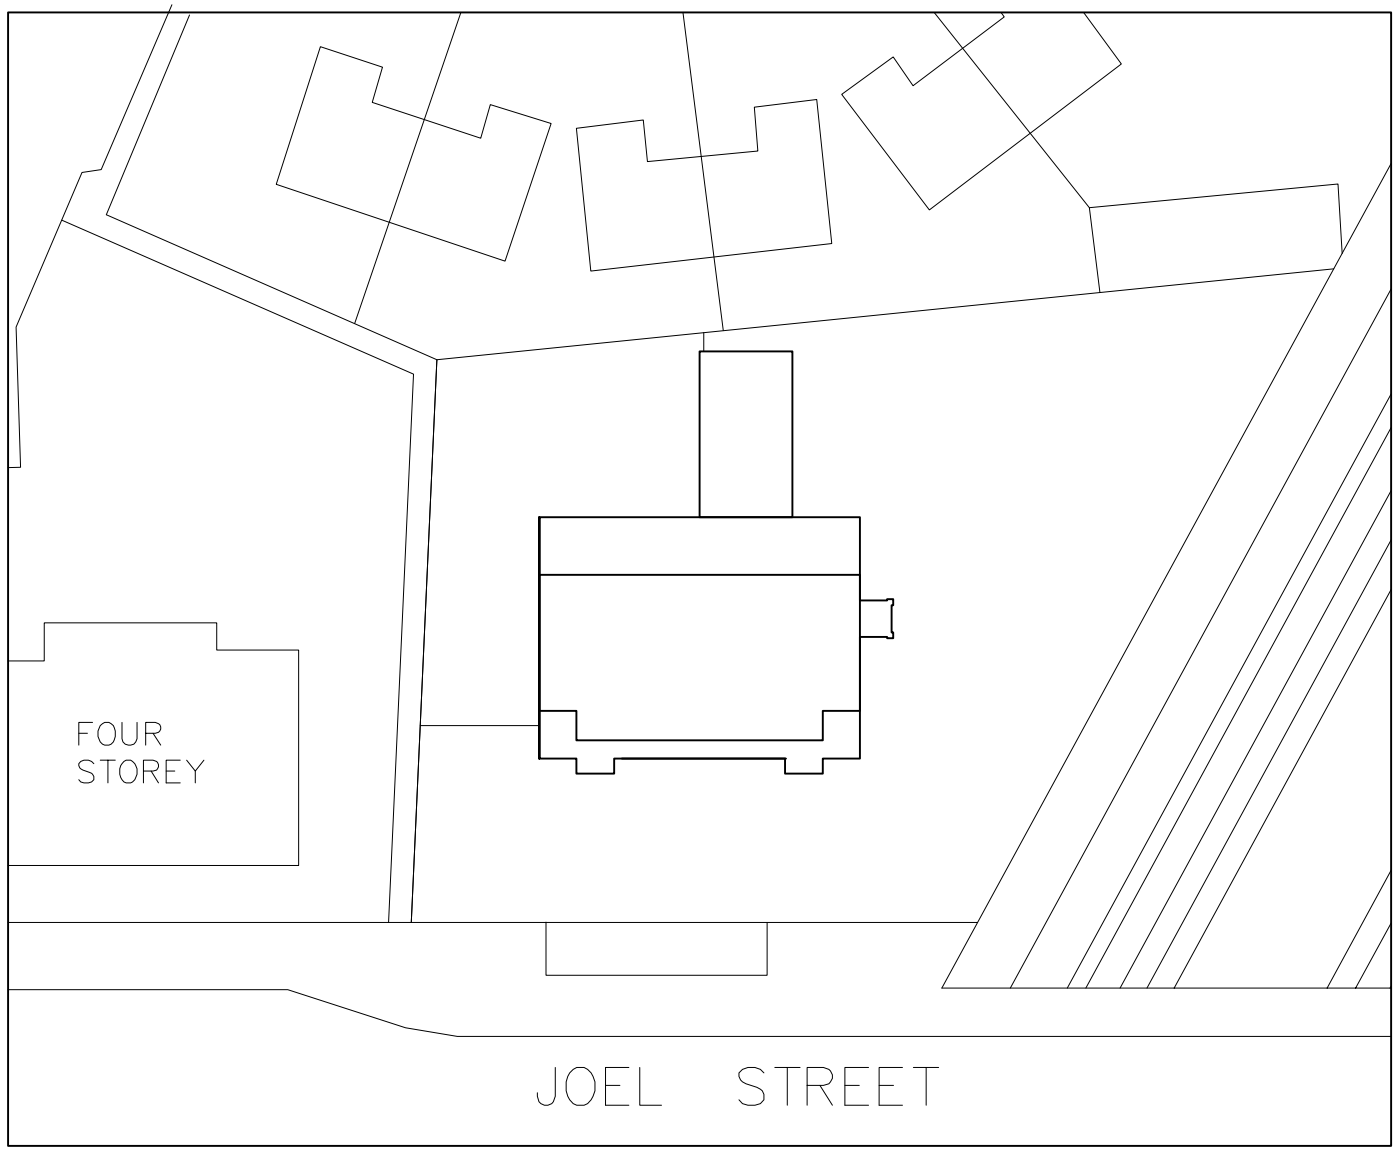


Existing Site Plan 1M 5M 10M

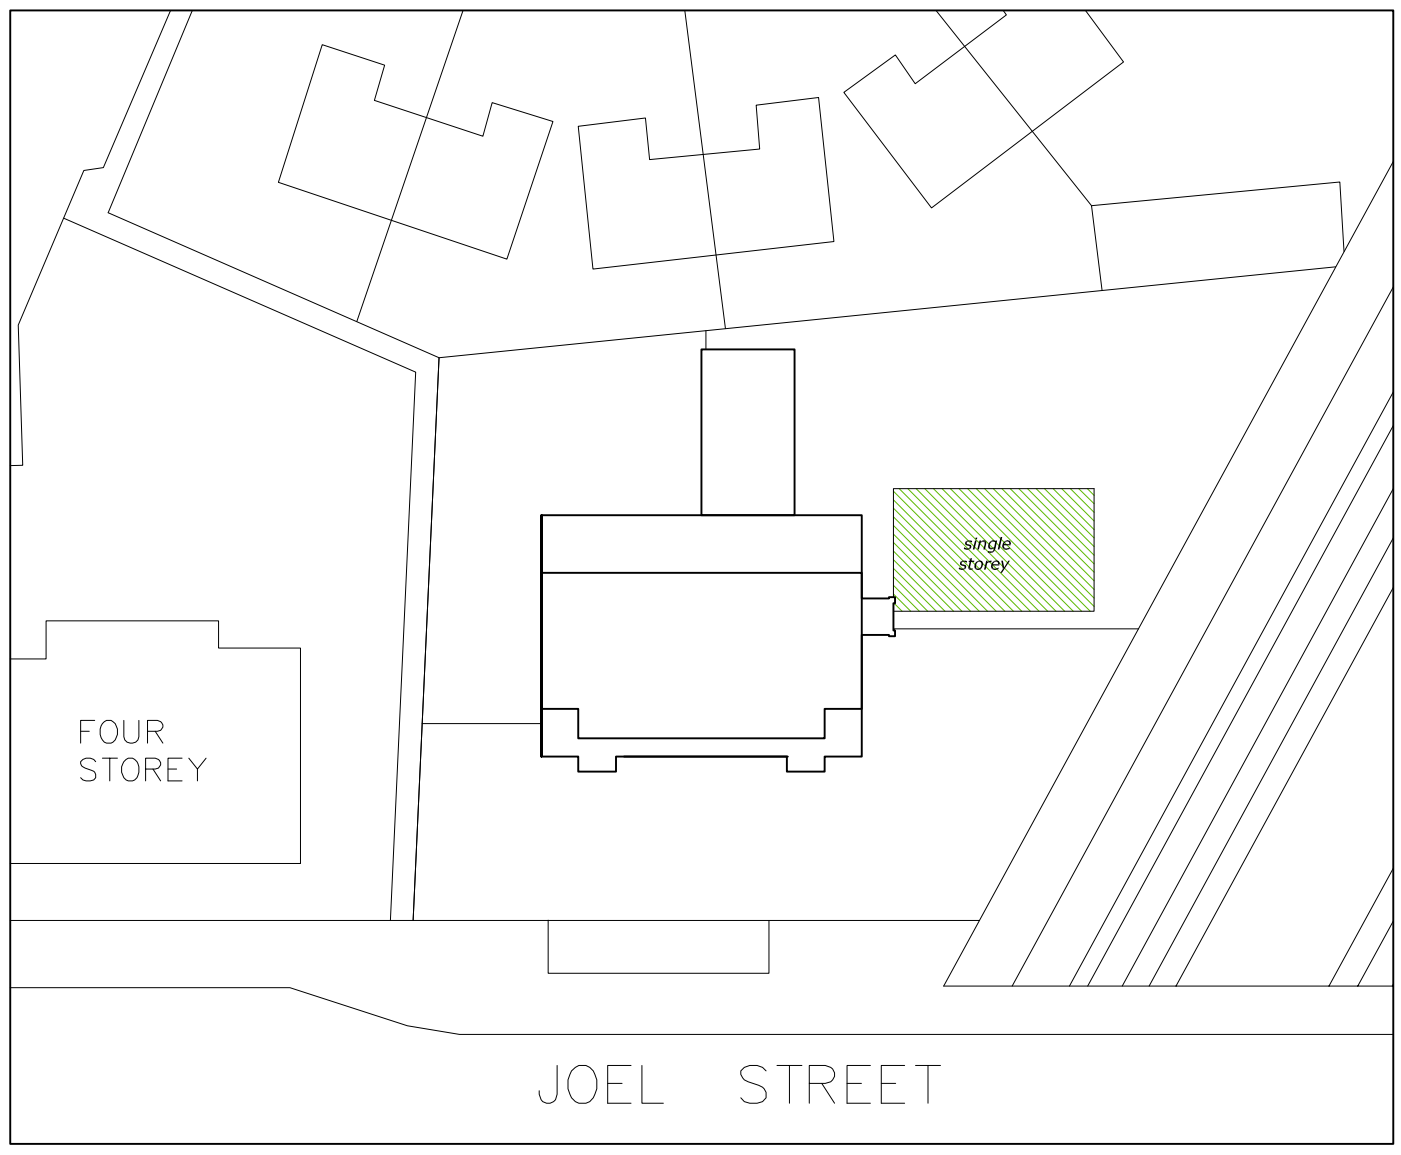

Proposed Site Plan 1M 5M 10M

PROJECT	DWG NO.	SCALE	DETAIL	09.02.2015	A	B	C	D	E	PROJECT NO.
NAMASTE LOUNGE, JOEL STREET, NORTHWOOD HILLS **AS BUILT OUTDOOR SMOKING LOUNGE**	01	1:500 @ A3	EXISTING AND PROPOSED SITE PLANS	ISSUED TO PLANNING DEPT. HILLINGDON						15.05

PR Architecture ltd.
Chartered Architect
120, Pinner Road, Harrow, HA1 4JD.
Tel: 0208 357 2304