



House boundary (7616f)

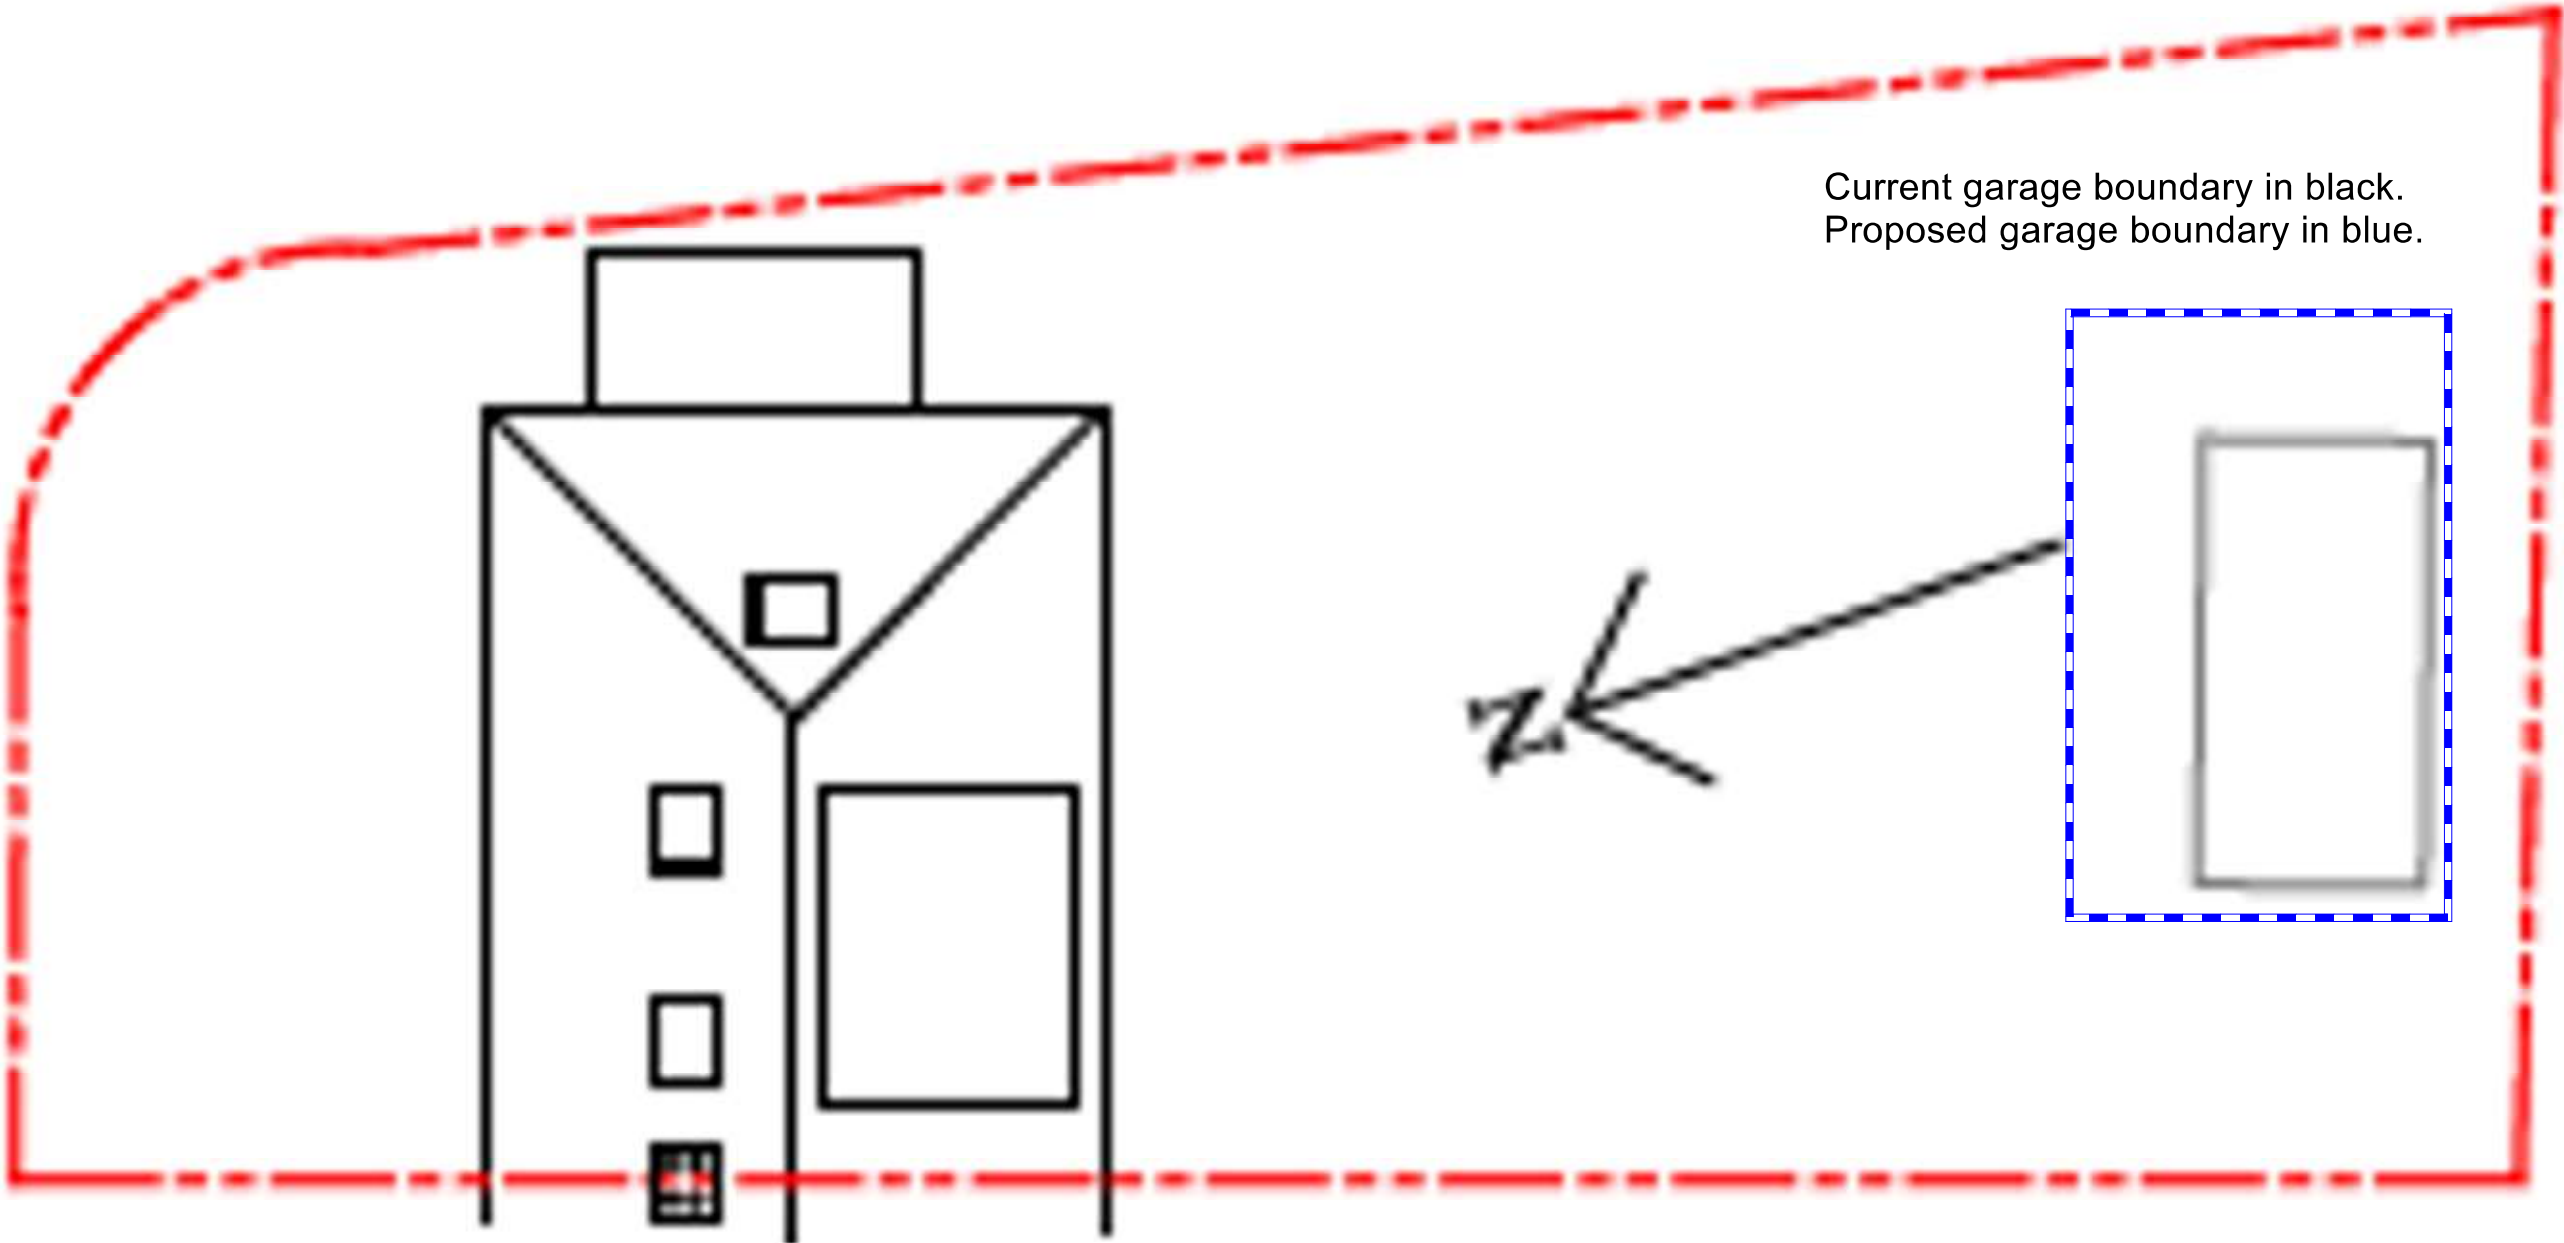

Property boundary line shown in red.

Guidance

Diagrams are in millimetres, scaled @ A3.
Proposals in line with national and local guidance.
Outbuilding set in from all boundaries by at least 500mm.
The area is not within a conservation area.
Windows and doors will be double glazed UPVC.

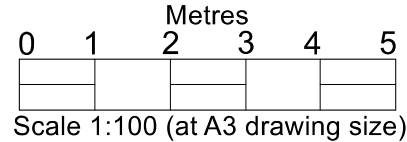

Title: House boundary

Drawing number: 7616f

Scale: 1:100 at A3

Property: 16 The Paddock, Ickenham, UB10 8RB

Client: Sarah & Ben Pittaway

Date: March 2024