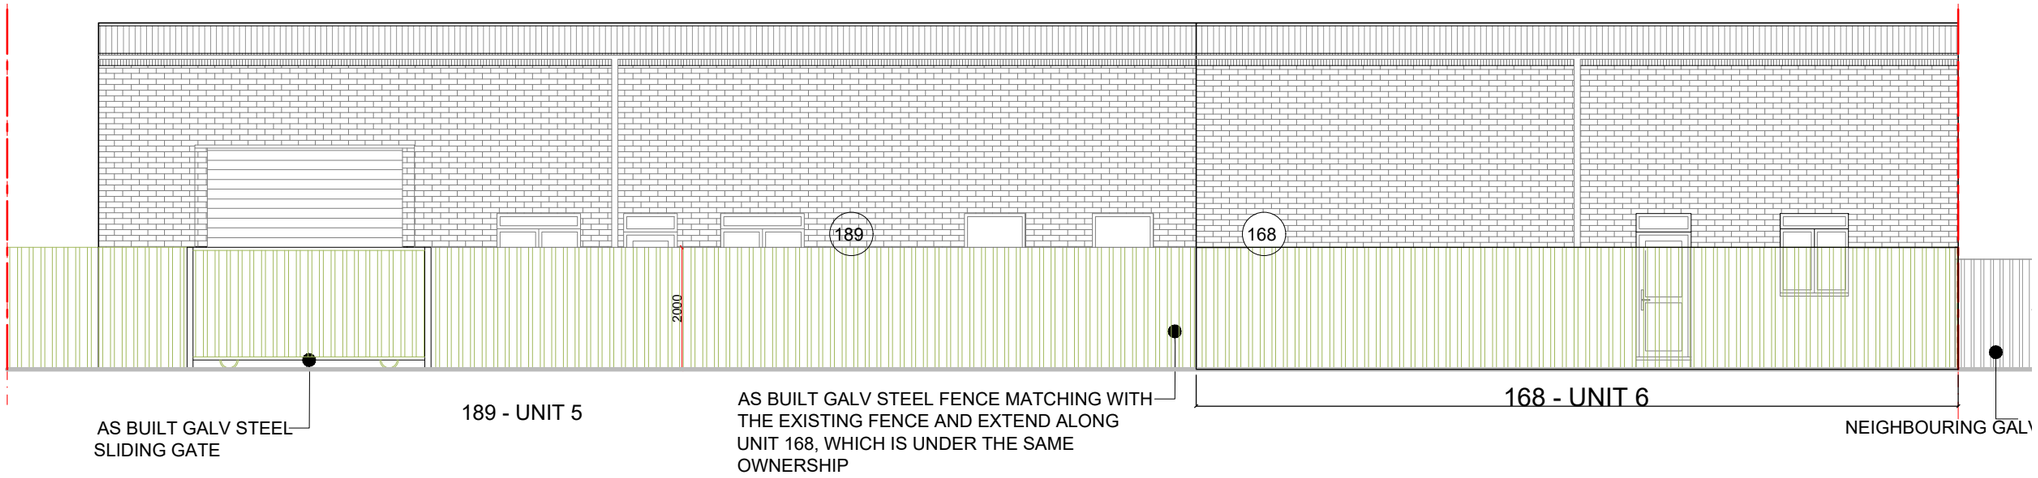

AS BUILT FRONT GATE AND BOUNDARY FENCE ELEVATION

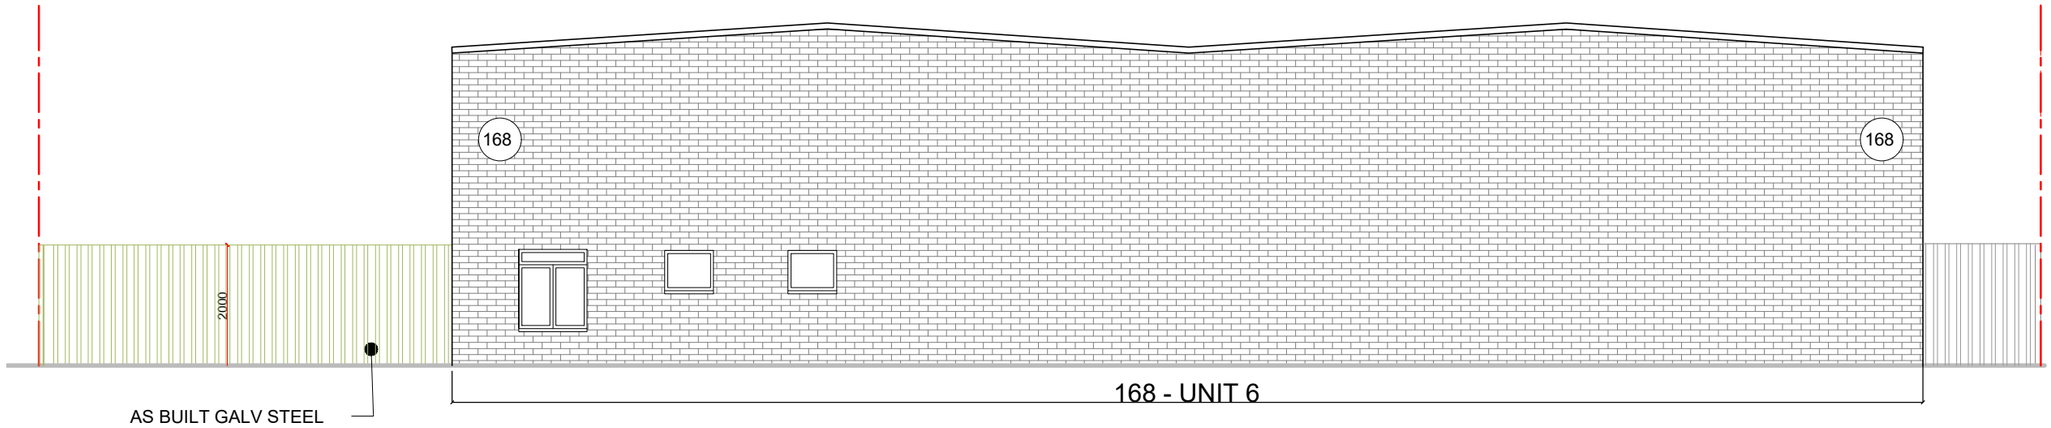

AS BUILT RHS SIDE ELEVATION (BOUNDARY FENCE)

EXISTING FENCE

AS BUILT FENCE

BOUNDARY LINE

EXISTING TIMBER FENCE

0m 1m 2m 3m 4m 5m

SCALE @ 1:100

NOTES :

Date	Revisions

SJR DESIGN LTD.
(ARCHITECTURAL DESIGN & CONSTRUCTION)

Client: MR. MHD SHAHER AL SADAT

Job Title

168, UNIT 6 PASADENA CLOSE
HAYES
UB3 3NQ

Drawing Title

AS BUILT FRONT AND SIDE ELEVATIONS-
BOUNDARY FENCE

Scale: 1 : 100 (A3)

Date: JULY 2026

Checked by: | Drawn by: RS

Drg No. TP/764/10

Rev.