


EXISTING SITE PLAN

PROPOSED SITE PLAN

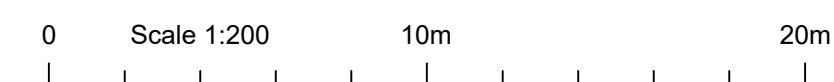

Amendments/Notes			
Rev.	Detail	By	Date
A	Minor amendments	AW	30.07.25
B	General amendments	CV	06.11.25
C	Front hardstand removed	CV	06.11.25
D	General updates	CV	12.01.26
H	Note to grass added	CV	24.02.26
I	Front grass reinstated	CV	03.03.26
G	S73_MMA Increase rear extension on 250mm	LL	02.04.26

KEY	
	Removed
	Existing wall
	Proposed/New
	Approved APP 2026/109

SITE AREA RED LINE - 1272 m2

NORTH

All dimensions and levels to be checked on site by contractor prior to preparation of shop drawings and commencement of work on site.
 This drawing and the copyrights and patents therein are the property of the Architect and may not be used or reproduced without consent.
 This drawing is to be read in conjunction with all relevant consultants and/or specialist's drawings/documents and any discrepancies or variations are to be notified to the Architect before the affected work commences.
 All works on site are to be carried out fully in accordance with current CDM regulations and recommendations, current Building Regulations, British Standards and Codes of Practice as appropriate.

Project	5 THE COVERT NORTHWOOD HA6 2UD		
Drawing	EXISTING AND PROPOSED SITE PLAN S73_MMA		
SEABROOK ARCHITECTS CHARTERED ARCHITECTS			
<small>Unit17, Chiltern Court, Ashridge Road, Chesham, Bucks, HP5 2PX Tel: 01494 778918 e-mail: info@gsarchitects.co.uk</small>			
Drawn By	AW	Date	07.07.25
Checked By	Checked by	Date	02.04.2026
Approved By	Approved	Scale	1:200@A1
Drawing No.	4629-PL001	Rev.	G