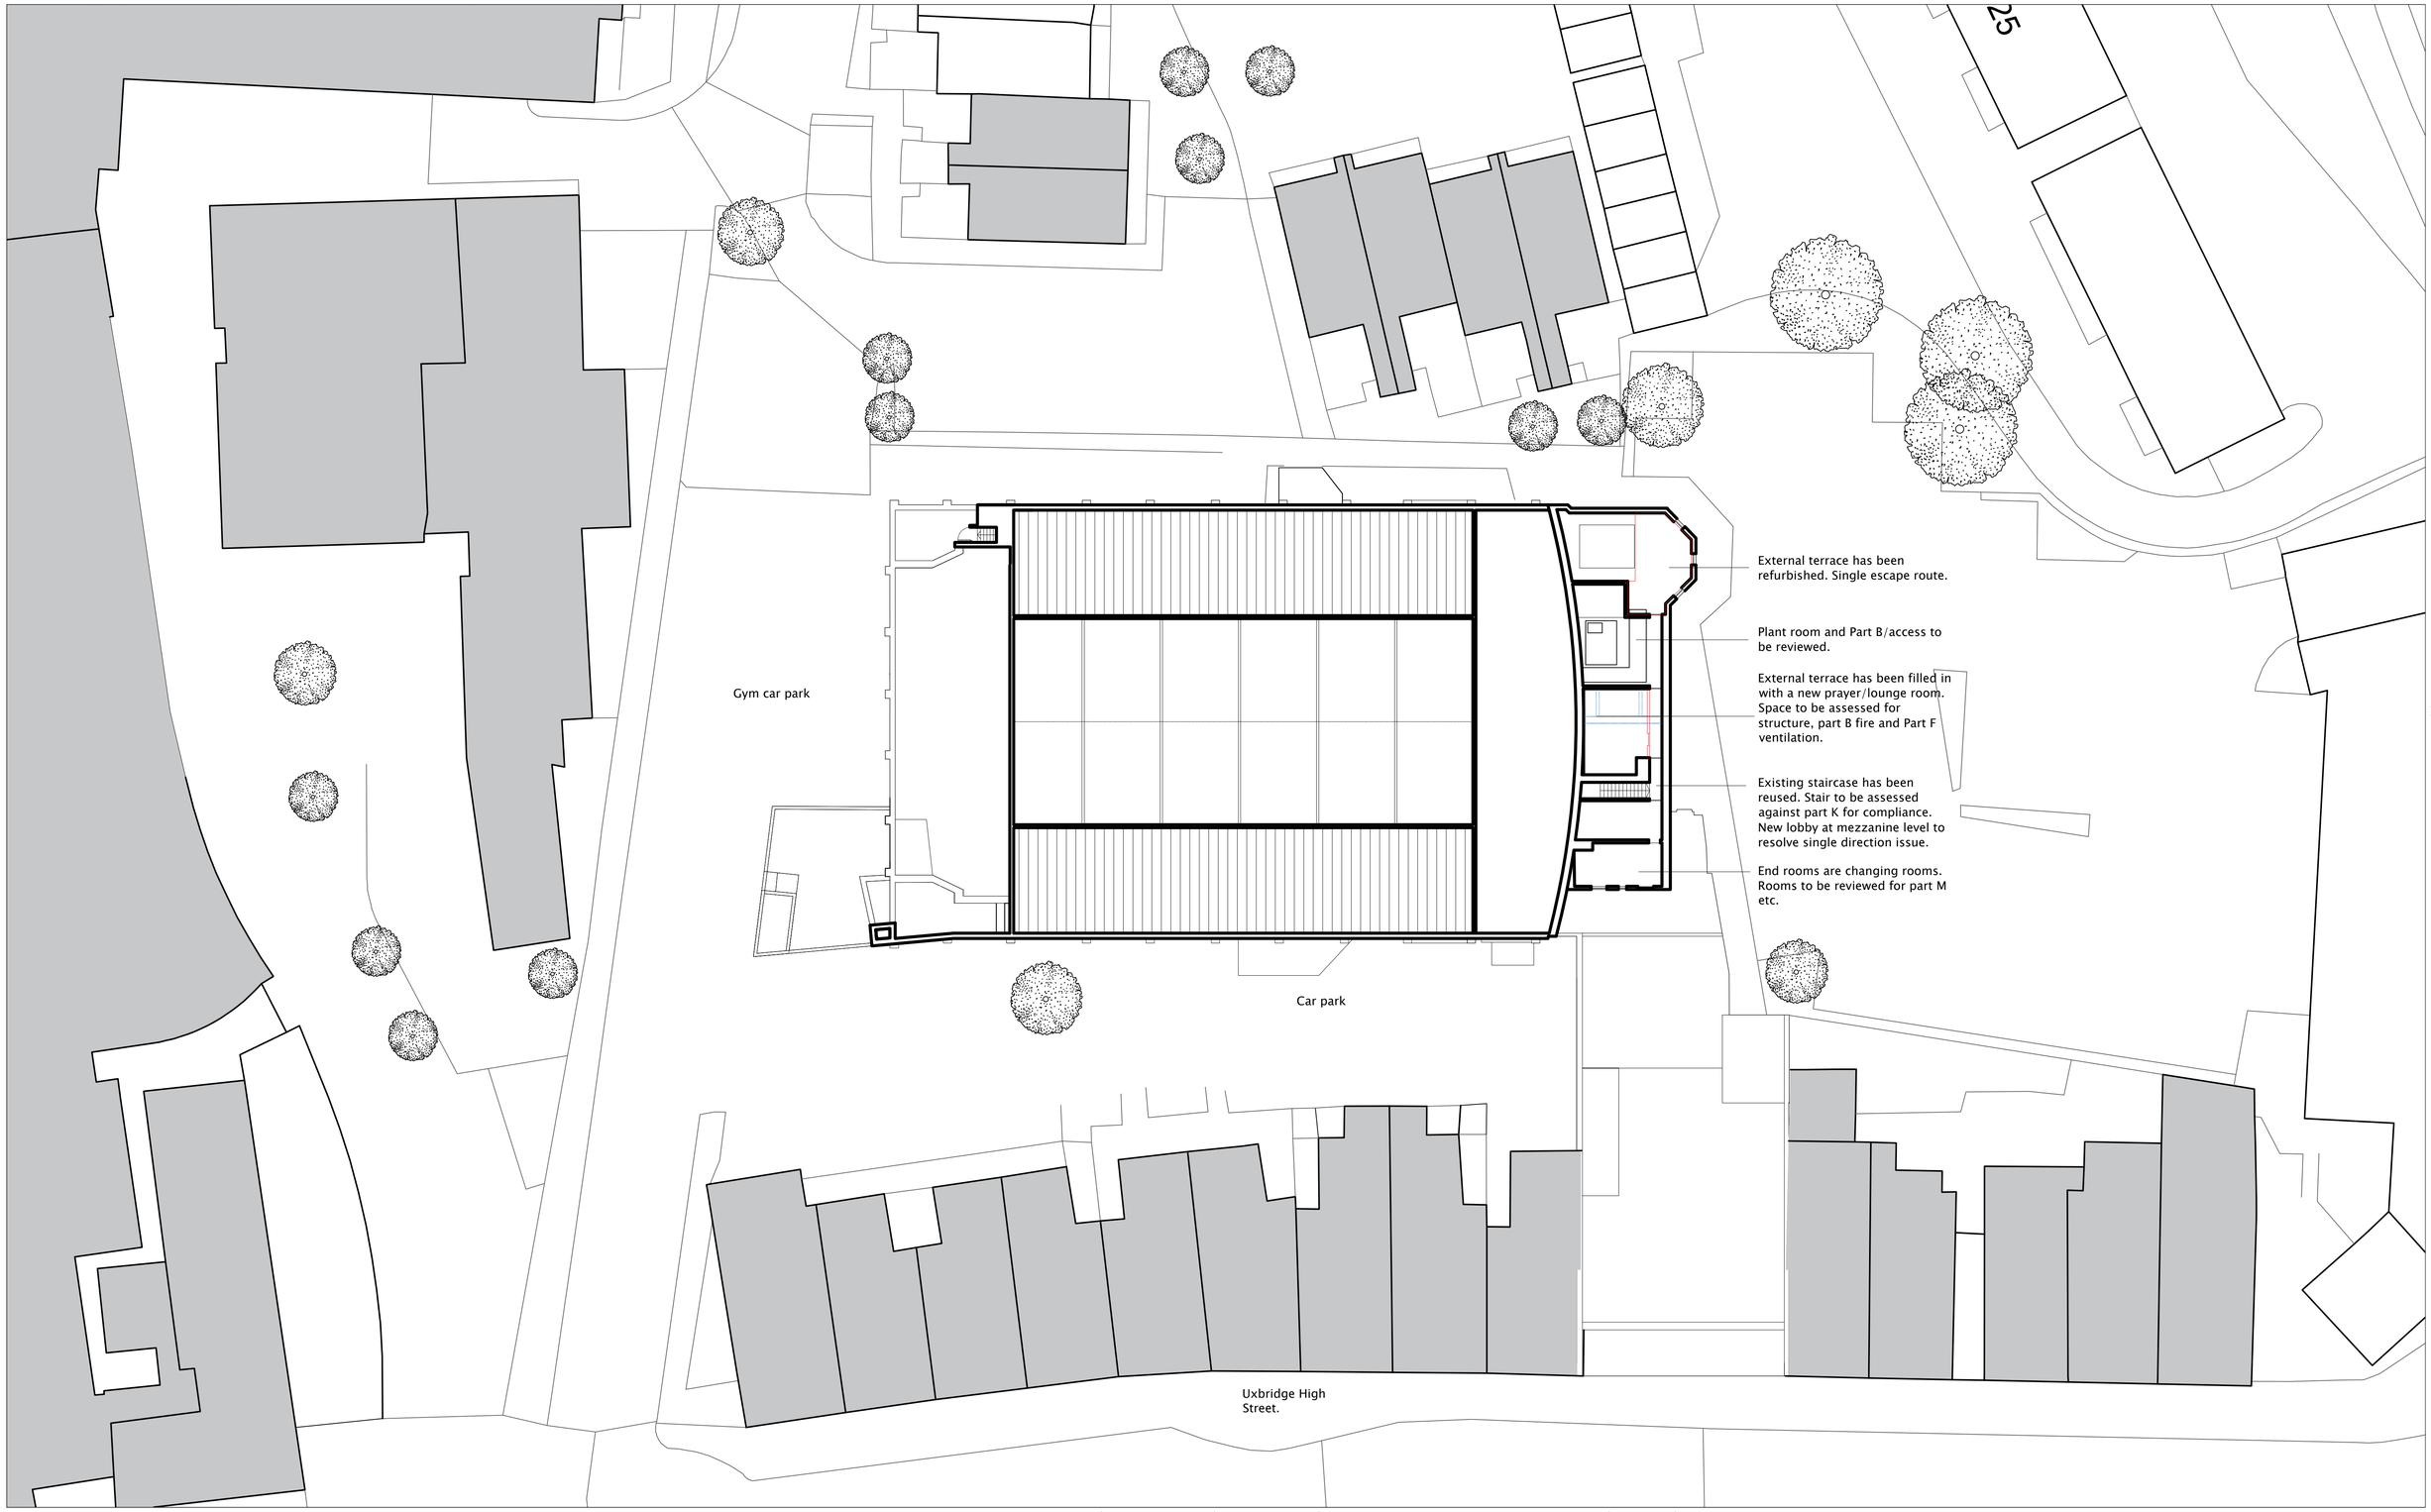

Nick Willson Architects
Second Home
68 Hanbury Street
London
E1 5JL
www.nickwillsonarchitects. com

Notes:

All dimensions to be confirmed by contractor on site.

Scale 1:200

0 4 8 20 40m

N

Rev	Date	Description	By	Ck

Project	Project description	Scale	Job No
233 High Street, Uxbridge, London, UB8 1LD	New hotel and banqueting hall	1:200@A1	0242
Title	**Stage**	**Drawing No**	**Rev**
As built Third floor Plan	Building control application	A304	–