

NOTES:

SUBJECT TO STATUTORY CONSENTS



BASED ON GREENWATCH SURVEY
REF: 3360.1 REV 0
DATED: 24.06.19

BASED ON OS MAP REPRODUCED BY PERMISSION OF
CONTROLLER OF HM STATIONARY OFFICE IN DROWN
COPYRIGHT

COPYRIGHT RESERVED

DO NOT USE ELECTRONIC VERSIONS OF THIS DRAWING TO
DETERMINE DIMENSIONS UNLESS SPECIFICALLY
AUTHORISED BY MICHAEL SPARKS ASSOCIATES

IF USING AN ELECTRONIC VERSION OF THIS DRAWING
FIGURED DIMENSIONS TAKE PRECEDENCE AND NOTIFY
MICHAEL SPARKS ASSOCIATES OF ANY DISCREPANCIES

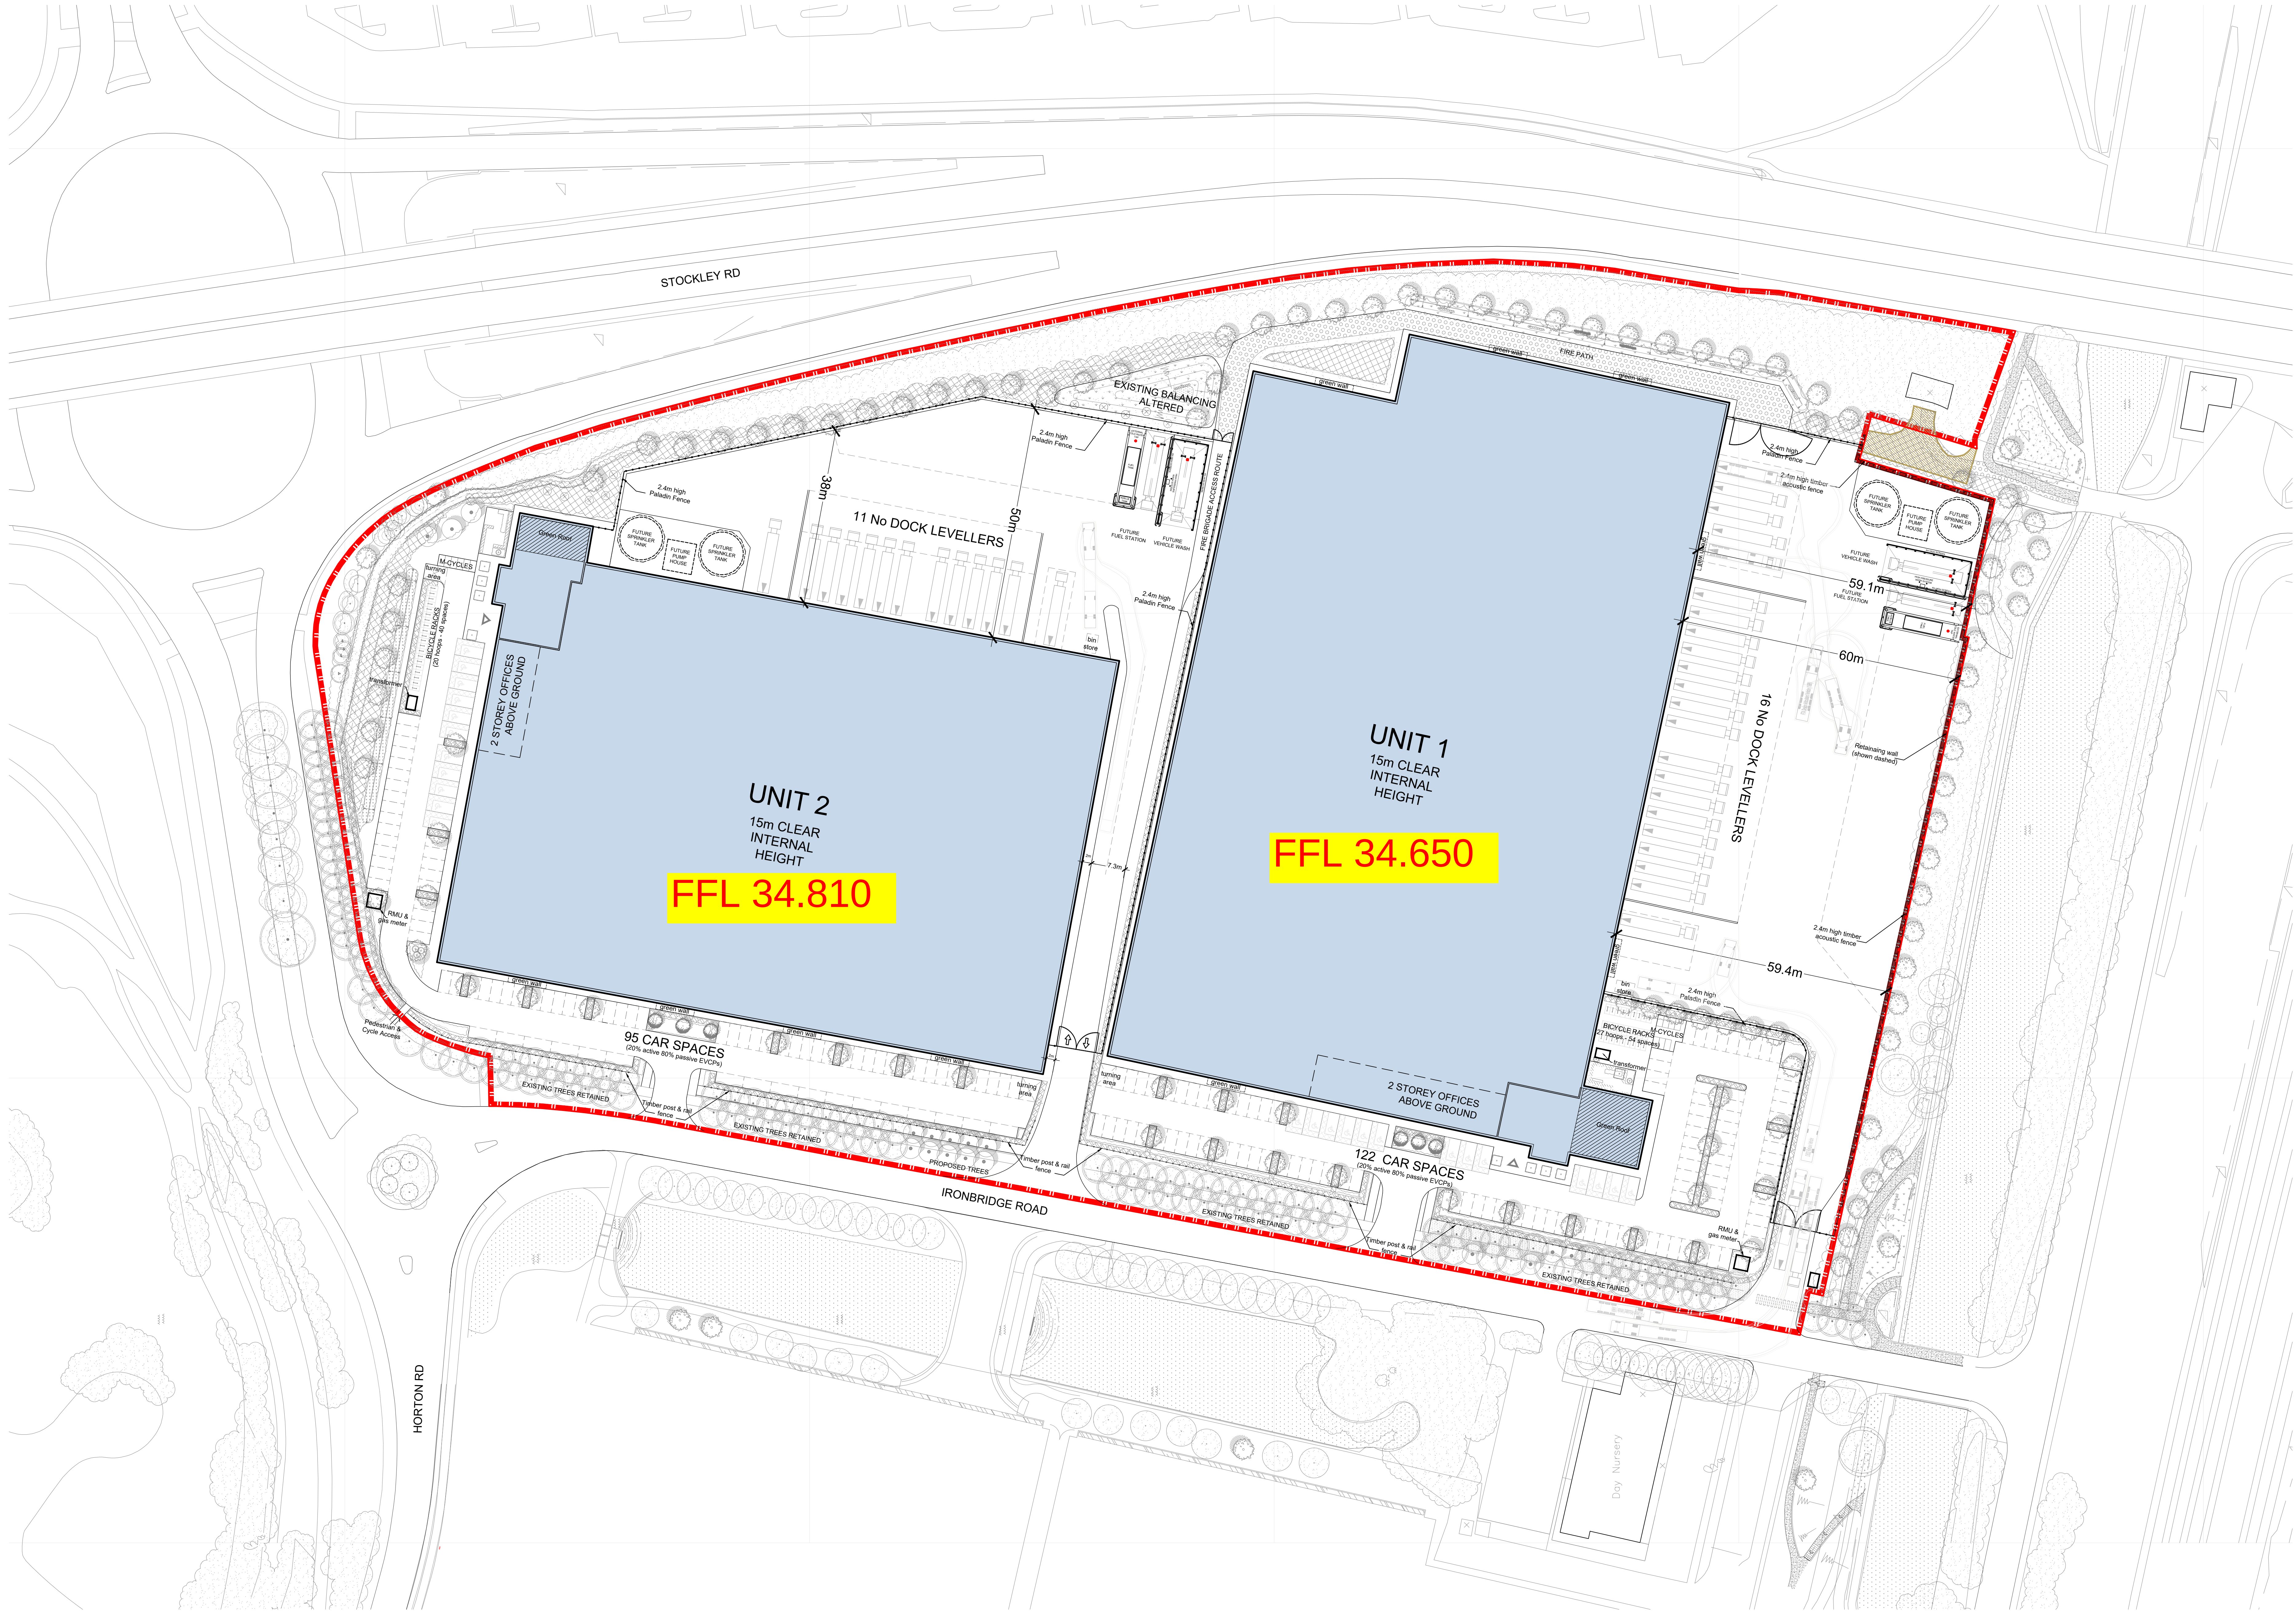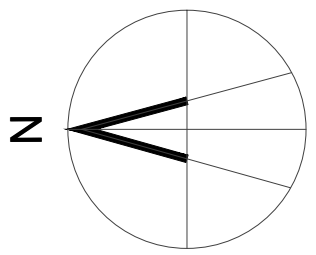

SKETCH

A	10.03.22	Transformer, RMU & Gas meter locations amended; Southern boundary treatment in oblique; Unit 1 motorcycle & cycle parking reconfigured; Unit 1 fire access gate added.	mk	sd
—	15.02.22	First issue.	mk	sd
REV	DATE	NOTE	DRAW	CHK



CHARTERED ARCHITECTS
11 PLATO PLACE
ST DUNSTON ROAD
LONDON E16 4TL
TELEPHONE: 020 7736 4162
WWW.MSA-ARCHITECTS.CO.UK

TITLE
PPWL EXPANSION SITE
DRAWING
SITE LAYOUT PLAN

CLIENT
PROLOGIS UK LTD.

DATE FEB 2022	SCALE 1:500 @ A0	DRAWN MK
MSA NUMBER 30928	STATUS SKETCH	CHECKED SD
DRAWING NUMBER 30928-SK-004	REVISION A	

01
004

SITE LAYOUT
1:500

0 5 10 20 50m