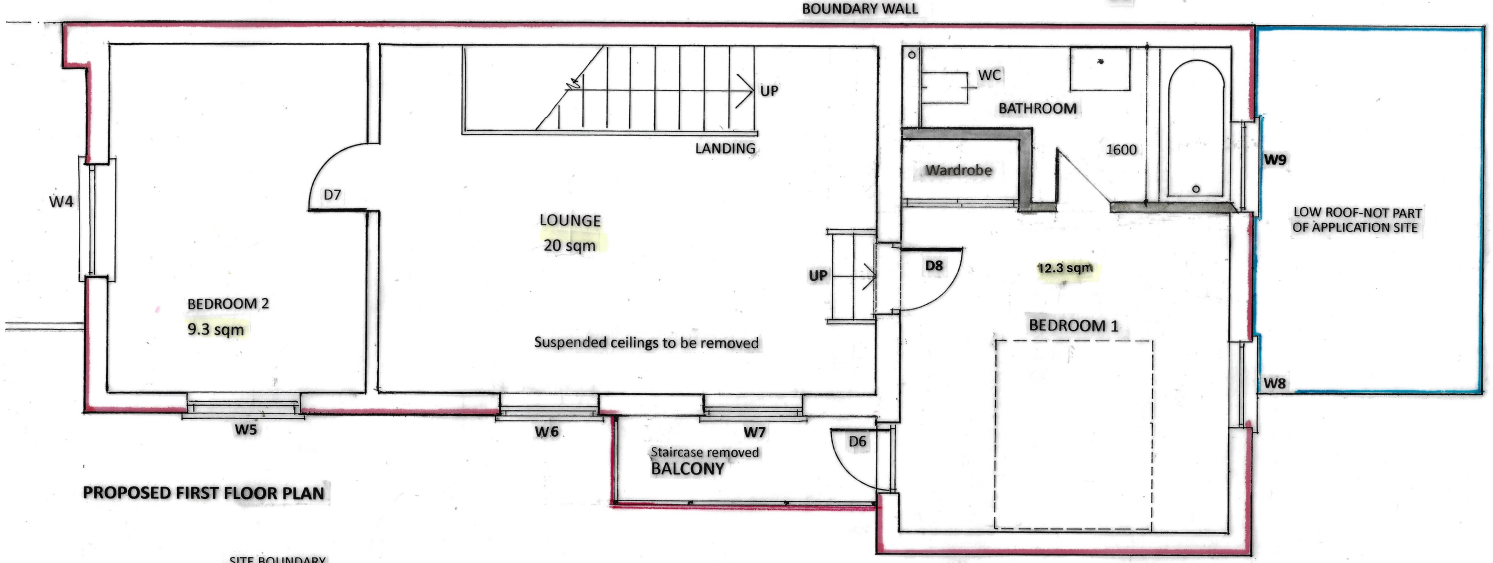

PROPOSED FIRST FLOOR PLAN

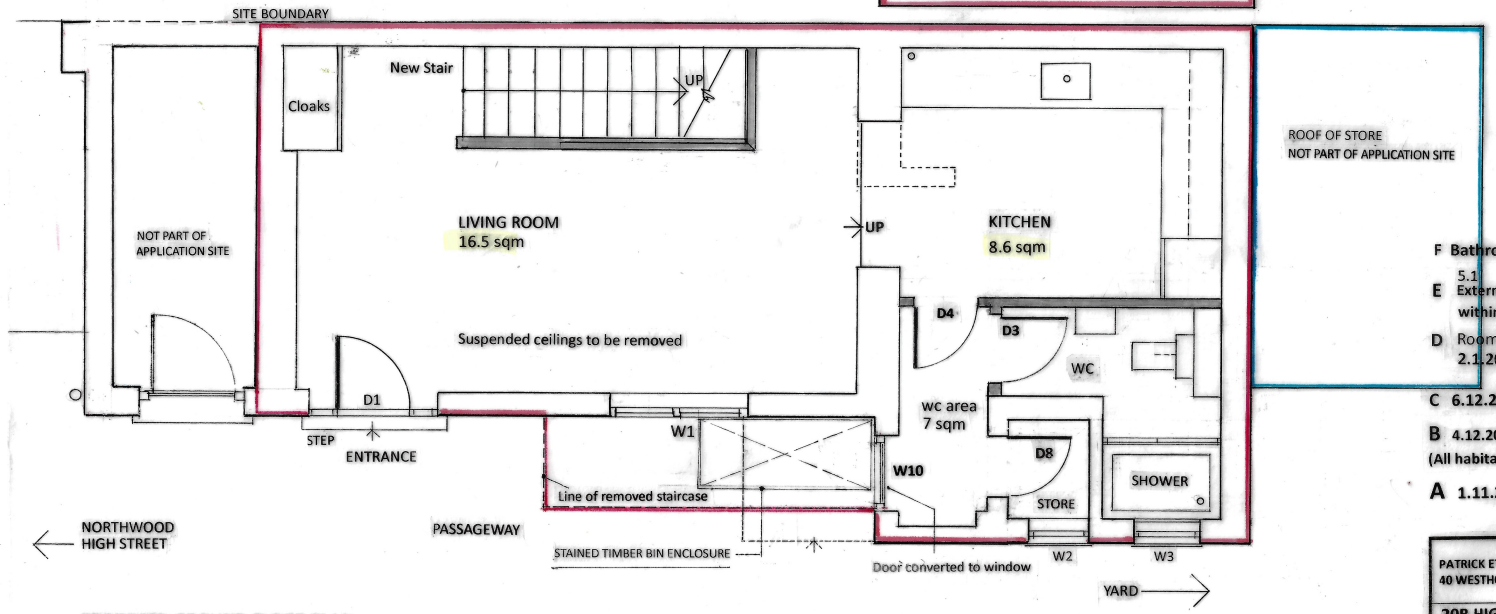

PROPOSED GROUND FLOOR PLAN

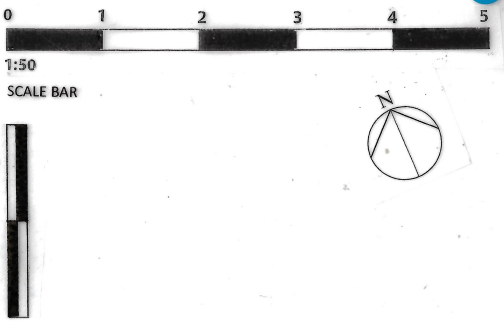

F Bathroom area reduced. Bath length revised to 1600mm
5.1

E External staircase shown within red line boundary

D Room floor areas added
2.1.2026

TOTAL INTERNAL SQM =75.6 sqm

C 6.12.2025 Store room indicated 'NOT PART OF APPLICATION SITE'

B 4.12.2025 Additional SQM. floor areas added to proposed plans (All habitable rooms and other spaces)

A 1.11.2025 Room areas and total internal floor area added (including balcony)

PATRICK ETTWEIN DipArch RIBA FRSA 07957 370435 020 8455 8953 40 WESTHOLM LONDON NW 11 6LH ettweinp@gmail.com	CODE	DWG NO. NW 02 F
20B HIGH STREET NORTHWOOD HA6 1BN PROPOSED CHANGE OF USE & ALTERATIONS.	REV	
PROPOSED GROUND FLOOR PLAN PROPOSED FIRST FLOOR PLAN		
Do not scale from this drawing. This drawing is the copyright of Patrick Ettwein	SCALE	1:50 @A3
PLANNING APPLICATION	DATE	SEPT 2024
NOT FOR CONSTRUCTION	STATUS	PLANNING