SCALE BAR 1:100 0 1m 2 3 4 5 6 7 8 9 10m

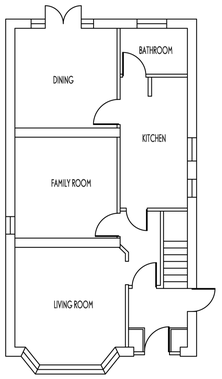

Pre existing ground floor plan 1.100

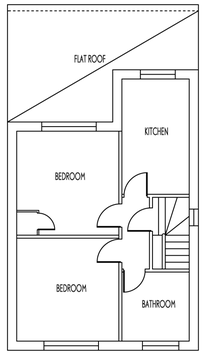

Pre existing first floor plan 1.100

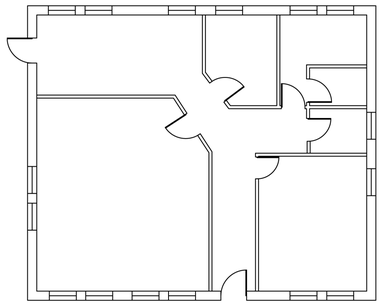

Pre existing outhouse plan 1.100

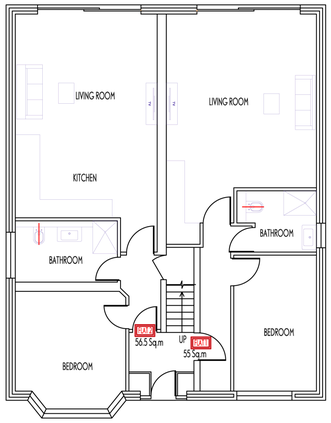

As Approved ground floor plan 1.100

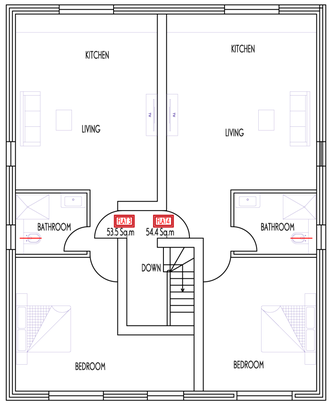

As approved first floor plan 1.100

SCALE BAR 1:200 0 2m 4 6 8 10 12 14 16 18 20m

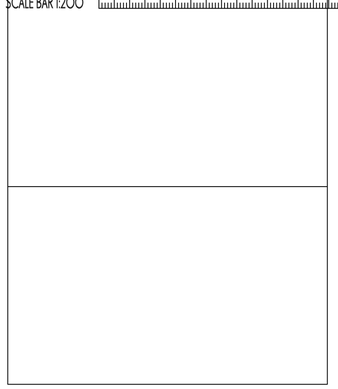

As Approved roof plan 1.100

Pre existing front elevation 1.100

Pre existing rear elevation 1.100

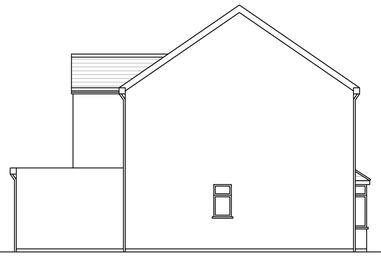

Pre existing side elevation 1.100

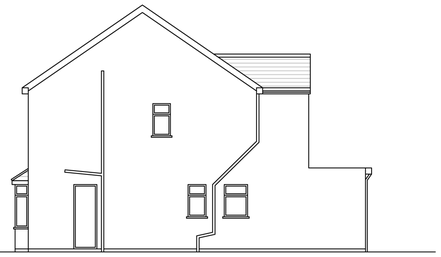

Pre existing side elevation 1.100

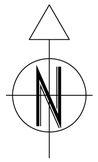

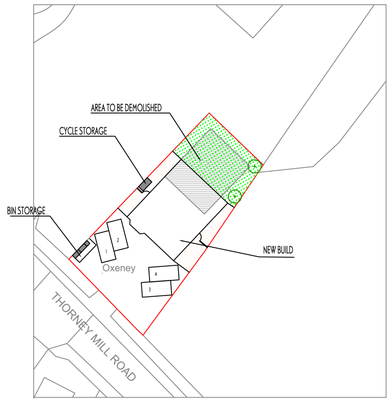

SITE PLAN 1:500
as approved

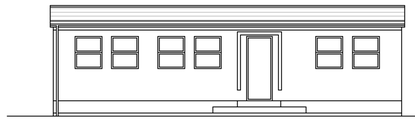

Pre existing front elevation 1.100

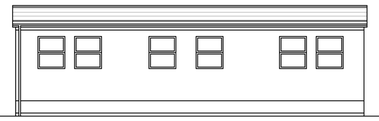

Pre existing rear elevation 1.100

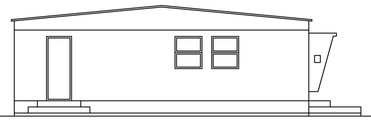

Pre existing side elevation 1.100

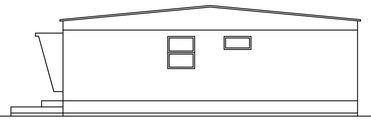

Pre existing side elevation 1.100

As approved front elevation 1.100

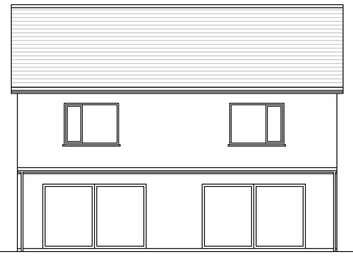

As approved rear elevation 1.100

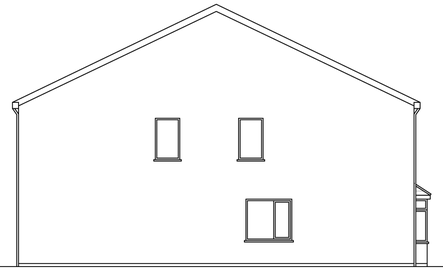

As approved side elevation 1.100

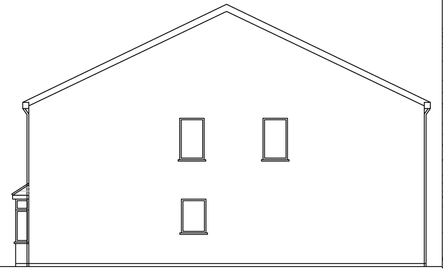

As approved side elevation 1.100

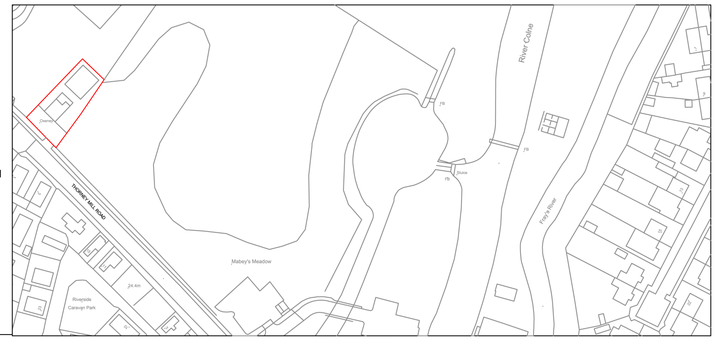

SCALE BAR 1:1250

SCALE BAR 1:500 0 5m 10 15 20 25 30 35 40 45 50m

CLIENT / JOB ADDRESS:	DESCRIPTION :	SCALE : 1:100	REVISION	DESCRIPTION	DRAWN BY	DATE
GOLDIE SANDHU OXENEY, THORNEY MILL ROAD WEST DRAYTON UB7 7EZ	Pre existing plans As approved plans					
		DRAWING NO. - AC/OXNEY/2017/COMBINED2				

1

IMPORTANT NOTE:
ALL GUTTERS, FOUNDATIONS AND DOWN PIPES TO REMAIN WITHIN THE BOUNDARY LINES OF THE SUBJECT PROPERTY. ALL PLANS ARE SUBJECT TO FULL PLANS APPROVAL BY BUILDING CONTROL, NOT BUILDING NOTICE.