LEGEND :

BEL	Bellshe Beacon	RWP	Rainwater Pipe
BOL	Bollard	SB	Shrub Bed
BRS	Brick Setts	SG	Strip Gully
BS	Bus Stop	SP	Sign Post
BSH	Bus Shelter	SPS	Stone Paving Slabs
CBX	Control Box	SRL	Single Red Line
CC	Coal Chute	STN	Survey Station
CH	Cellar Hatch	SWL	Single White Line
CL	Cover Level	SYL	Single Yellow Line
CONC	Concrete	TCB	Telephone Call Box
CPS	Concrete Paving Slabs	TL	Top Level
CR	Cycle Rail	TP	Telegraph Pole
CTV	Cable TV Valve	TPS	Tactile Paving Slabs
DRL	Double Red Line	TS	Traffic Signal
DWB	Dog Waste Bin	UN	Unmade
DYL	Double Yellow Line	UTL	Unable To Lift
EL	Eaves Level	VP	Vent Pipe
FFL	Finished Floor Level	WL	Water Level
FH	Fire Hydrant	WV	Water Valve
FL	Floor Level		
G	Gully		
GRS	Granite Setts		
GV	Gas Valve		
H	High		
IC	Inspection Cover		
ICE	IC Electric		
ICG	IC Gas		
ICT	IC Telecom		
ICTC	IC Traffic Control		
ICTV	IC Cable TV		
ICW	IC Water		
IL	Invert Level		
KO	Kerb Outlet		
LB	Litter Bin		
LC	Lighting Column		
MG	Metal Grille		
O/H	Overhead		
P	Post		
PB	Post Box		
PL	Pavement Light		
PDM	Pay & Display Machine		
PM	Parking Meter		
PP	Pedestrian Push-point		
RE	Rodding Eye		
RL	Ridge Level		

FENCES & WALLS:

BAW	Barbed Wire		
BBW	Breezeblock Wall		
BP	Brick Pillar		
BRTW	Brick Retaining Wall		
BW	Brick Wall		
CB	Close Boarded		
CI	Corrugated Iron		
CLK	Chain Link		
CP	Chestnut Paling		
CRTW	Concrete Retaining Wall		
CW	Concrete Wall		
HDG	Hoarding		
HR	Handrail		
IR	Iron Railings		
MS	Metal Security		
OB	Open Boarded		
PR	Post & Rail		
RW	Rendered Wall		
SM	Steel Mesh		
SW	Stone Wall		
TR	Trellis		
WM	Wire Mesh		

TREES: Oak 100.4/12 Species Spread/Diameter/Height MB x 3 Multi-Bole

NOTES :

The accuracy of this survey drawing is dependent upon the scale at which it is produced. Users should not re-scale this drawing without consent.

This survey has been presented on an Arbitrary co-ordinate grid. All levels have been related to the Ordnance Survey Datum via Network RTK GPS observations. All levels are shown in metres.

DRAWING NO : 3740

DATE :	6/6/16	DRAWN :	SV
SHEET NO :	1 of 1	CHECKED :	MAW
SCALE :	1:100	SHEET SIZE :	A3

CLIENT :
M Naeem
37 Rutters Close
West Drayton
UB7 9AL
Tel: 07917 462676

PROJECT TITLE:
Topographic Survey
37 Rutters Close
West Drayton
UB7 9AL

SURVEYED BY :
ALAN RHODES ASSOCIATES
Land & Measured Building Surveyors
8 Hurlingham Studios
Ranelagh Gardens
London SW6 3PA
Tel : 020 7731 0304
Fax: 020 7731 0314
email : office@ara-survey.co.uk

THE SURVEY ASSOCIATION
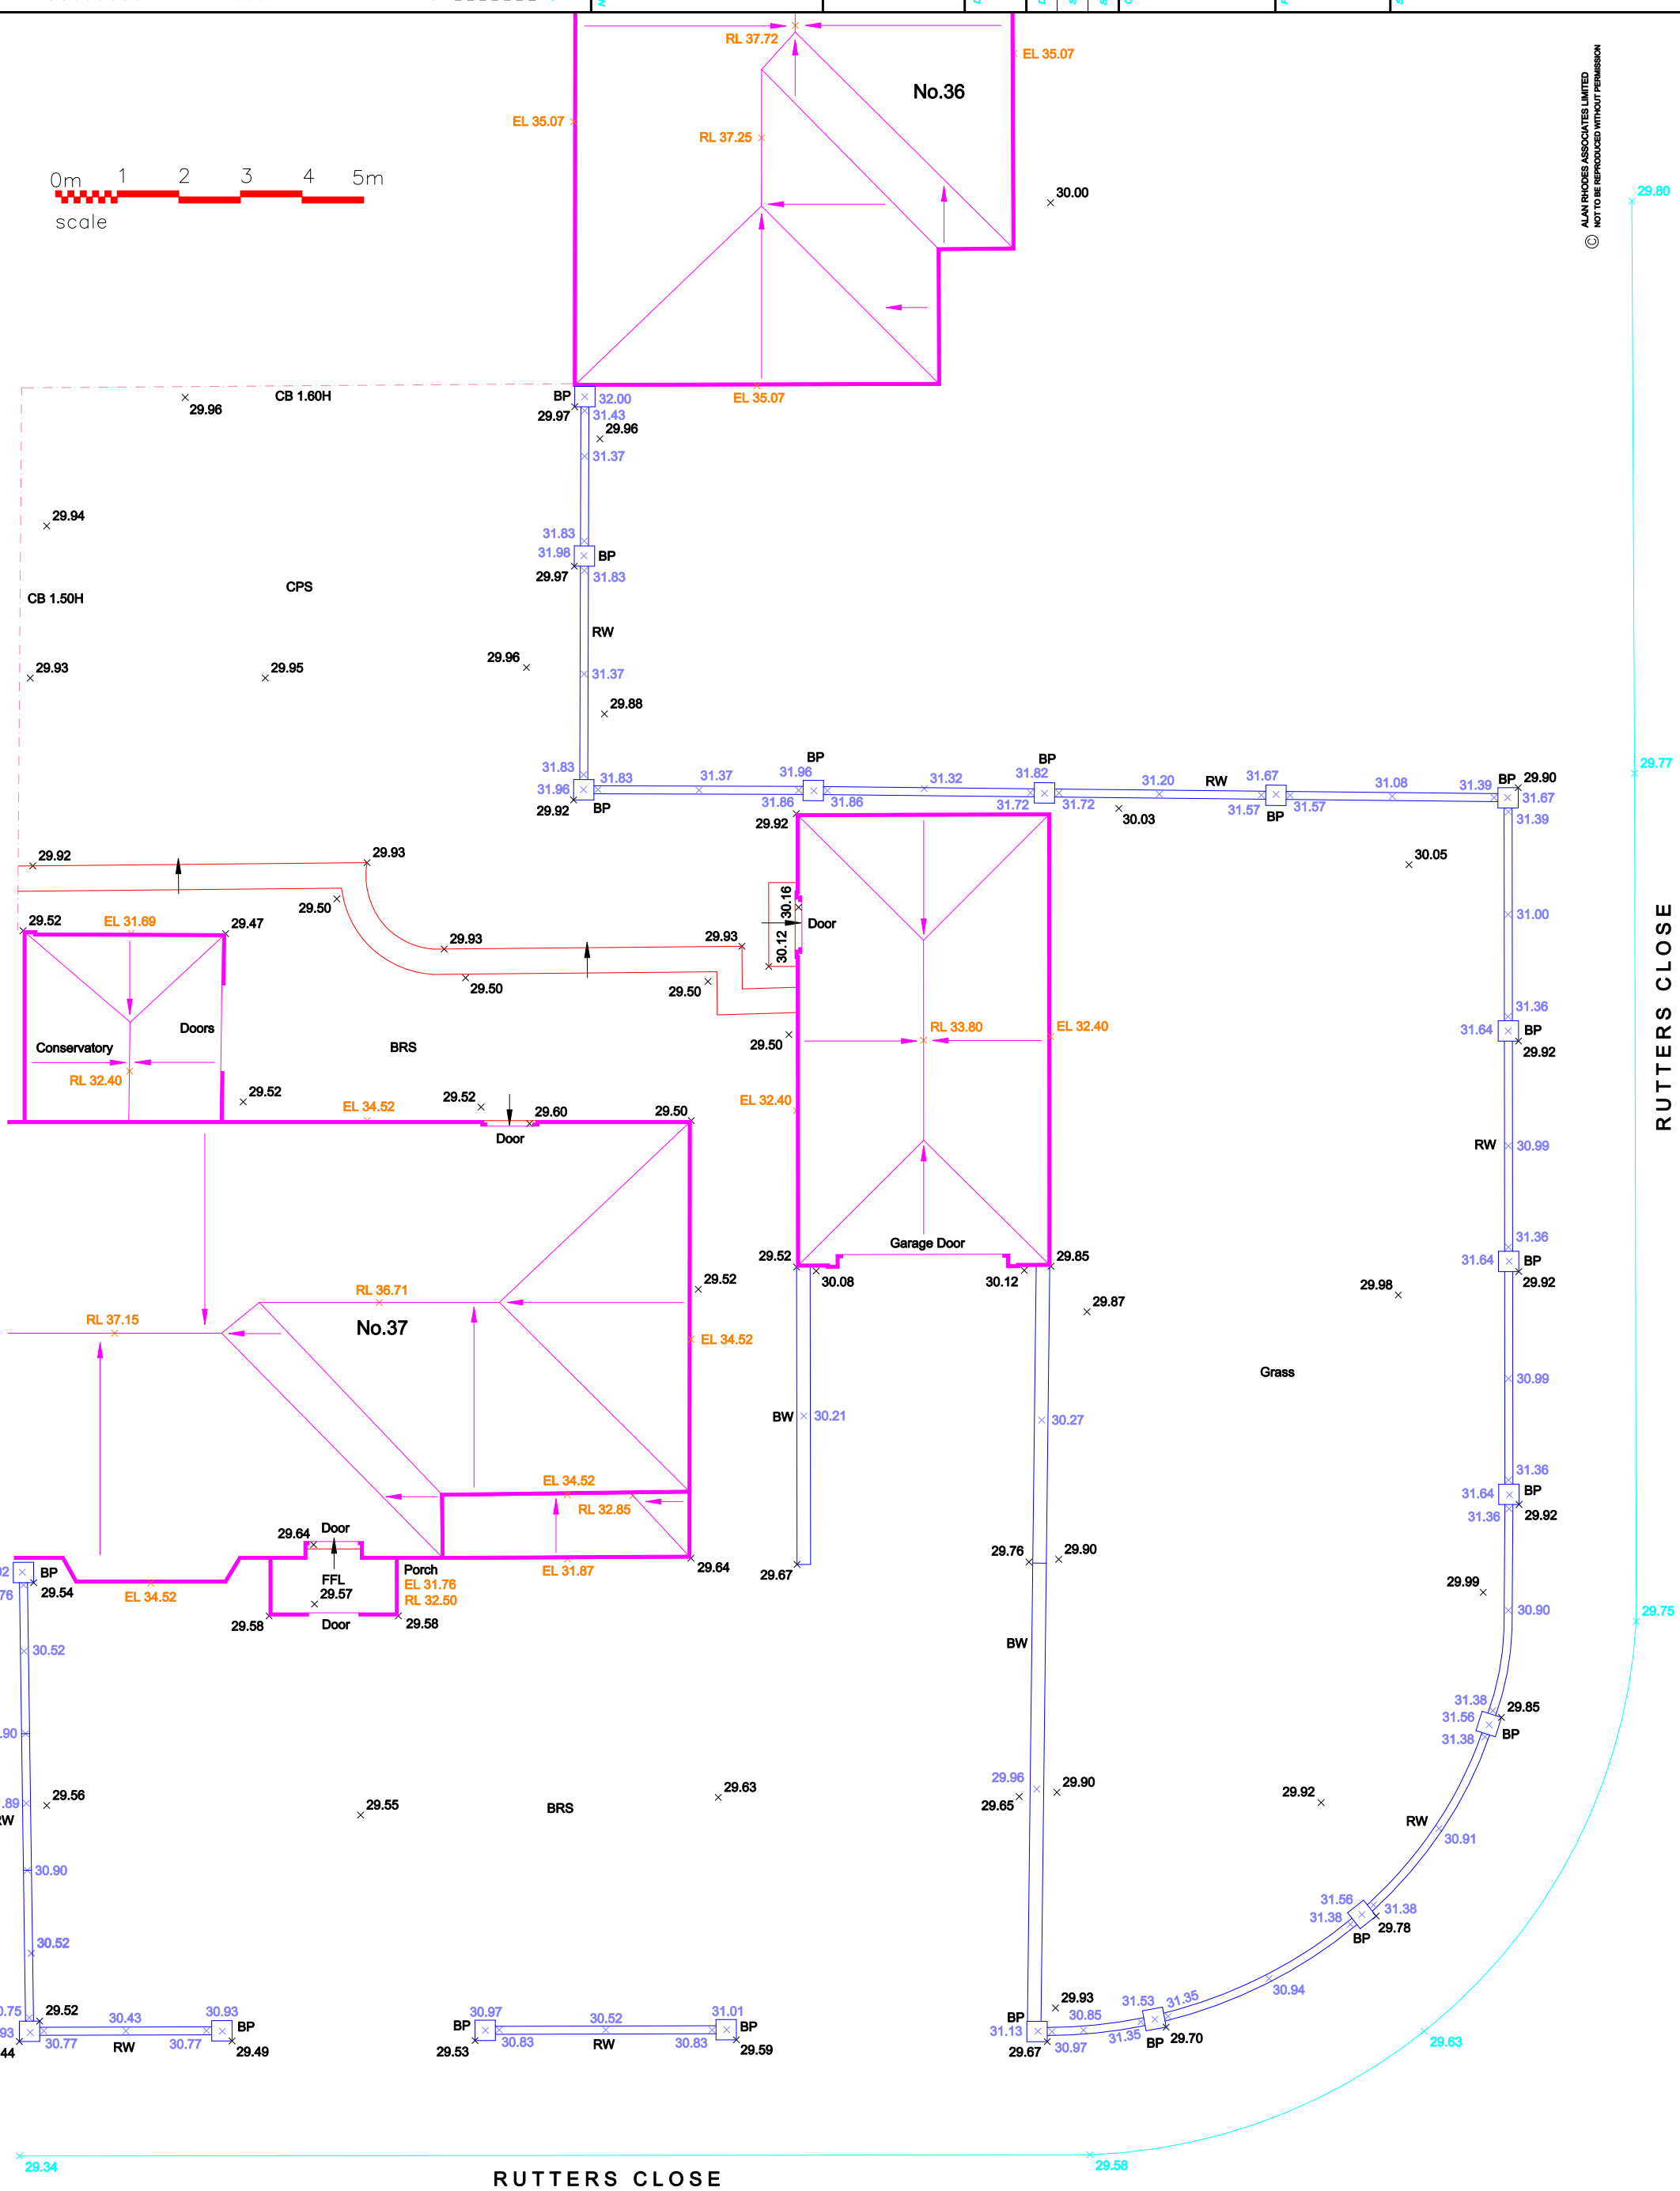
© ALAN RHODES ASSOCIATES LIMITED
NOT TO BE REPRODUCED WITHOUT PERMISSION