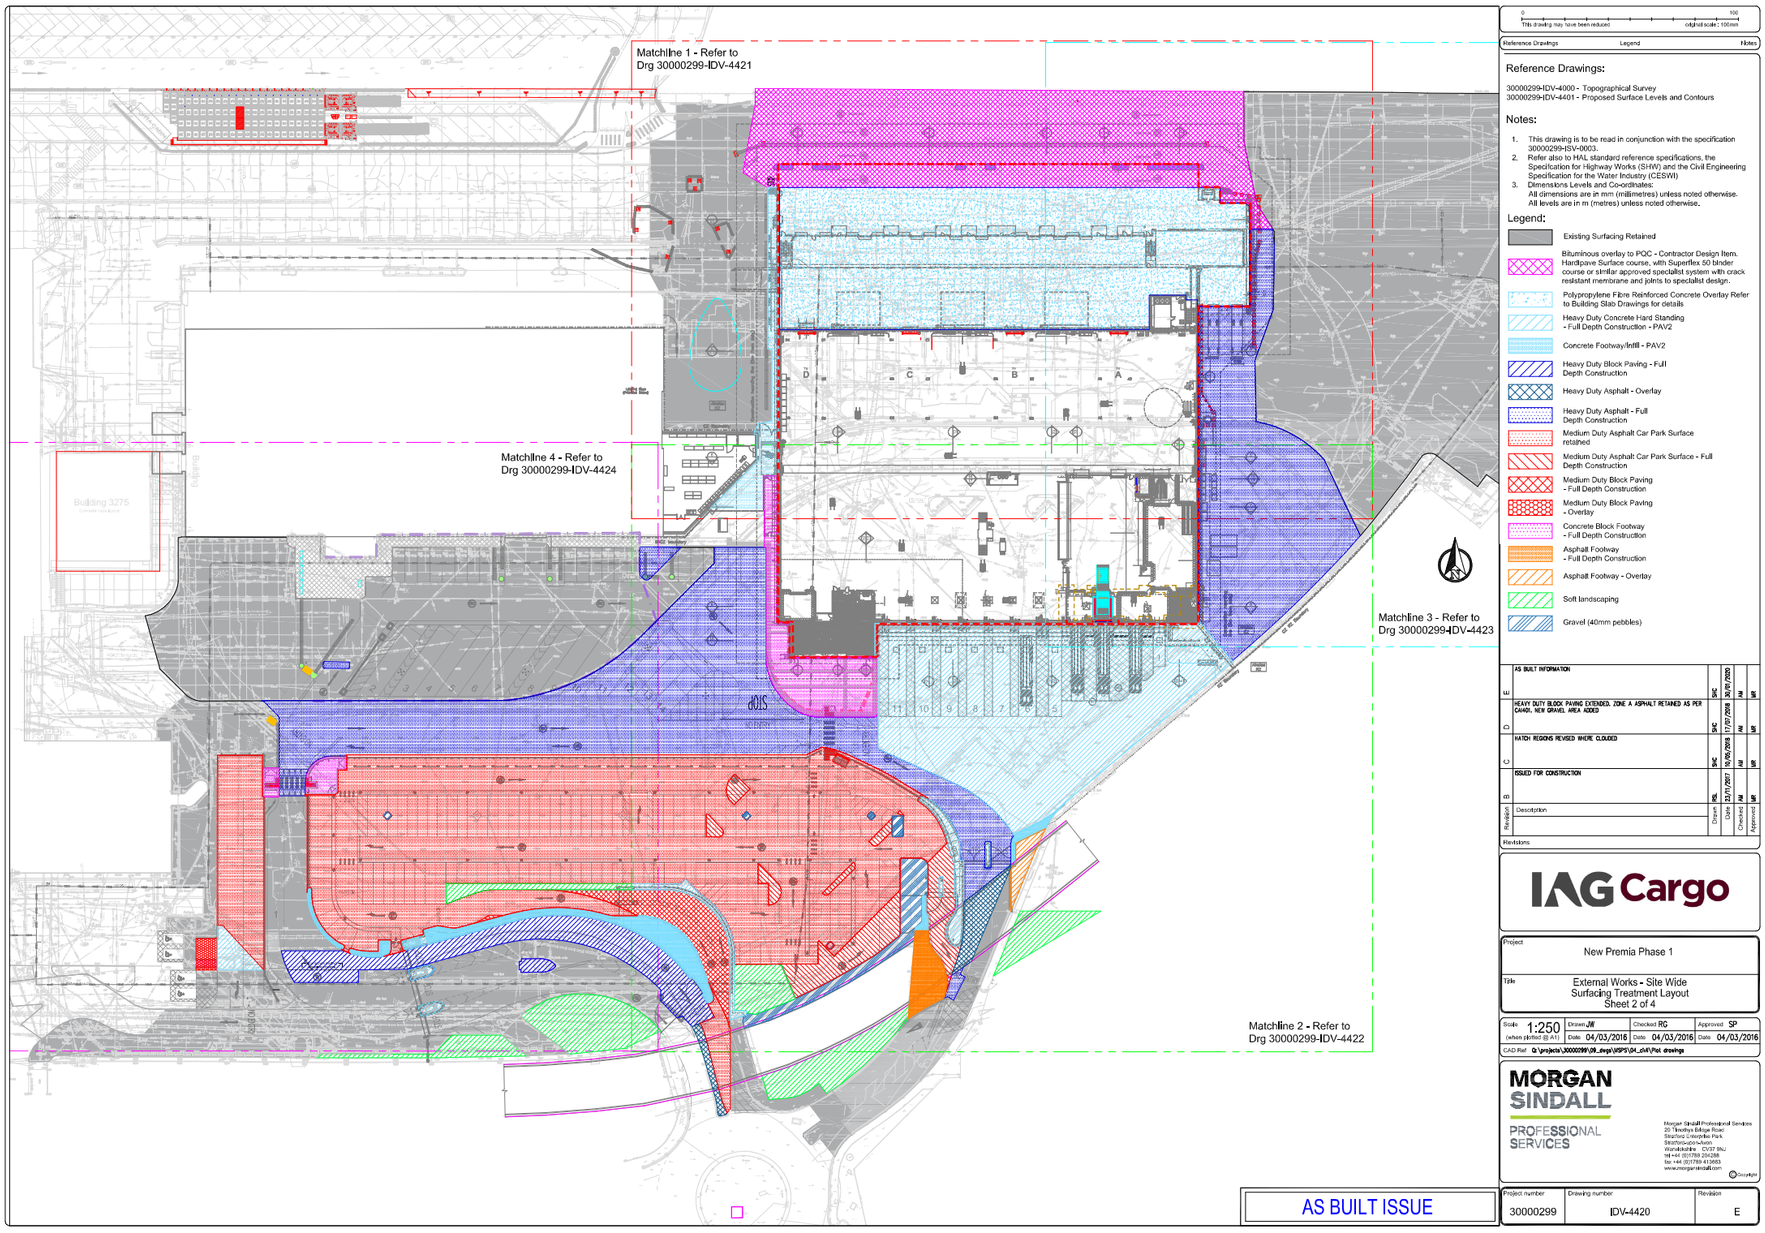


Revision	Description	Drawn	Date	Checked	Approved
E	AS BUILT INFORMATION	SHC	30/01/2020	AM	MR
D	HEAVY DUTY BLOCK PAVING EXTENDED. ZONE A ASPHALT RETAINED AS PER CAMOL. NEW GRAVEL AREA ADDED	SHC	17/07/2018	AM	MR
C	MATCH REGIONS REVISED WHERE CLOUDED	SHC	19/05/2016	AM	MR
B	ISSUED FOR CONSTRUCTION	RSL	23/11/2017	AM	MR

Revisions

IAG Cargo

Project: New Premia Phase 1

Title: External Works - Site Wide Surfacing Treatment Layout Sheet 2 of 4

Scale (when plotted @ A1)	Drawn	Checked	Approved
1:250	JW	RC	SP
	Date 04/03/2016	Date 04/03/2016	Date 04/03/2016

CAD Ref: Q:\projects\30000299\09_dwgs\WSPS\04_civil\Plot drawings

MORGAN SINDALL PROFESSIONAL SERVICES

Morgan Sindall Professional Services
25 Thorpe Bilage Road
Stratford Enterprise Park
Stratford-upon-Avon
Warwickshire CV37 9NJ
tel +44 (0)1789 204288
fax +44 (0)1789 413663
www.morgansindall.com

Project number	Drawing number	Revision
30000299	IDV-4420	E