


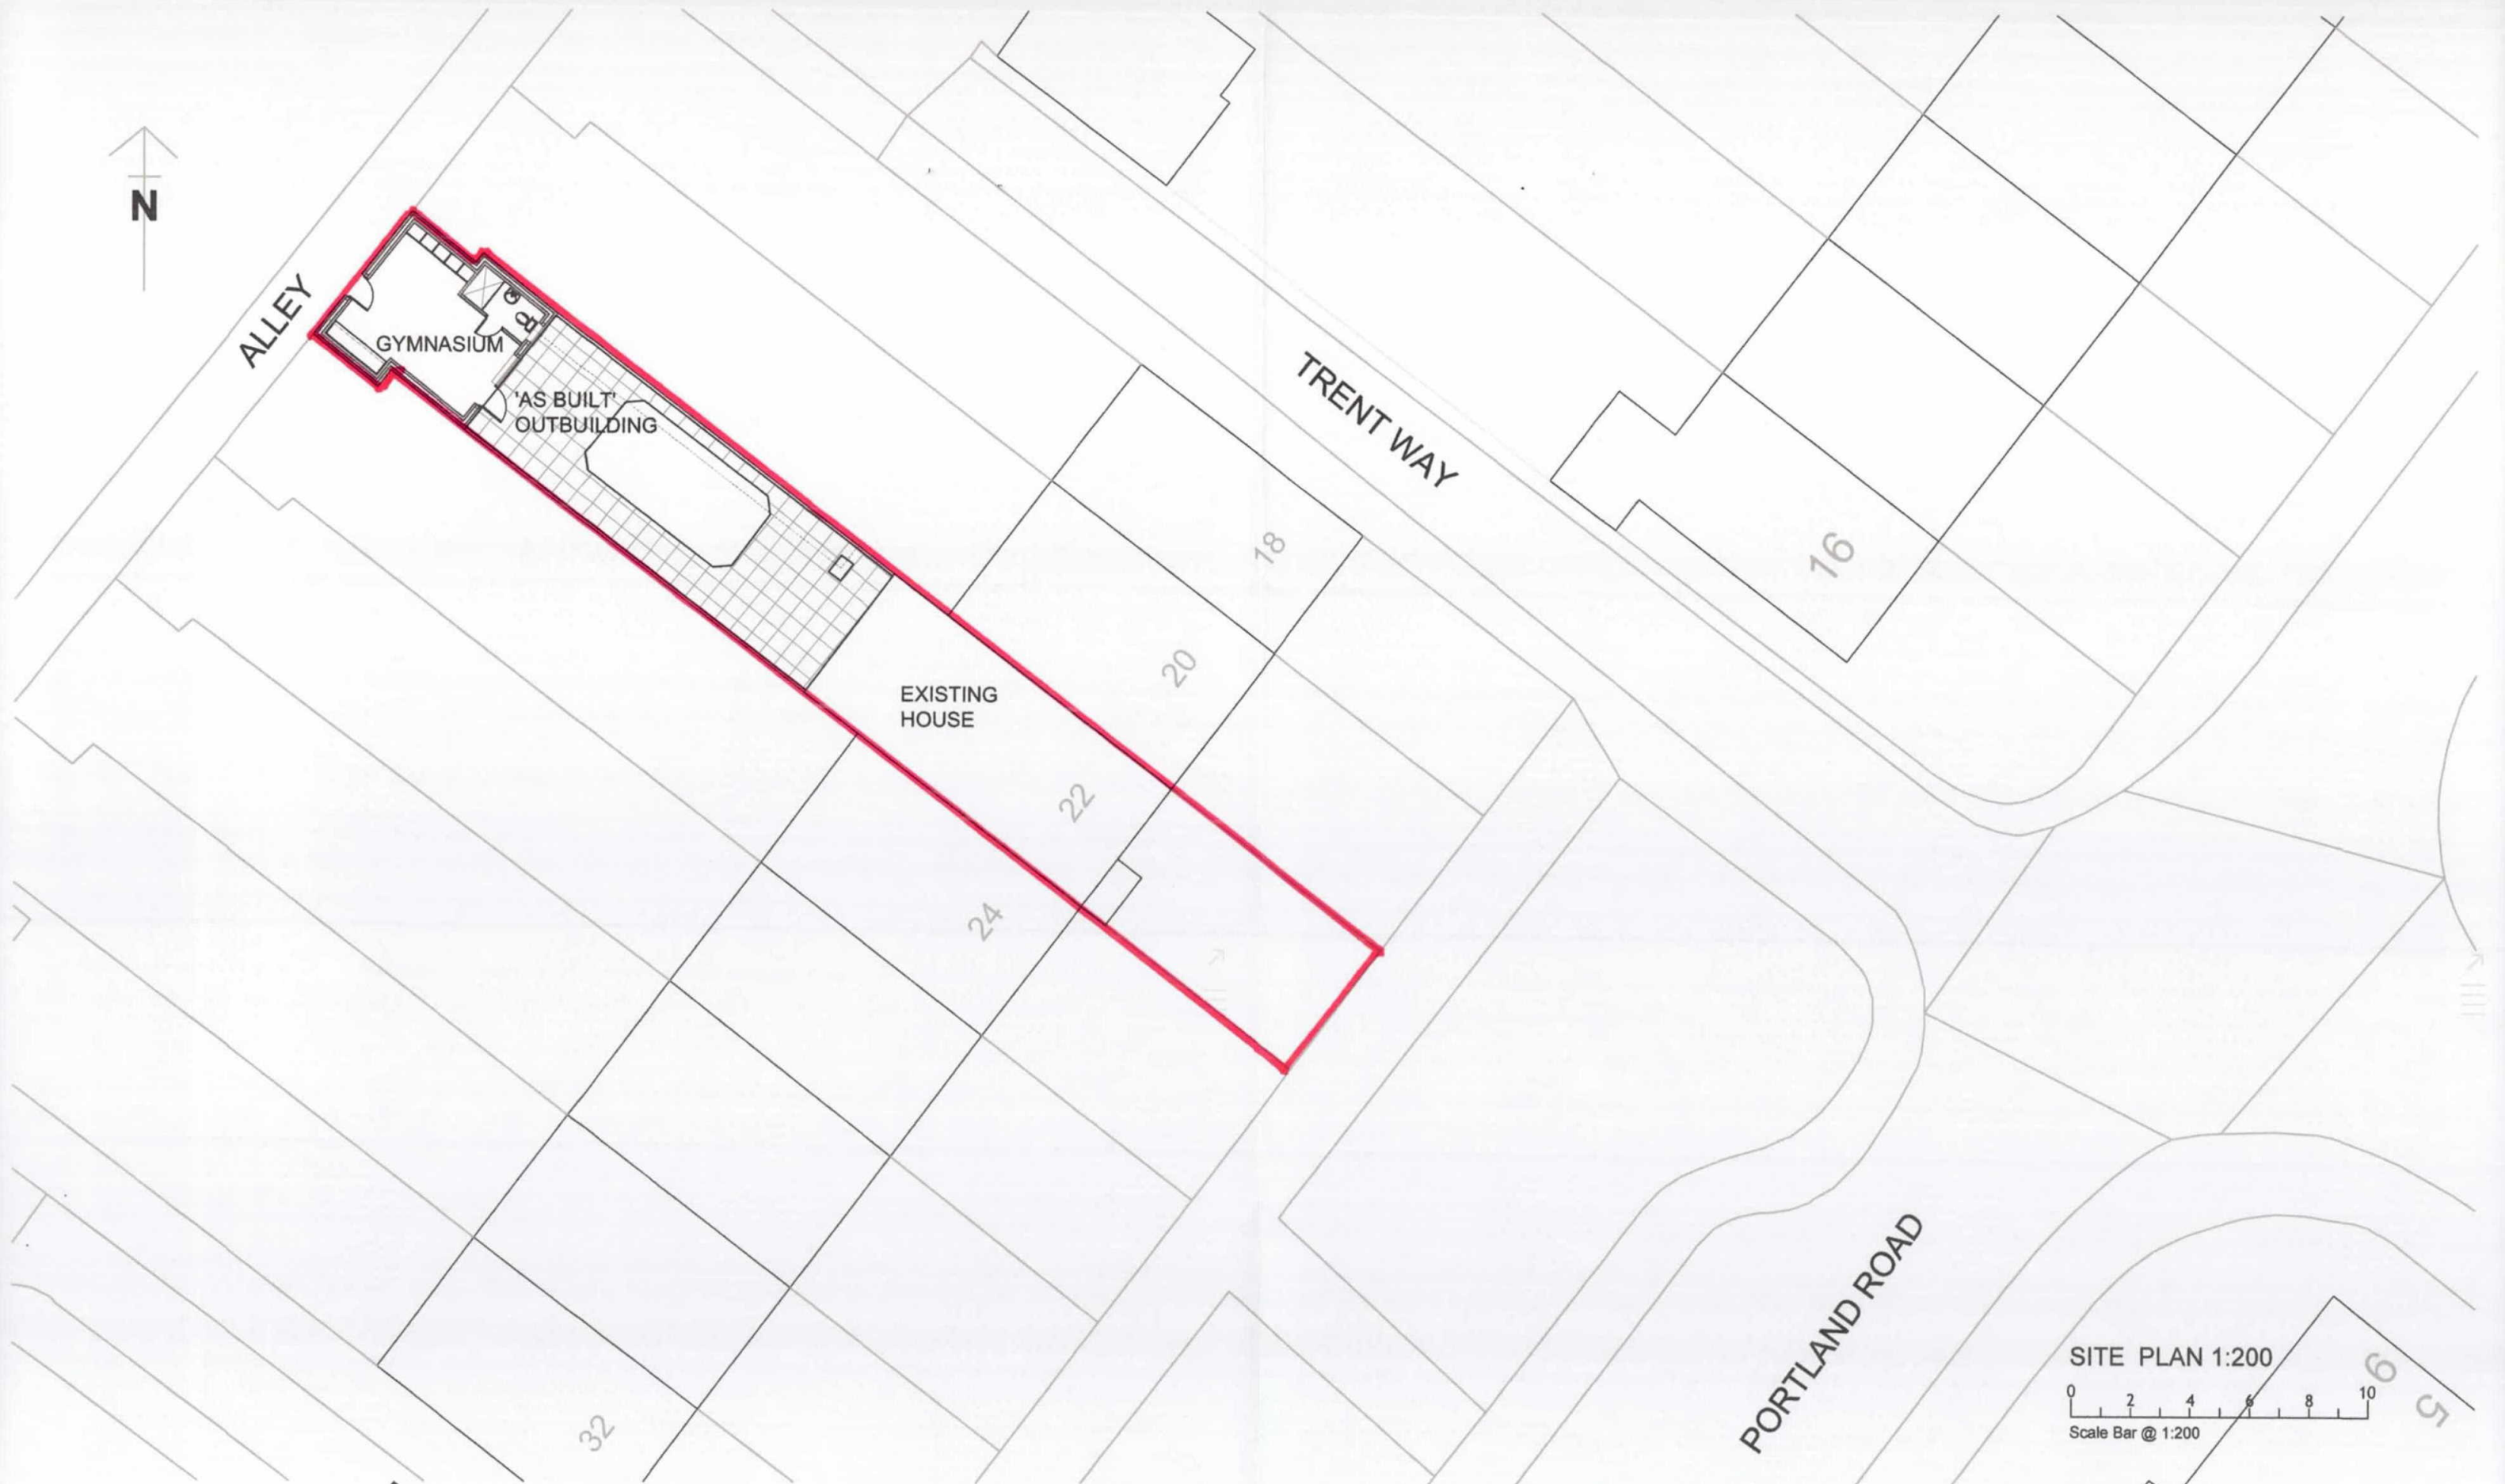

client Mr.Baljinder Singh Dhesi Mrs.Navdish Kaur Dhesi 22 Portland Road Hayes Middlesex UB4 8LG	notes The contractor is responsible for checking dimensions, tolerances and references. Verify any discrepancies with the Architect before proceeding with the works. Where an item is covered by drawings to different scales the larger scale drawing is to be worked to. Do not scale drawing. Figured dimensions to be worked to in all cases.	project	RESTROSPECTIVE PLANNING APPLICATION FOR ' AS BUILT ' OUTBUILDING AT 22 PORTLAND ROAD, HAYES, MIDDLESEX, UB4 8LG	
		revisions	drawn		RP	drawing no		RP500PLANNING	
			scale	1:200 @A3	
			date	28-05-2018	