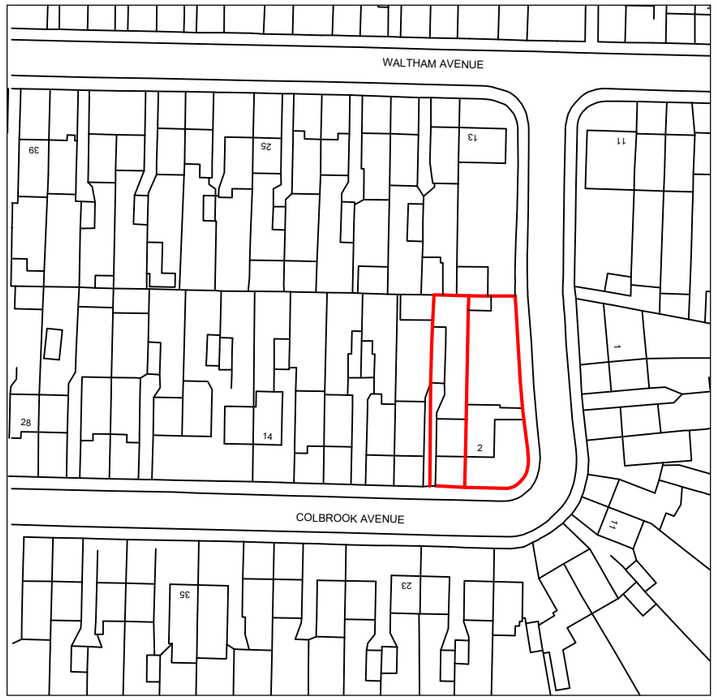

LOCATION PLAN
1 : 1250 SCALE

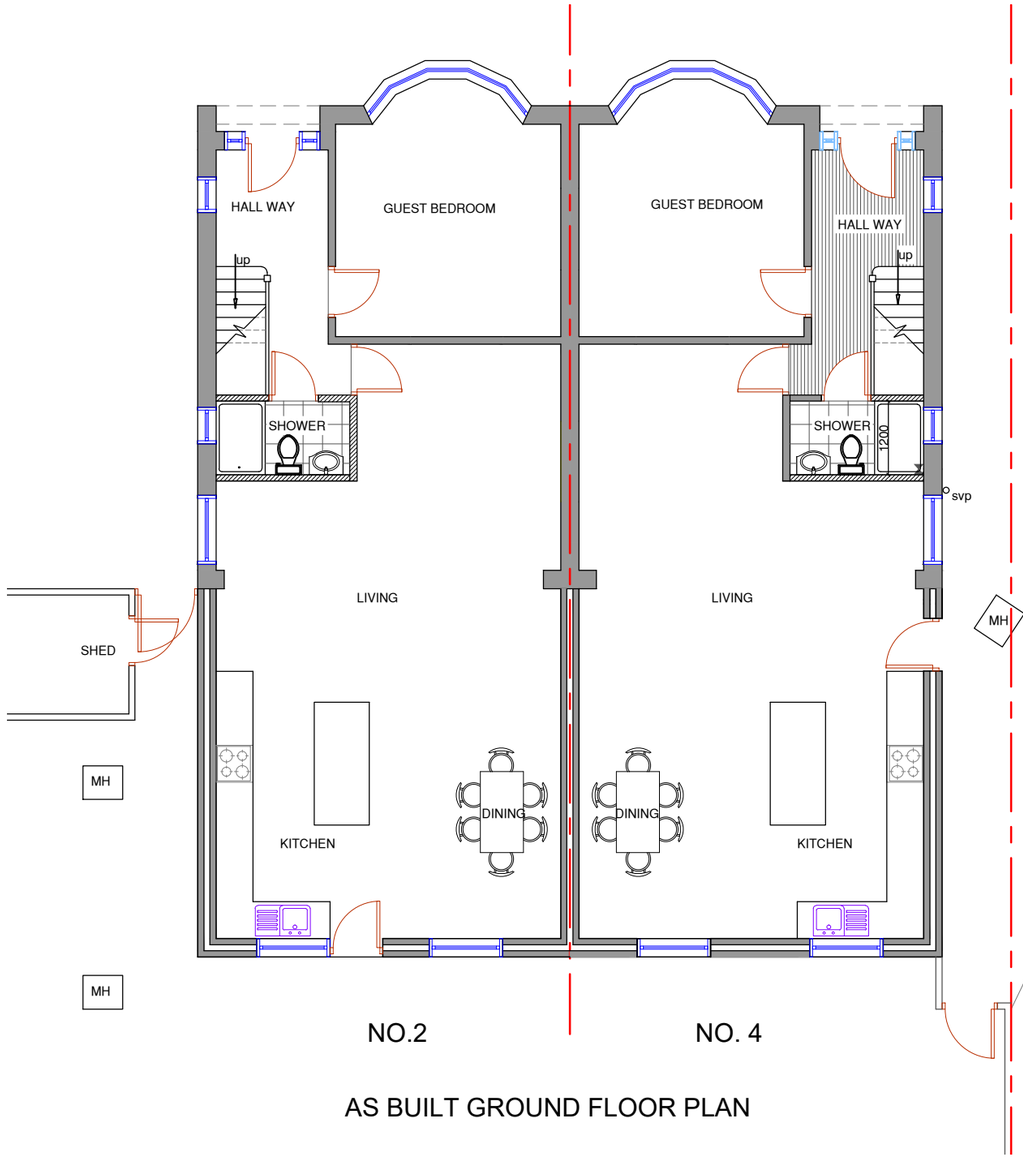

AS BUILT GROUND FLOOR PLAN

NOTES :

	Date	Revisions

Client: MR. JAGTAR SINGH & HJ PROPERTY UK LTD.

Job Title

2-4 COLBROOK AVENUE
HAYES
UB3 1TG

Drawing Title

LOCATION AND GROUND FLOOR PLANS (AS BUILT)

Scale: 1 : 100 / 1250 (A3)

Date: FEBRUARY 2022

Checked by: | Drawn by: RS

Drg No. TP/466/L01 | Rev.