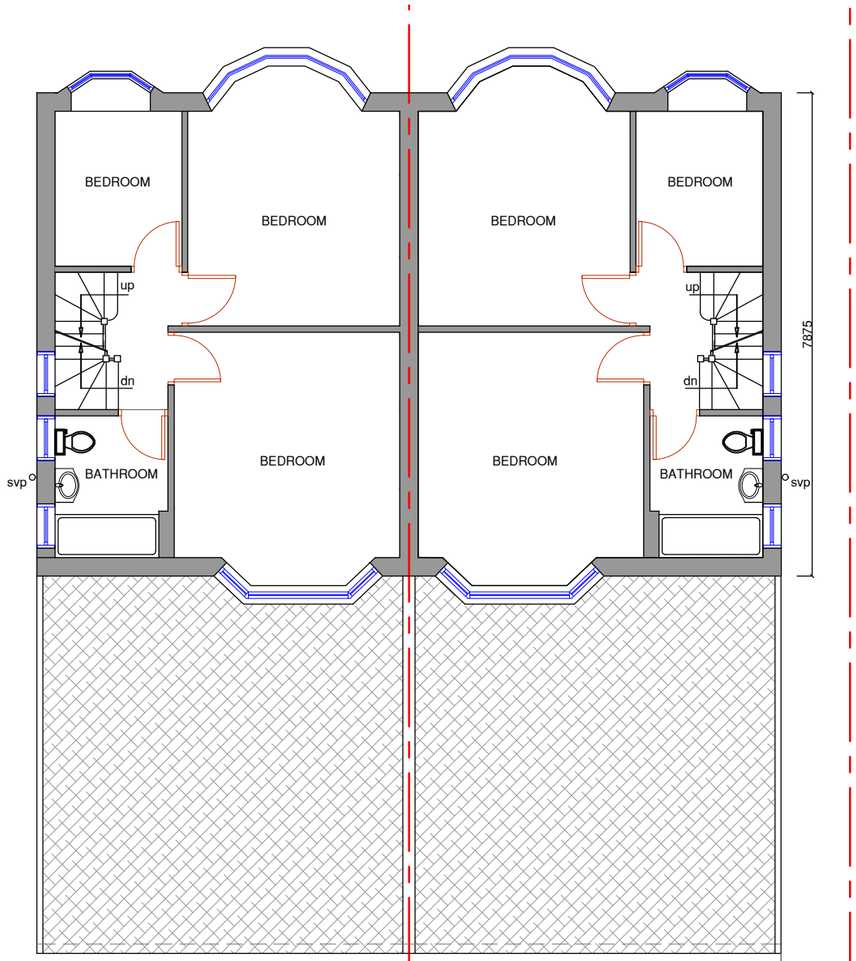

NO.2 NO. 4

AS BUILT FIRST FLOOR PLAN

NO. 6

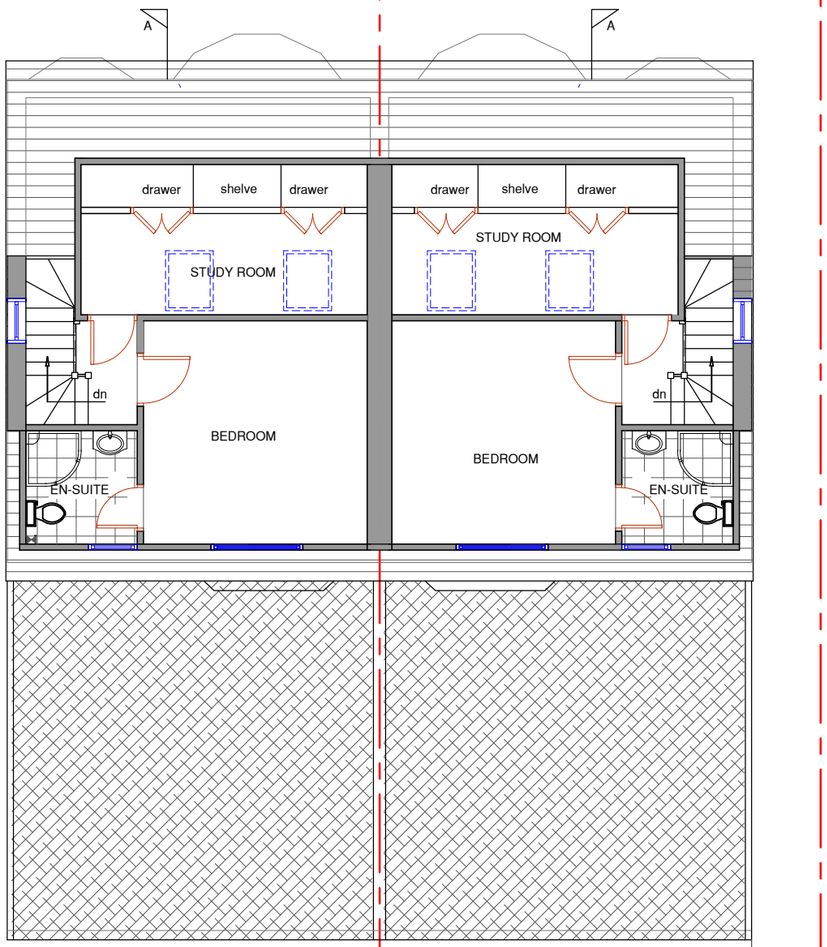

NO.2 NO. 4

AS BUILT LOFT PLAN

NO. 6

VOLUME CALCULATION

(NO.2)
REAR DORMER :
(5.745 x 2.52 x 3.47) / 2
= 25.11m³
HIP TO GABLE :
(7.875 x 3.112x 4.016 / 6 = 16.4m³
TOTAL = 41.51m³

PERMITTED DEVELOPMENT
AS TOTAL VOLUME < 50 m3

0m 1m 2m 3m 4m 5m

SCALE @ 1:100

NOTES :

PLANNING PERMISSION GRANTED UNDER CERTIFICATE OF LAWFUL USE OR DEVELOPMENT :

Ref: 52974/APP/2021/1452 (No. 2)
Ref: 52974/APP/2021/1427 (No. 4)

N

	Date	Revisions

Client: MR. JAGTAR SINGH & HJ PROPERTY UK LTD.

Job Title

2-4 COLBROOK AVENUE
HAYES
UB3 1TG

Drawing Title

FIRST FLOOR AND LOFT PLANS (AS BUILT)

Scale: 1 : 100 (A3)
Date: FEBRUARY 2022
Checked by: Drawn by: RS

Drg No. TP/466/L02
Rev.