NO.4 NO.2

AS BUILT FRONT ELEVATION

NO.2 NO.4

AS BUILT REAR ELEVATION

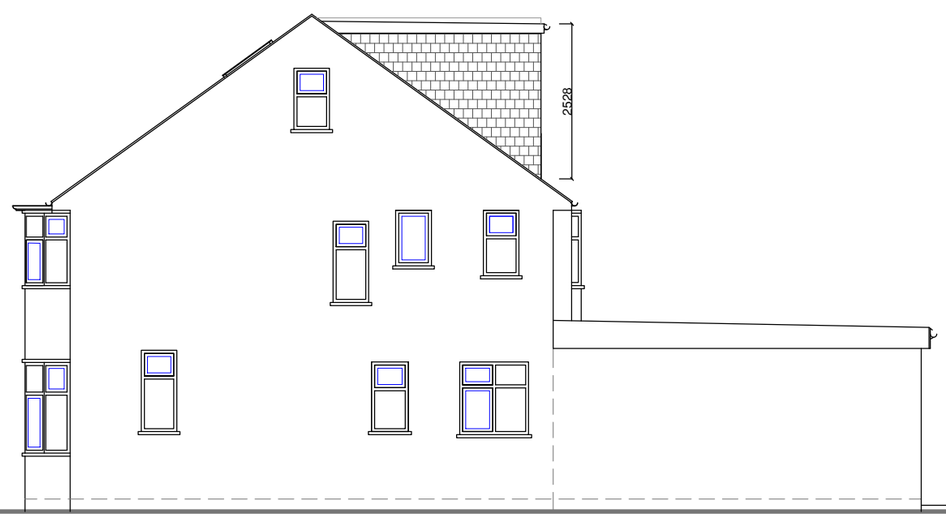

NO. 2
AS BUILT SIDE ELEVATION

NO. 4
AS BUILT SIDE ELEVATION

0m 1m 2m 3m 4m 5m

SCALE @ 1:100

NOTES :

PLANNING PERMISSION GRANTED UNDER CERTIFICATE OF LAWFUL USE OR DEVELOPMENT :

Ref: 52974/APP/2021/1452 (No. 2)
Ref: 52974/APP/2021/1427 (No. 4)

	Date	Revisions

Client: MR. JAGTAR SINGH & HJ PROPERTY UK LTD.

Job Title

2-4 COLBROOK AVENUE
HAYES
UB3 1TG

Drawing Title

AS BUILT ELEVATIONS

Scale: 1 : 100 (A3)

Date: FEBRUARY 2022

Checked by: | Drawn by: RS

Drg No. TP/466/L03 | Rev.