
Ground Floor 235sqm GEA (211sqm GIA)


First Floor 167sqm GEA (145sqm GIA)

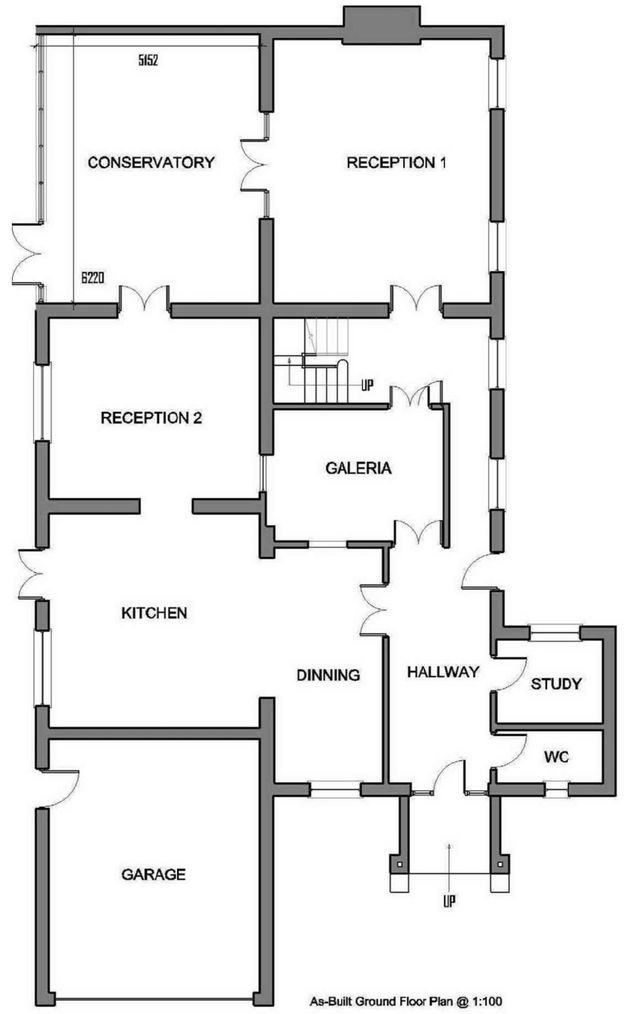

As-Built Ground Floor Plan @ 1:100




As-Built 1st Floor Plan @ 1:100

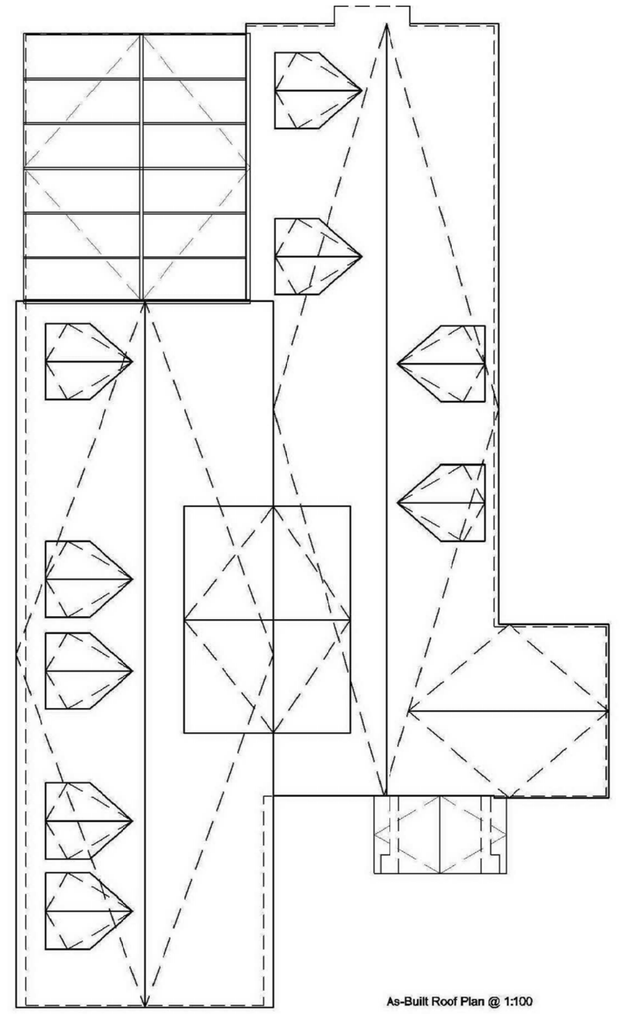


As-Built Roof Plan @ 1:100



As-Built Front Elevation @ 1:100

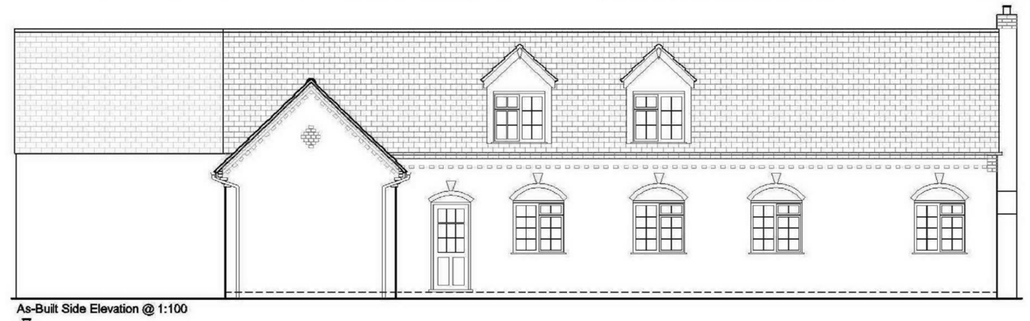

As-Built Side Elevation @ 1:100

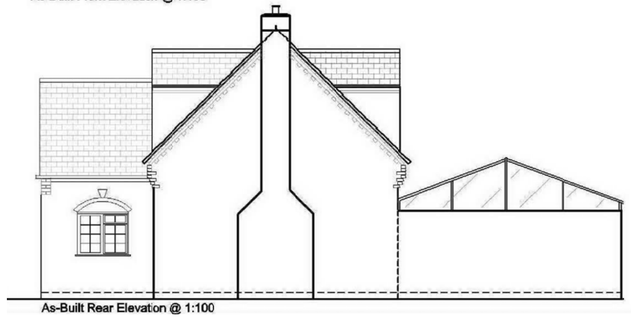

As-Built Rear Elevaton @ 1:100



As-Built Side Elevation @ 1:100

Scaling from a print of this drawing will only give approximate dimensions due to inherent inaccuracies in printed media. Where accurate dimensions are required please refer to R Clarke Planning Ltd.
2. Proposed works are based upon survey information provided by others. R Clarke Planning Ltd is not responsible for discrepancies in survey information.
3. All dimensions to be checked on site prior to commencement of any works, and/or preparation of any shop drawings.
4. All co-ordinates, levels, dimensions and discrepencies are to be reported to R Clarke Planning Ltd.
5.. This drawing to be read in conjunction with all relevant drawings, specifications and other Consultant's information.

0m 5m

SCALE:	PAPER SIZE:
1:100	A1
WC 11	

DRAWING TITLE:
Existing House Plans

SITE ADDRESS:
Woodlands
The Drive
Ickenham

R Clarke Planning Ltd
KEWFERRY FARM, NEWGROUNDWORTH ROAD
NORTHWOOD, MIDDX, HA6 2NF
TEL 01923 449355 FAX 01923 449355
E-MAIL RClarke.LtD@uk.com
Mobile number 077956 20703

R Clarke Planning Ltd

© Copyright 2014 R Clarke Planning Ltd