


VEHICLE DETAILS

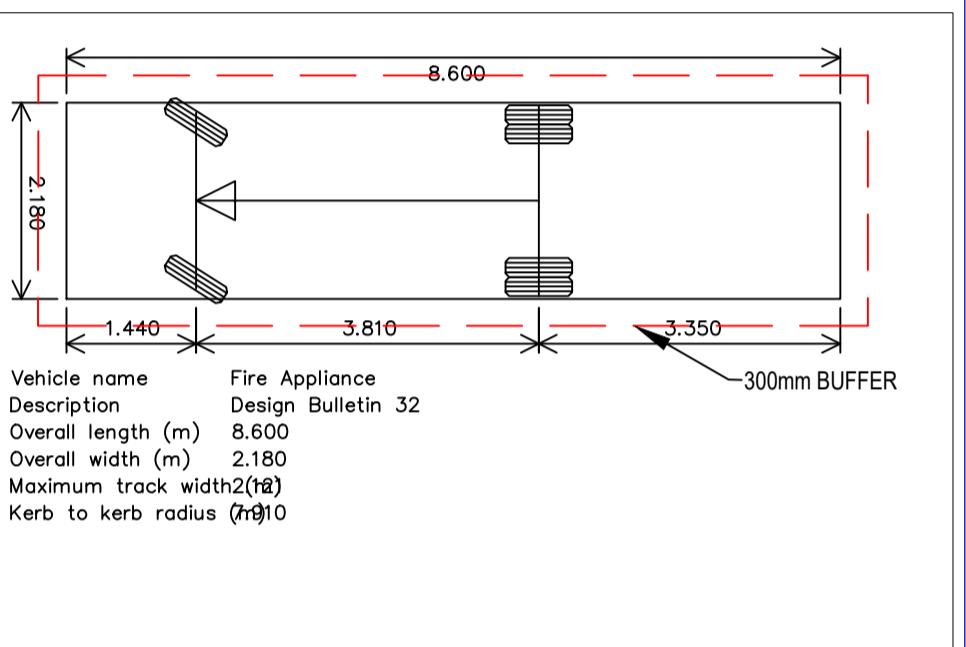

NOTES

Tracking is for a British Large Car as defined by Tracking software. This is generally larger than most common/popular cars as listed in the table provided.

Tracking shows that a large car can utilise spaces although in some instances, multiple manoeuvres may be required.

Standard car parking dimensions allow for nominal space either side of a vehicle chassis for door opening, so minor clipping on corners of adjacent spaces is permissible as an adjacent car would not be affected if parked correctly.

Residents/Purchasers/Landlords are advised to be aware that exceptionally large cars, SUV's, MPV's, vans and other very large vehicles may have difficulty in using the parking facility.

- C3 Tender Issue.
- C2 Revised to As Built status.
- C1 Construction Issue for NHBC condition bc18
- B1 Description

25/09/24	klh
15/02/22	maw
12/02/19	maw
Date	Initial

Rev. Description. Date. Initial.
Drawing Status: **TENDER**

TENDER

Crest Nicholson Ltd.
Crest House

Pyrcroft Road
Chertsey

DESIGN ASSOCIATES

CIVIL ENGINEERING & INFRASTRUCTURE DESIGN

 01206 247081
Tel: 01932 580 555

CICST
NICHOLSON

Tel: 01932 360 333
Fax: 08703 363 990
www.cicstnicholson.com

THE OLD VINYL STORE

BLYTH ROAD, HAYES

Drg Title: FIRE TENDER ACCESS

Scale: 1:200 Page Size: A1 Date: 02/10

1.200	A1	02/19
Drawn: kh	Checked: maw	

Drawing No: 14805TA/3820 Revision: C3

