


## Existing Site Plan

1m 5m 10m
1:500

N

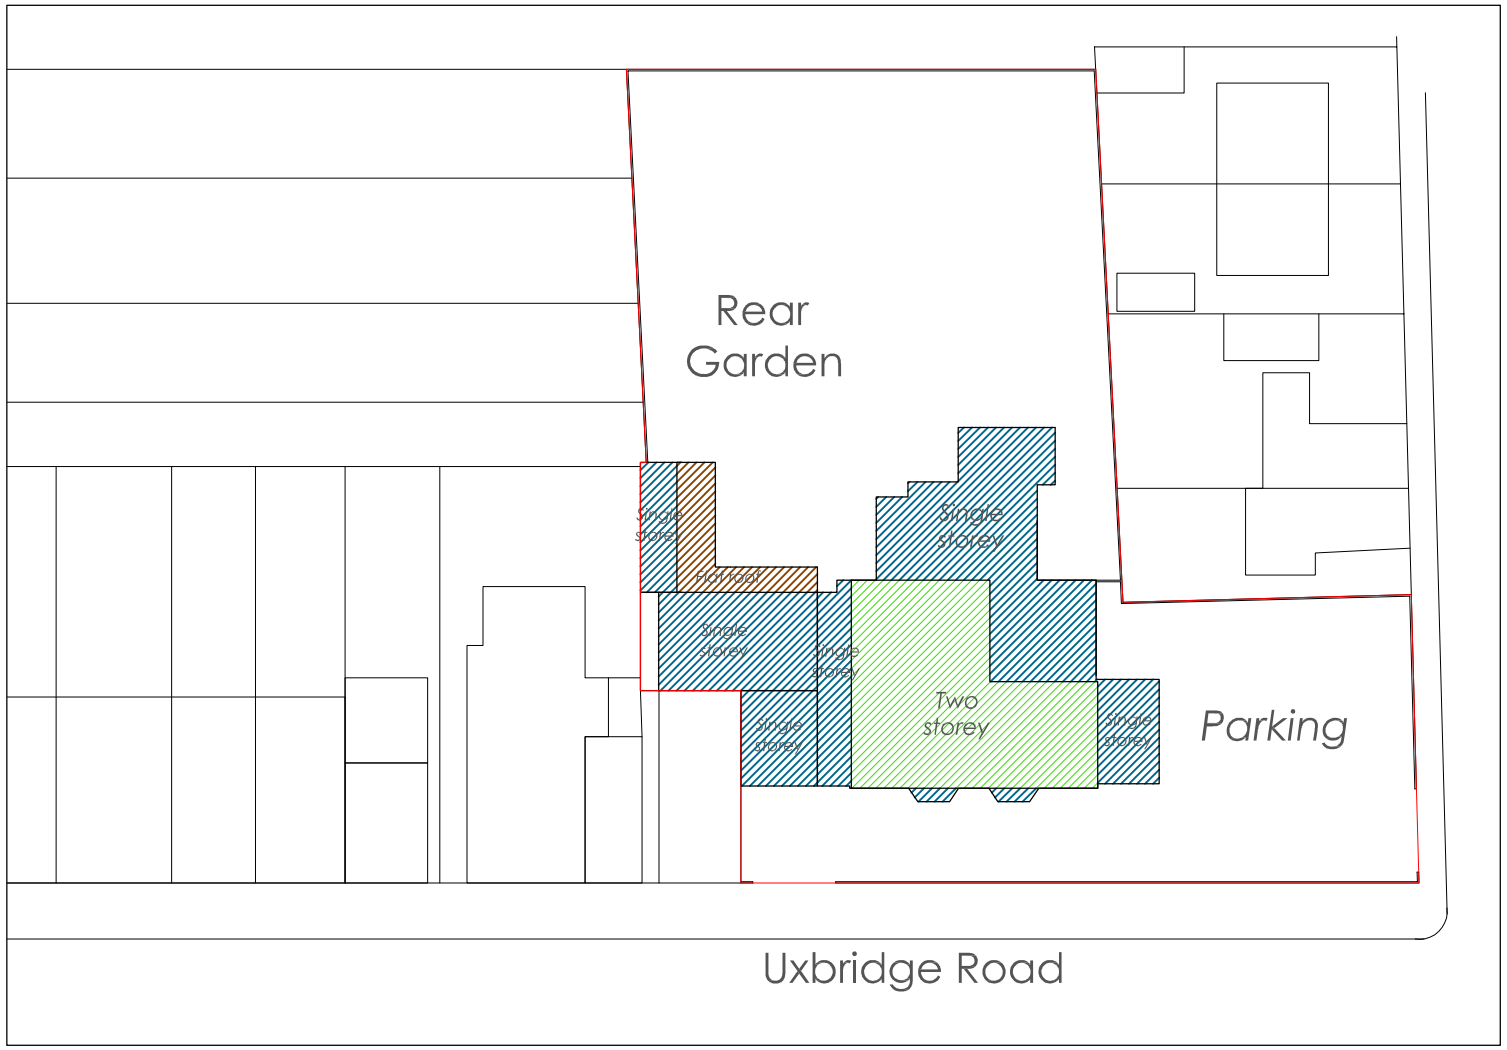


## As built Site Plan

1m 5m 10m
1:500

N

| PROJECT | DWG NO. | SCALE | DETAIL | 15.09.2016 | | | | | | | PROJECT NO. |
|---|---|---|---|---|---|---|---|---|---|---|---|
| **TAMARA LOUNGE, 4 BYRON PARADE, UXBRIDGE ROAD**<br>PROPOSED TIMBER CANOPY | 01 | 1:500 @ A3 | EXISTING AND AS BUILT SITE PLANS | SUBMITTED TO RETROSPECTIVE DEPT. HILLINGDON | | | | | | | 15.53 |

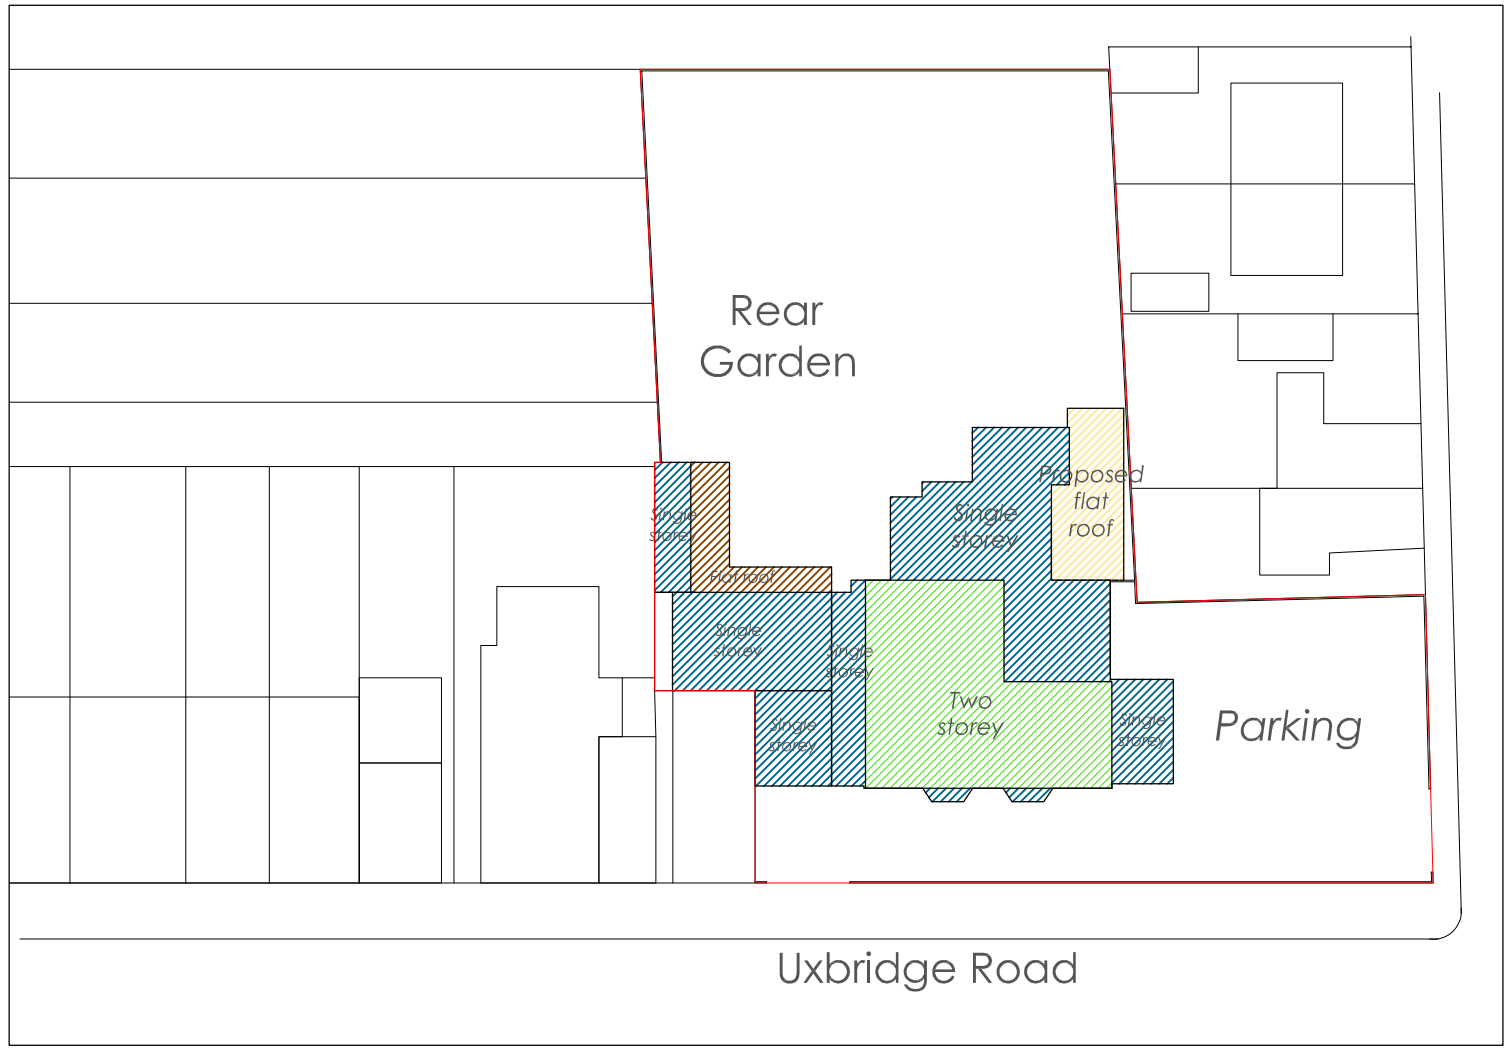**PR Architecture ltd.**
Chartered Architect
120, Pinner Road, Harrow, HA1 4JD.
Tel: 0208 357 2304