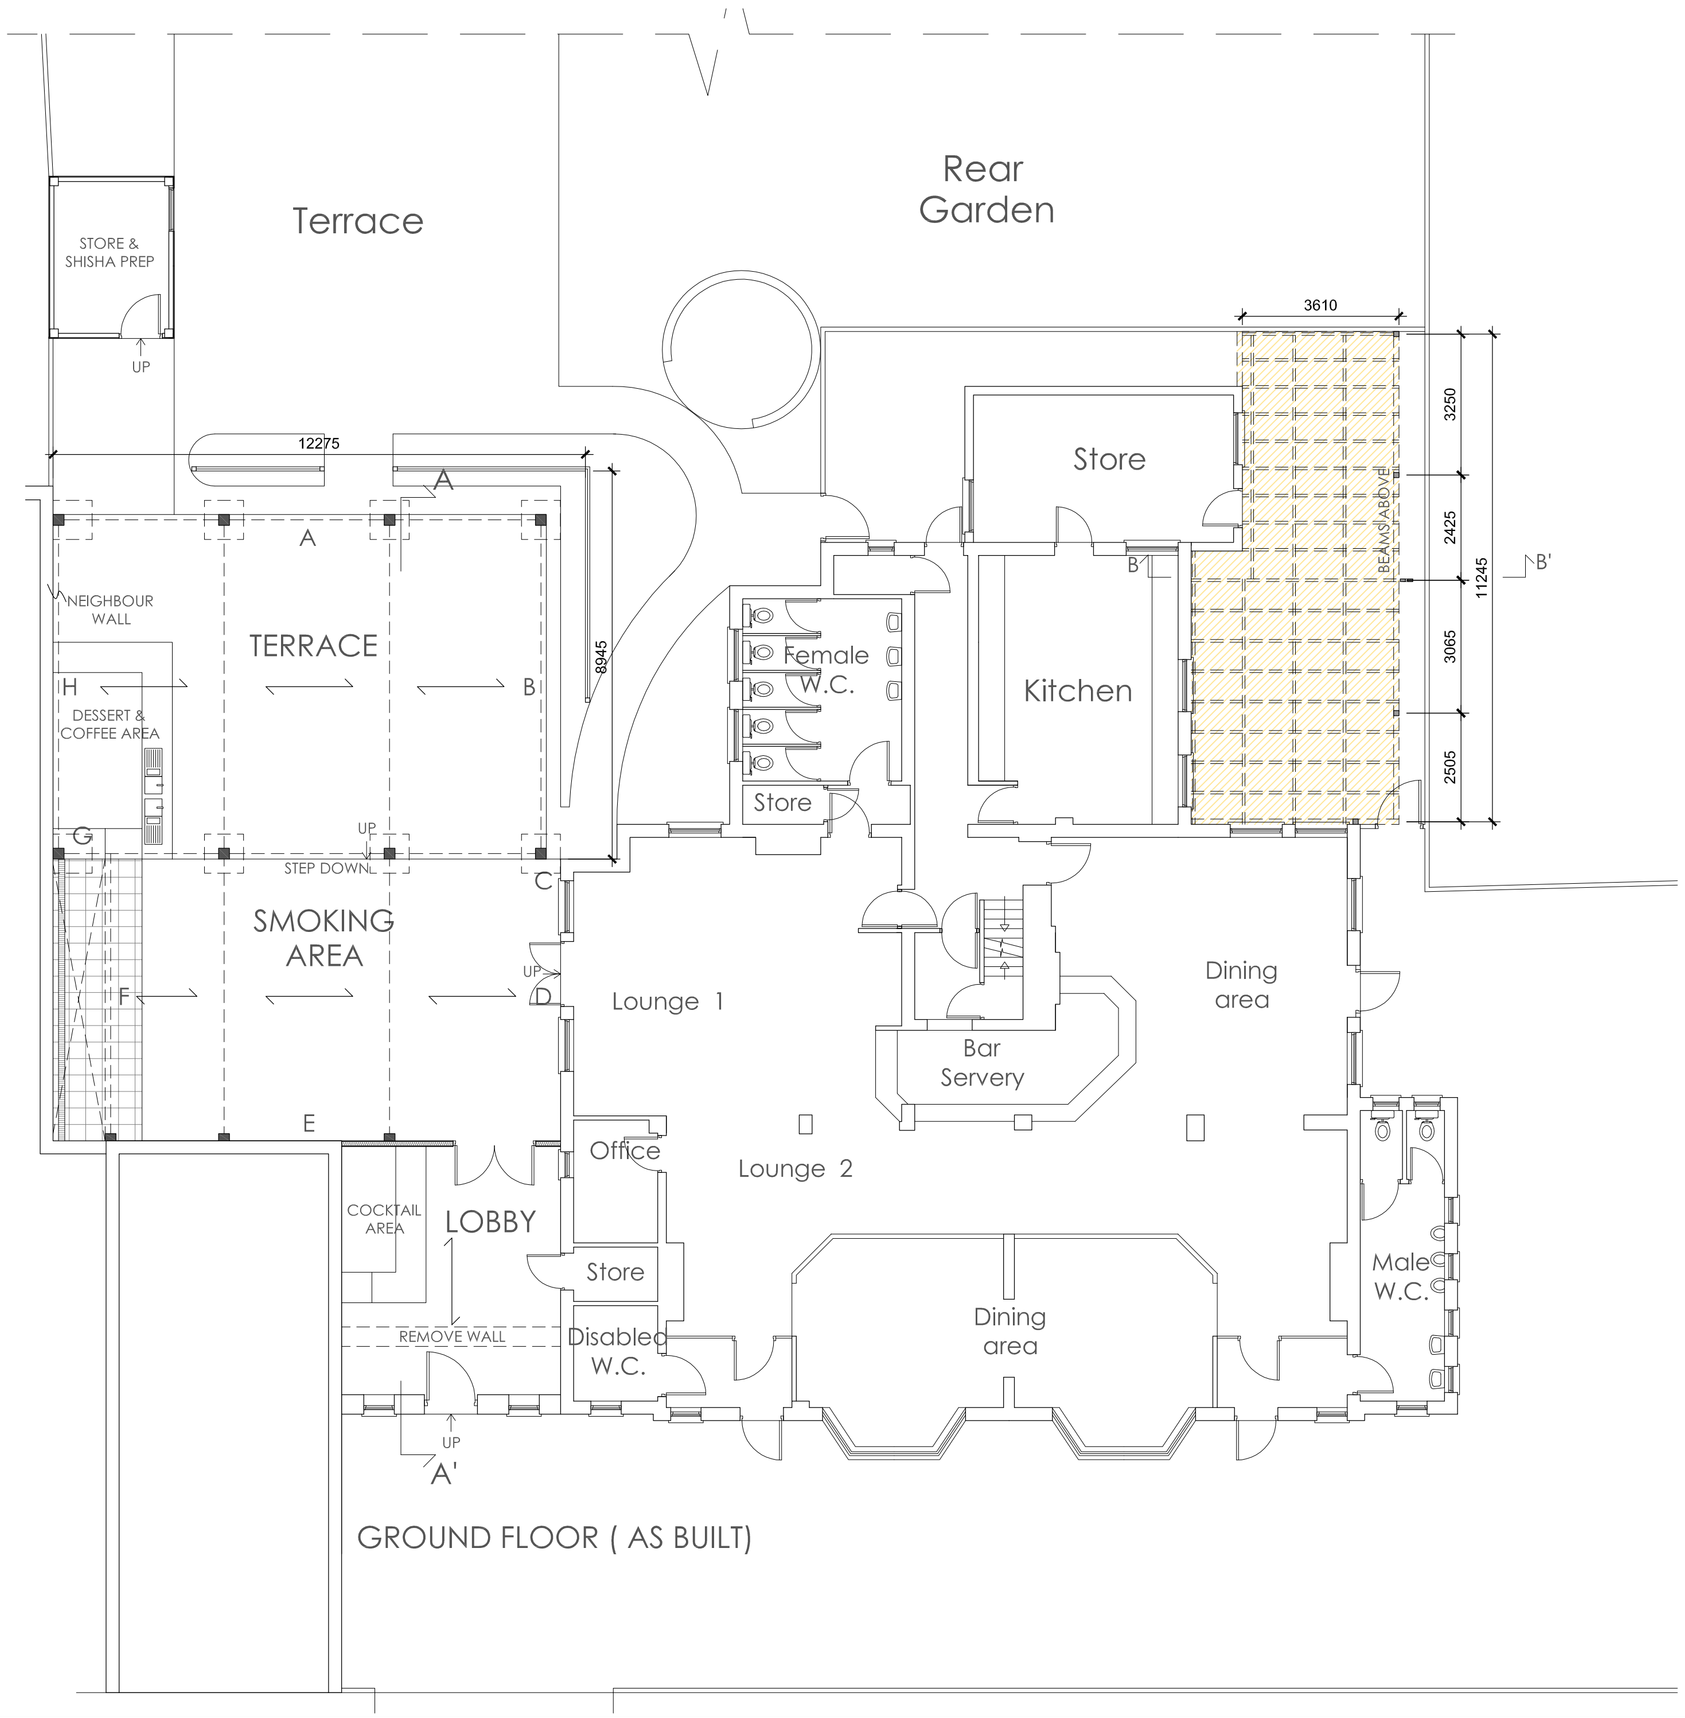

GROUND FLOOR (AS BUILT)

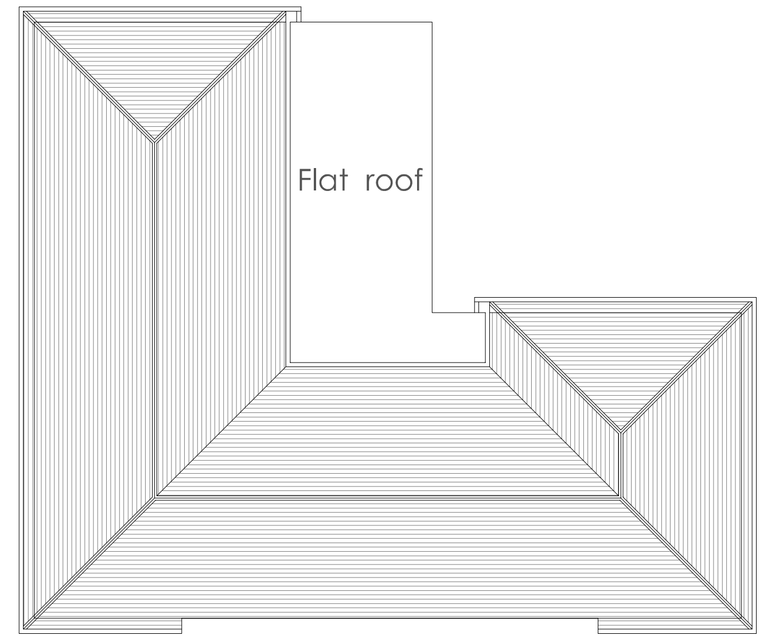

ROOF PLAN

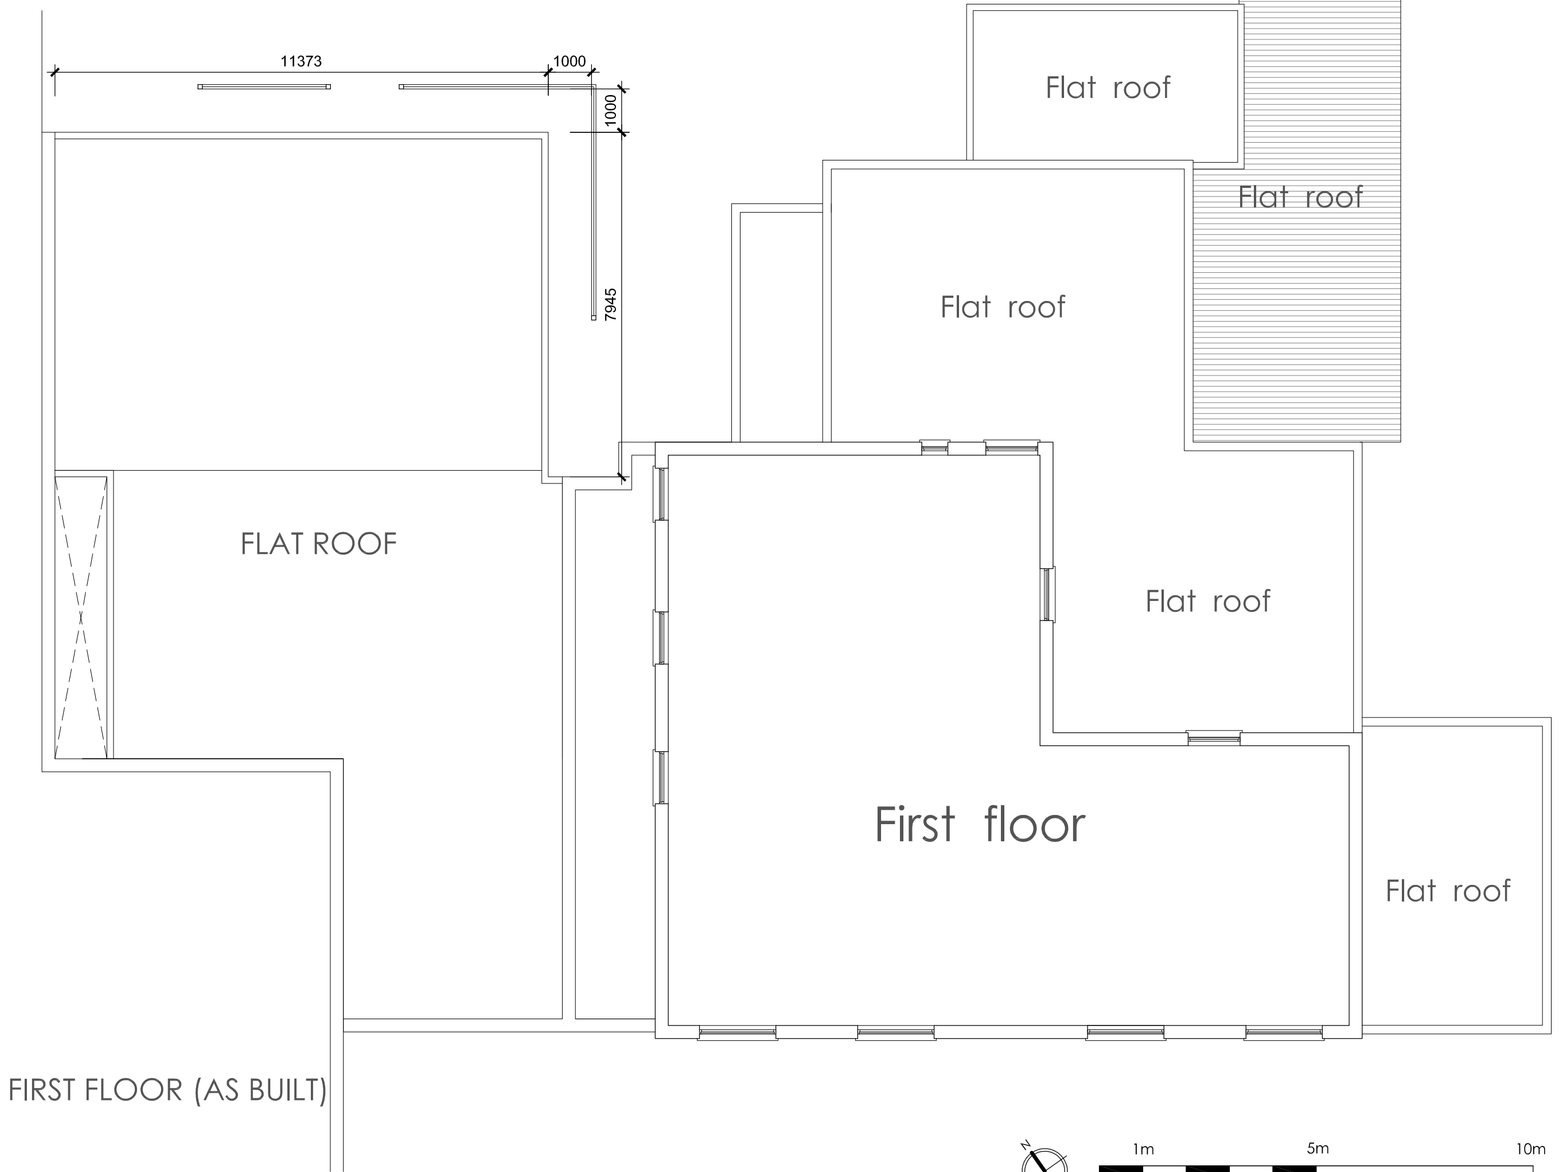

FIRST FLOOR (AS BUILT)

1m 5m 10m

PROJECT	DWG NO.	SCALE	DETAIL	15.09.2016						PROJECT NO.
TAMARA LOUNGE, 4 BYRON PARADE, UXBRIDGE ROAD PROPOSED TIMBER CANOPY	04	1:100 @ A1	AS BUILT FLOOR PLANS	SUBMITTED TO RETROSPECTIVE DEPT. HILLINGDON						15.53

PR Architecture ltd.
Chartered Architect
120, Pinner Road, Harrow, HA1 4JD.
Tel: 0208 357 2304