

FRONT ELEVATION 2



SIDE ELEVATION 1 / SECTION A-A'



REAR ELEVATION



SIDE ELEVATION 2 (AS BUILT)

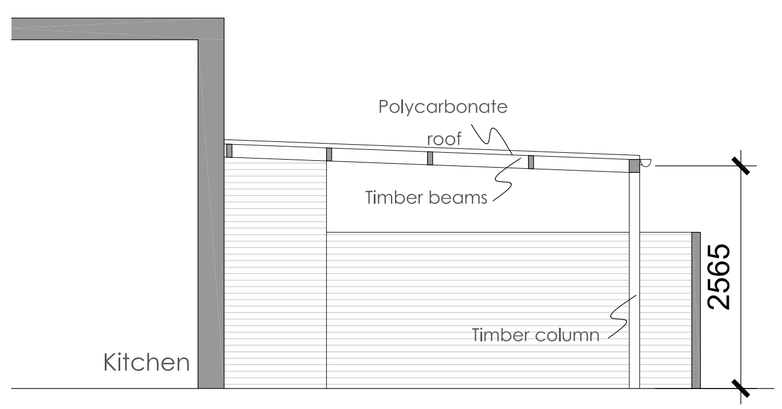

SECTION B-B' (AS BUILT)

PROJECT	DWG NO.	SCALE	DETAIL	15.09.2016						PROJECT NO.
TAMARA LOUNGE, 4 BYRON PARADE, UXBRIDGE ROAD PROPOSED TIMBER CANOPY	05	1:100/ 1:50 @ A1	AS BUILT ELEVATIONS AND SECTION	SUBMITTED TO RETROSPECTIVE DEPT. HILLINGDON						15.53

PR Architecture ltd.
Chartered Architect
120, Pinner Road, Harrow, HA1 4JD.
Tel: 0208 357 2304