


1 Proposed Site Plan - As Built  
1 : 150

2 Proposed Site Plan\_approved  
1 : 150

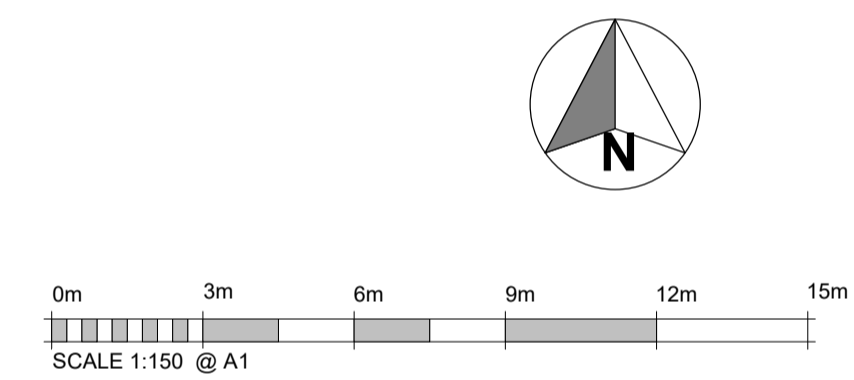

**J79 STUDIO**

T: +44 (0)7742 071 052  
W: info@j79studio.co.uk

Unit 312  
Wey House  
15 Church Street  
Weybridge  
KT13 8NA

**PLANNING ISSUE P1**

FOR CLIENT

CONFIRM ALL DESIGN WITH CLIENT ON SITE  
BUILDING CONTROL APPROVAL TBC  
ALL DIMENSION TO BE CHECKED ON SITE

This drawing is the property of J79 Studio. Copyright is reserved & this drawing is issued on the condition that it is not copied, reproduced, retained or disclosed to any unauthorised person, either wholly or in part, without our consent. Do not scale from this drawing, check all dimensions on site. Any errors please notify architect in the first instance.

Rev	Date	Note
P1	25-03-2026	PLANNING ISSUE 1

PROJECT  
30 Church Rd UB7 7PU

DRAWING TITLE  
PROPOSED SITE PLAN

STATUS  
2 X FLAT DEVELOPMENT

DRAWN BY  
Author

Checker

PROJECT NO.	DATE	SCALE
2003	MAR 2026	1:100 @ A1

DRAWING NO.	REVISION
A98	P1

HMO 6 PPL APR 2026