



April 4, 2025

Sweet Projects  
Union Park  
Hayes  
UB34QQ

**RE: Land at Bulls Bridge Industrial Estate North Hyde Gardens Hayes – SuDS Verification Information**

To Whom It May Concern,

HDR have been requested to draft a verification statement of the current design strategy and collate relevant SuDS details, as-built information, and certifications of manufacturers.

The following design information can be verified by HDR as compliant with the original planning application and documentation. This information was part of the design package provided to the contractor.

Block 3

- HDR-0473-SWS-BG-DR-C-520210 Rev P09
- HDR-0473-SWS-BG-DR-C-520211 Rev P10
- HDR-0473-SWS-BG-DR-C-520212 Rev P11
- HDR-0473-SWS-BG-DR-C-520215 Rev P01
- HDR-0473-SWS-BG-DR-C-520501 Rev P03
- HDR-0473-SWS-BG-DR-C-520502 Rev P03
- HDR-0473-SWS-BG-DR-C-520503 Rev P05
- HDR-0473-SWS-BG-DR-C-520504 Rev P04
- HDR-0473-SWS-BG-DR-C-520505 Rev P04
- HDR-0473-SWS-BG-SCH-C-520010 Rev P15
- HDR-0473-SWS-BG-SCH-C-520020 Rev P13

The above information has been appended to this letter.

The following information was provided by Sweet Projects as additional supporting information.



- TOU-0473-SW-BG-TS-X-0022\_Attenuation Tank – Stormwater Management
- TOU-0473-SW-BG-TS-X-0023\_Kingspan Klargester Class II Forecourt Separator
- TOU-0473-SW-XX-TS-X-0003\_Wavin TwinWall Surface and Stormwater Drainage Pipe

The above information has been appended to this letter.


Yours faithfully,  
HDR Consulting Limited

A handwritten signature in black ink that reads 'Groenewald'.

Ulrich Groenewald *MIET CEng*  
*Associate Director*

NOTES

1. DO NOT SCALE OFF THIS DRAWING. ALWAYS WORK TO NOTED DIMENSION.
2. ALL DIMENSIONS MUST BE VERIFIED ON SITE BEFORE COMPLETING SHOP DRAWINGS OR SETTING OUT OF THE WORKS.
3. THIS DRAWING IS TO BE READ IN CONJUNCTION WITH ALL OTHER DISCIPLINE'S DRAWINGS, REPORTS AND SPECIFICATIONS.
4. REFER TO GENERAL NOTES DRAWING HDR-0473-SWS-XX-TN-C-000025
5. REFER TO DRAWING SERIES  
HDR-0473-SWS-BG-DR-C-520... &  
HDR-0473-SWS-BG-SCH-C-520... FOR ASSOCIATED BELOW GROUND DRAINAGE DRAWINGS

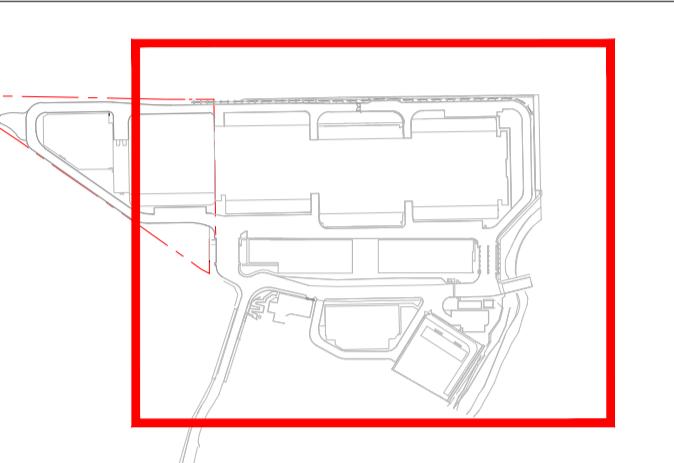

KEYPLAN



LEGEND

PLANNING BOUNDARY	
CONSTRUCTION BOUNDARY	
EXISTING SURFACE WATER	
EXISTING PRIVATE FOUL WATER	
EXISTING PUBLIC FOUL WATER	
PROPOSED SURFACE WATER	
PROPOSED BACK DROP	
PROPOSED FOUL WATER	
EXISTING THAMES VALLEY SEWER	
PERMEABLE PAVING CONNECTIONS	
RAINWATER & CHANNEL CONNECTIONS (RWP01.XX)	
DRAINAGE CHANNEL (CH01.XX, FWCH01.XX)	
SOIL VENT PIPE & FLOOR GULLY CONNECTIONS (SVP01.XX, FG01.XX)	
GULLY CONNECTION (GU01.XX)	
EXISTING GULLY CONNECTION (EXGU01.XX)	
SEWER NETWORK TO BE ABANDONED	
SWALE (SL01.XX)	
FILTRATION TRENCH (FT01.XX)	
LAND DRAIN (REFER DETAILS)	
SETTING OUT POINTS FOR SWALE, CHANNELS, TANKS	
RAIN WATER HARVESTING TANK	
POLYPipe PERMACEPTOR	

P09	STAGE 4 ISSUE	10/03/25
P08	STAGE 4 ISSUE	28/03/24
P07	STAGE 4 ISSUE	15/03/24
P06	STAGE 4 ISSUE	08/03/24
P05	STAGE 4 ISSUE	19/01/24
P04	STAGE 4 ISSUE	20/12/23
P03	STAGE 4 ISSUE	04/12/23
P02	STAGE 4 ISSUE	22/09/23
P01	STAGE 3 ISSUE	02/06/23
Rev	Description	Date

Drawing Status:	FOR APPROVAL	Suitability:	S4
-----------------	--------------	--------------	----



Client: SWEET PROJECTS

Architect: NWA

Project: UNION PARK

Title: BLOCK 3  
BELOW FINISHED GROUND LEVEL  
FOUL AND SURFACE DRAINAGE  
SITE LAYOUT

HDR Project Number: 10274713


Cad File Name: HDR-0473-SWS-BG-DR-C-520210

Drawn: AC Chkd/Appd: JJ/JUG Date: 10/03/25 Scale @ A1: 1:500

Drawing Number: HDR-0473-SWS-BG-DR-C-520210 Revision: P09

NOTES

1. DO NOT SCALE OFF THIS DRAWING. ALWAYS WORK TO NOTED DIMENSION.
2. ALL DIMENSIONS MUST BE VERIFIED ON SITE BEFORE COMPLETING SHOP DRAWINGS OR SETTING OUT OF THE WORKS.
3. THIS DRAWING IS TO BE READ IN CONJUNCTION WITH ALL OTHER DISCIPLINE'S DRAWINGS, REPORTS AND SPECIFICATIONS.
4. REFER TO GENERAL NOTES DRAWING HDR-0473-SWS-XX-C-000025
5. REFER TO DRAWING SERIES HDR-0473-SWS-BG-DR-C-520... & HDR-0473-SWS-BG-SCH-C-520... FOR ASSOCIATED BELOW GROUND DRAINAGE DRAWINGS

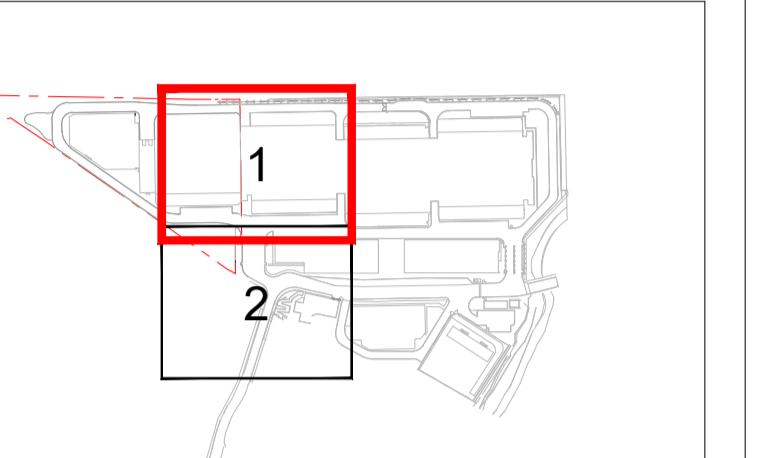

KEYPLAN

LEGEND

PLANNING BOUNDARY	
CONSTRUCTION BOUNDARY	
EXISTING SURFACE WATER	
EXISTING PRIVATE FOUL WATER	
EXISTING PUBLIC FOUL WATER	
PROPOSED SURFACE WATER	
PROPOSED BACK DROP	
PROPOSED FOUL WATER	
EXISTING THAMES VALLEY SEWER	
PERMEABLE PAVING CONNECTIONS	
RAINWATER & CHANNEL CONNECTIONS (RWP01.XX)	
DRAINAGE CHANNEL (CH01.XX, FWCH01.XX)	
SOIL VENT PIPE & FLOOR GULLY CONNECTIONS (SPV01.XX, FG01.XX)	
GULLY CONNECTION (GU01.XX)	
EXISTING GULLY CONNECTION (EXGU01.XX)	
SEWER NETWORK TO BE ABANDONED	
SWALE (SL01.XX)	
FILTRATION TRENCH (FT01.XX)	
LAND DRAIN (REFER DETAILS)	
SETTING OUT POINTS FOR SWALE, CHANNELS, TANKS	
RAIN WATER HARVESTING TANK	
POLYPipe PERMACEPTOR	

P10	STAGE 4 ISSUE	10/03/25
P09	STAGE 4 ISSUE	28/03/24
P08	STAGE 4 ISSUE	08/03/24
P07	STAGE 4 ISSUE	21/02/24
P06	STAGE 4 ISSUE	06/02/24
P05	STAGE 4 ISSUE	19/01/24
P04	STAGE 4 ISSUE	20/12/23
P03	STAGE 4 ISSUE	04/12/23
P02	STAGE 4 ISSUE	22/09/23
P01	STAGE 3 ISSUE	02/06/23
Rev	Description	Date

Drawing Status: **FOR APPROVAL** Suitability: **S4**

**HDR** 4TH FLOOR  
KNOLLYS HOUSE  
17 ADDINGTON ROAD  
CROYDON CR0 6SR  
UNITED KINGDOM  
t: +44 (0) 20 8763 5900  
e: info@drinc.com  
w: www.drinc.com

Client: **SWEET PROJECTS**

Architect: **NWA**

Project: **UNION PARK**

Title: **BLOCK 3  
BELOW FINISHED GROUND LEVEL  
FOUL AND SURFACE DRAINAGE  
LAYOUT SHEET 1 OF 2**

HDR Project Number: **10274713**

Cad File Name: **HDR-0473-SWS-BG-DR-C-520211**


Drawn: **AC** Checked/Approved: **JJ/JUG** Date: **10/03/25** Scale @ A1: **1:200**

Drawing Number: **HDR-0473-SWS-BG-DR-C-520211** Revision: **P10**

© THIS DRAWING IS THE COPYRIGHT PROPERTY OF  
HDR AND IS THEREFORE CONFIDENTIAL AND MUST  
NOT BE LENT, COPIED, REPRODUCED IN ANY WAY  
 WHATSOEVER WITHOUT WRITTEN PERMISSION.

## NOTES

- DO NOT SCALE OFF THIS DRAWING. ALWAYS WORK TO NOTED DIMENSION.
- ALL DIMENSIONS MUST BE VERIFIED ON SITE BEFORE COMPLETING SHOP DRAWINGS OR SETTING OUT OF THE WORKS.
- THIS DRAWING IS TO BE READ IN CONJUNCTION WITH ALL OTHER DISCIPLINE'S DRAWINGS, REPORTS AND SPECIFICATIONS.
- REFER TO GENERAL NOTES DRAWING  
HDR-0473-SWS-XX-TN-C-000025
- REFER TO DRAWING SERIES  
HDR-0473-SWS-BG-DR-C-520... &  
HDR-0473-SWS-BG-SCH-C-520... FOR ASSOCIATED  
BELOW GROUND DRAINAGE DRAWINGS

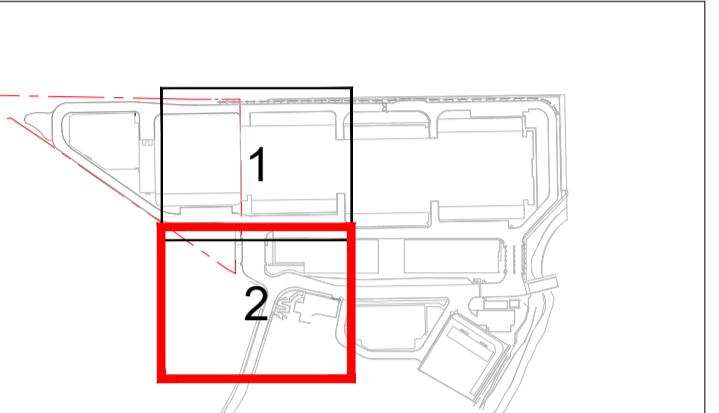

## KEYPLAN

## LEGEND

PLANNING BOUNDARY	
CONSTRUCTION BOUNDARY	
EXISTING SURFACE WATER	EX-SW
EXISTING PRIVATE FOUL WATER	EX-FW
EXISTING PUBLIC FOUL WATER	EX-FW
PROPOSED SURFACE WATER	
PROPOSED BACK DROP	BD
PROPOSED FOUL WATER	
EXISTING THAMES VALLEY SEWER	TVS
PERMEABLE PAVING CONNECTIONS	PP03.XX
RAINWATER & CHANNEL CONNECTIONS (RWP01.XX)	RWP03.XX
DRAINAGE CHANNEL (CH01.XX,FWCH01.XX)	CH
SOIL VENT PIPE & FLOOR GULLY CONNECTIONS (SVP01.XX,FG01.XX)	
GULLY CONNECTION (GU01.XX)	
EXISTING GULLY CONNECTION (EXGU01.XX)	
SEWER NETWORK TO BE ABANDONED	
SWALE (SL01.XX)	
FILTRATION TRENCH (FT01.XX)	
LAND DRAIN (REFER DETAILS)	
SETTING OUT POINTS FOR SWALE, CHANNELS, TANKS	
RAIN WATER HARVESTING TANK	
POLYPIPE PERMACEPTOR	PC03.XX



# Gantry

Ref	Description	Date
P11	STAGE 4 ISSUE	10/03/25
P10	STAGE 4 ISSUE	12/07/24
P09	STAGE 4 ISSUE	14/06/24
P08	STAGE 4 ISSUE	28/03/24
P07	STAGE 4 ISSUE	15/03/24
P06	STAGE 4 ISSUE	21/02/24
P05	STAGE 4 ISSUE	06/02/24
P04	STAGE 4 ISSUE	19/01/24
P03	STAGE 4 ISSUE	20/12/23
P02	STAGE 4 ISSUE	22/09/23
P01	STAGE 3 ISSUE	06/02/23

awing Status:

DOOR  
YS HOUSE  
ISCOMBE ROAD  
ON, CR0 6SR  
KINGDOM  
(0) 20 8763 5900  
[@hdrinc.com  
\[www.hdrinc.com\]\(http://www.hdrinc.com\)](mailto:@hdrinc.com)

ent:  

Architect:

NWA

## UNION PARK

le:

**BLOCK 3**

**BELOW FINISHED GROUND LEVEL**





**FOUL AND SURFACE DRAINAGE**

**LAYOUT SHEET 2 OF 2**

DR Project Number:	10274713		
drd File Name:	HDR-0473-SWS-BG-DR-C-520212		
Owner:	Chkd/Appd:	Date:	Scale @ A1:
AC	JJ/UG	10/03/25	1:200
Drawing Number:			Revision:
HDR-0473-SWS-BG-DR-C-520212			P11

NOTES

1. DO NOT SCALE OFF THIS DRAWING. ALWAYS WORK TO NOTED DIMENSION.
2. ALL DIMENSIONS MUST BE VERIFIED ON SITE BEFORE COMPLETING SHOP DRAWINGS OR SETTING OUT OF THE WORKS.
3. THIS DRAWING IS TO BE READ IN CONJUNCTION WITH ALL OTHER DISCIPLINE'S DRAWINGS, REPORTS AND SPECIFICATIONS.
4. REFER TO GENERAL NOTES DRAWING HDR-0473-SWS-XX-TN-C-000025

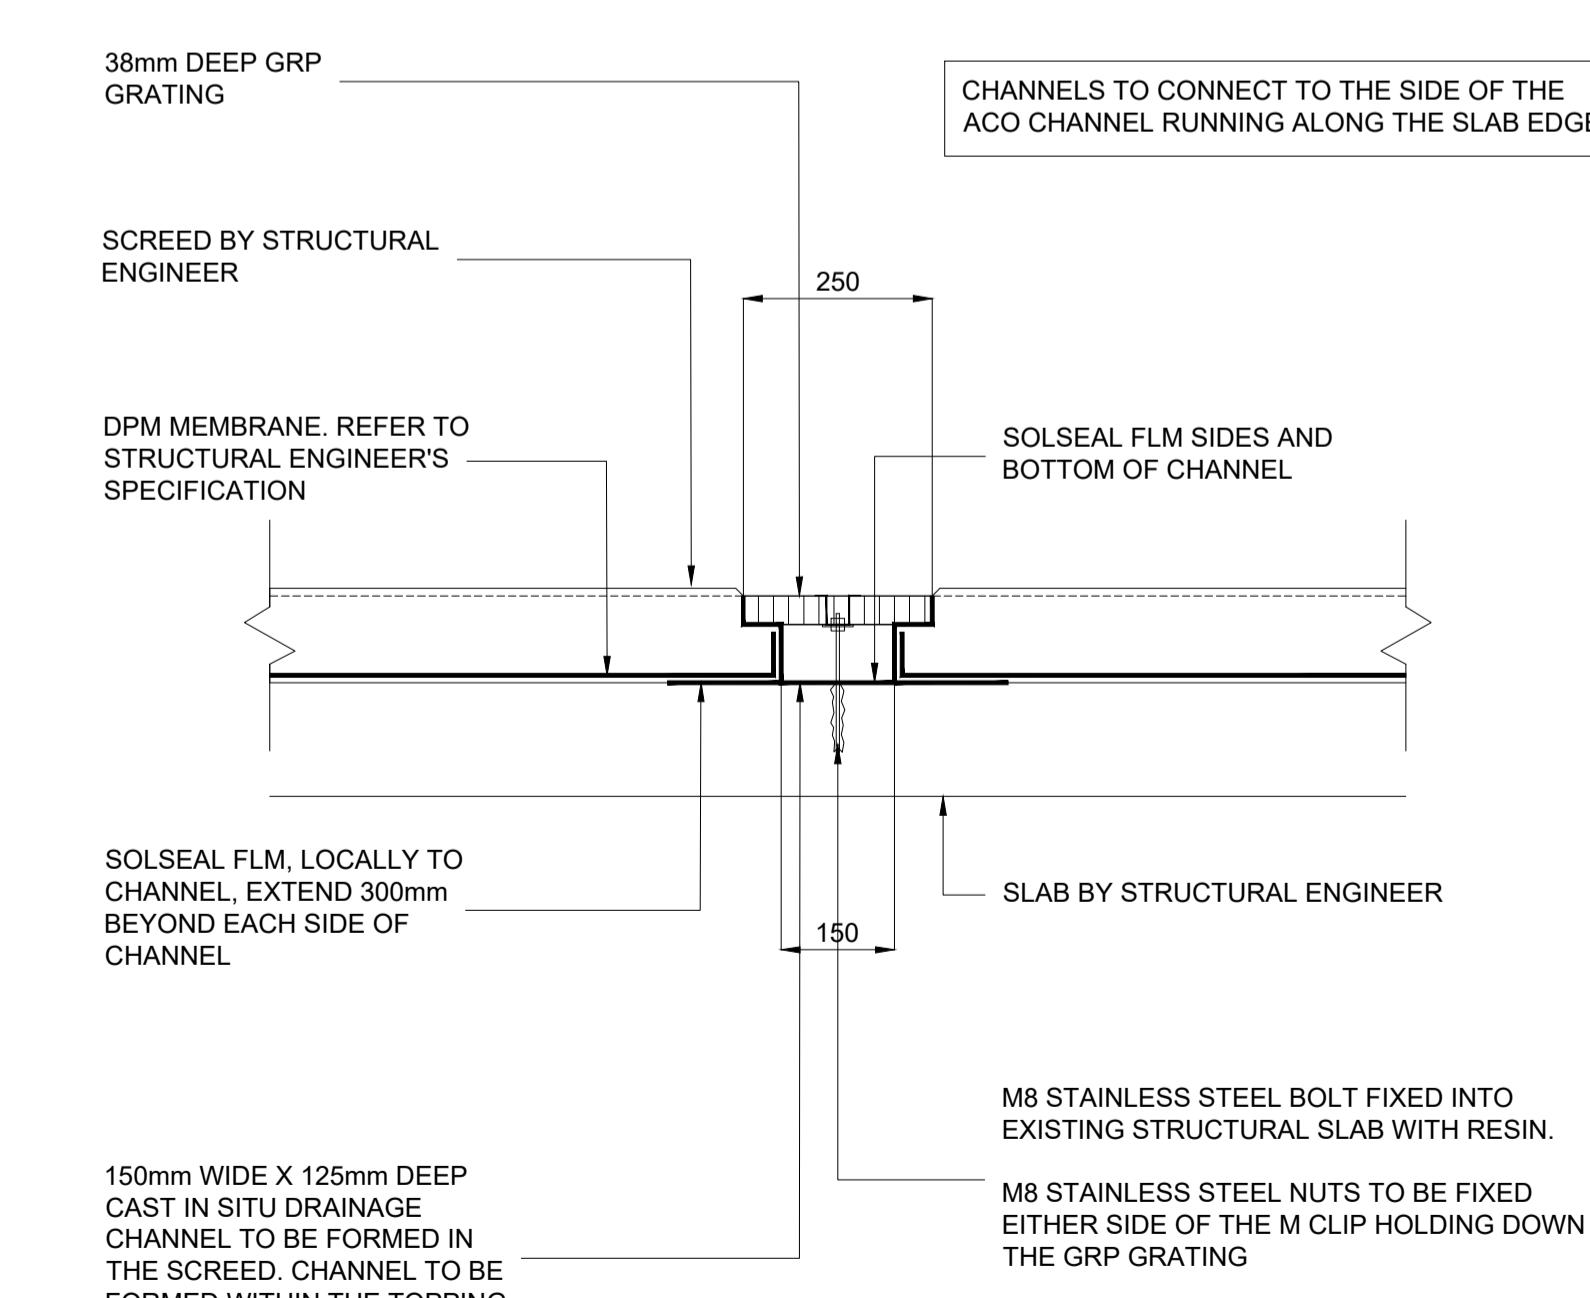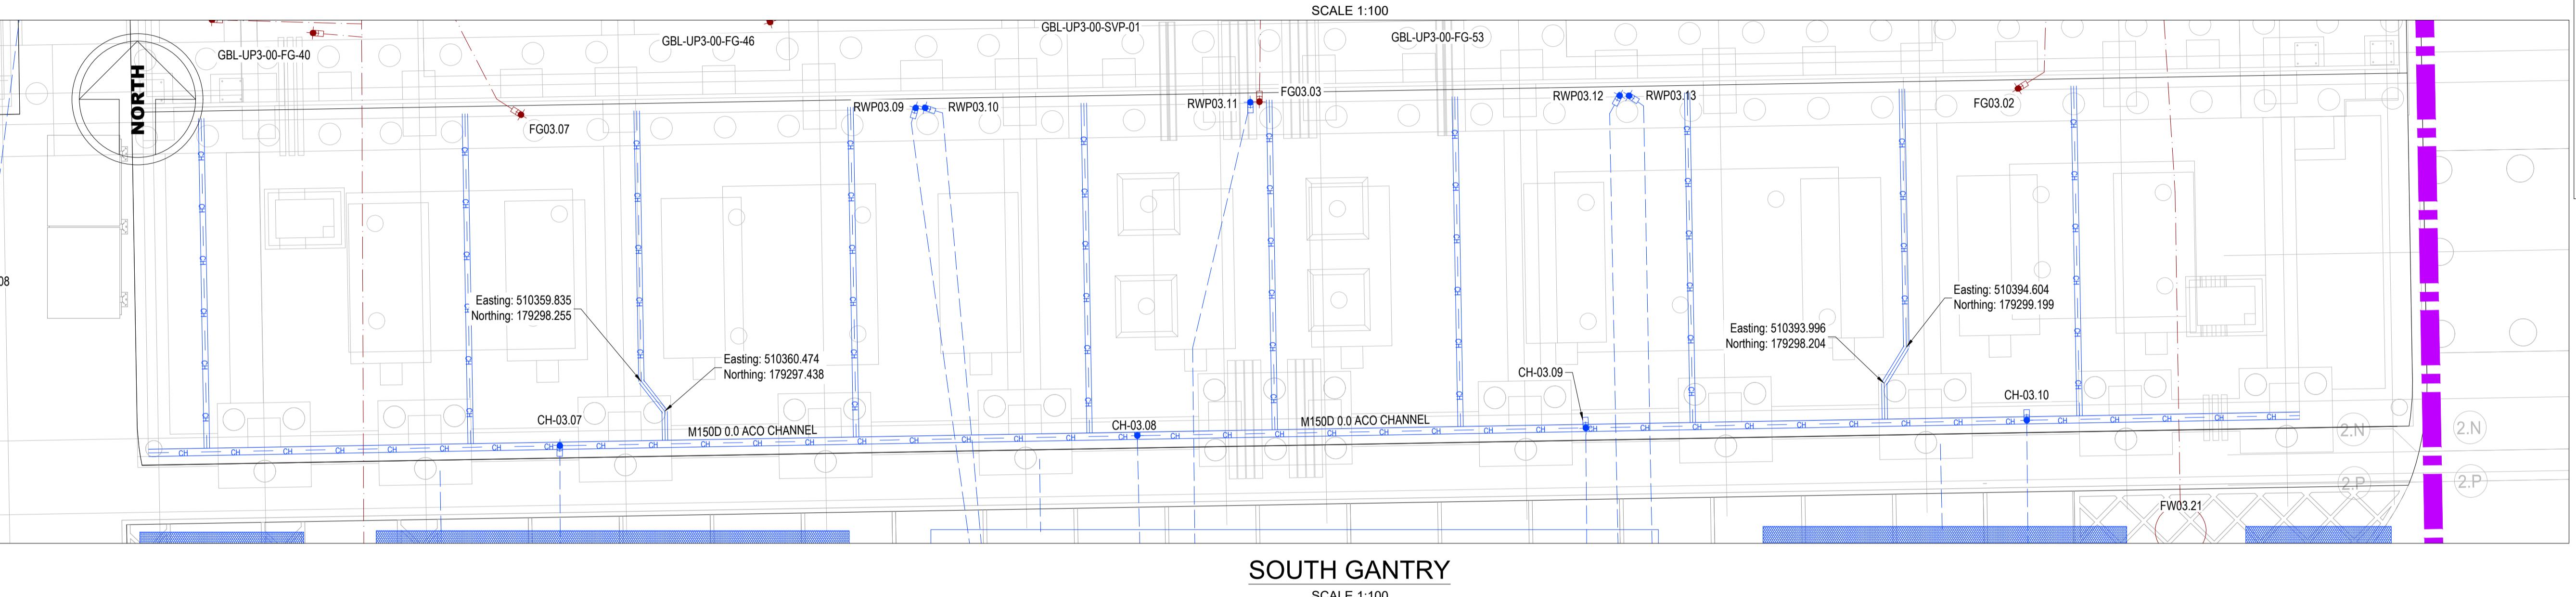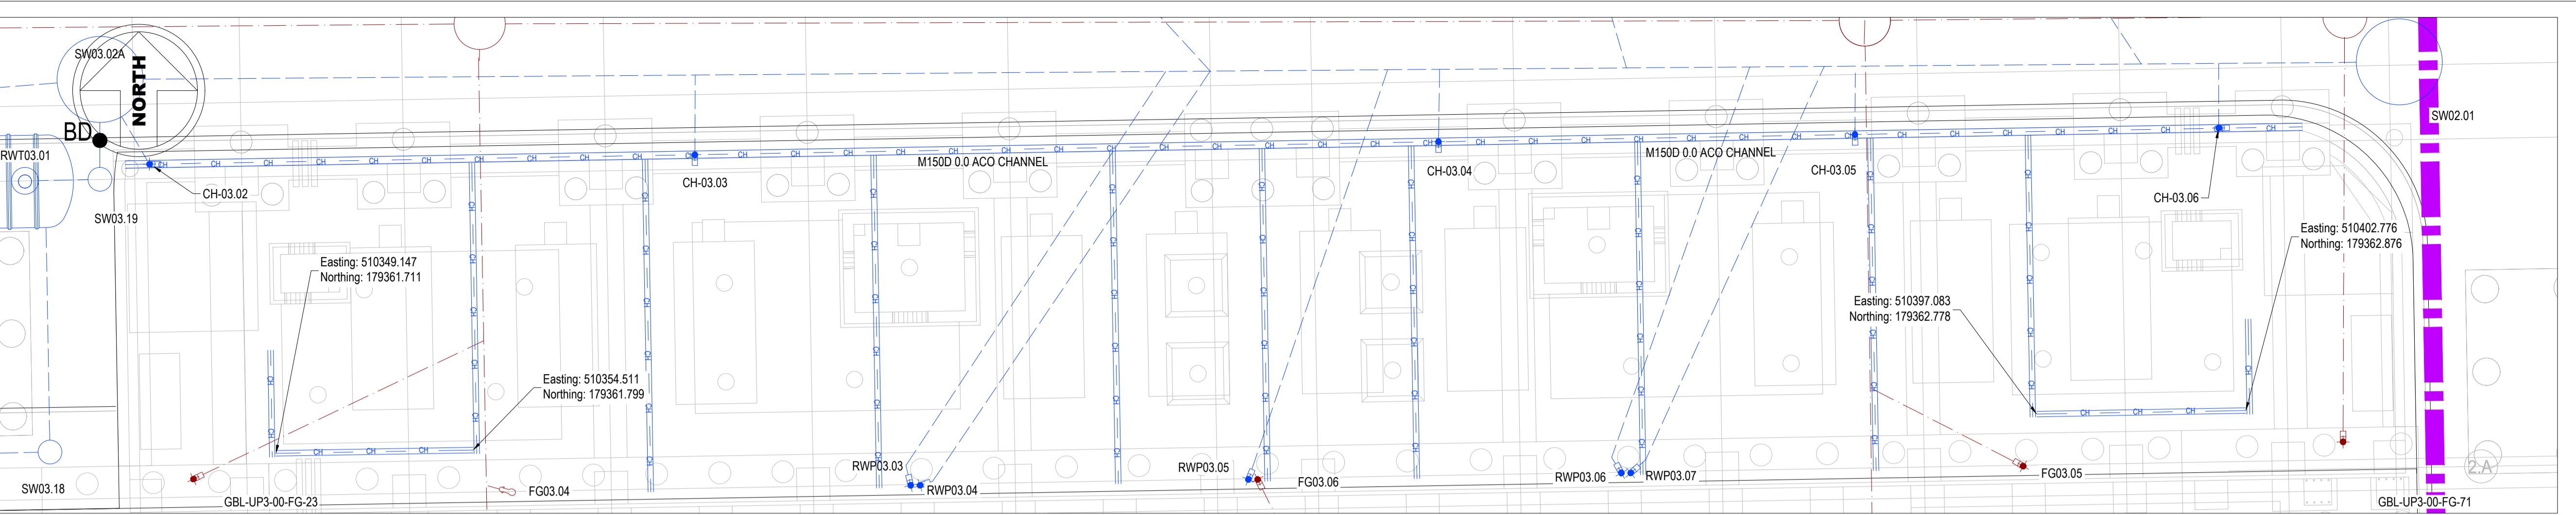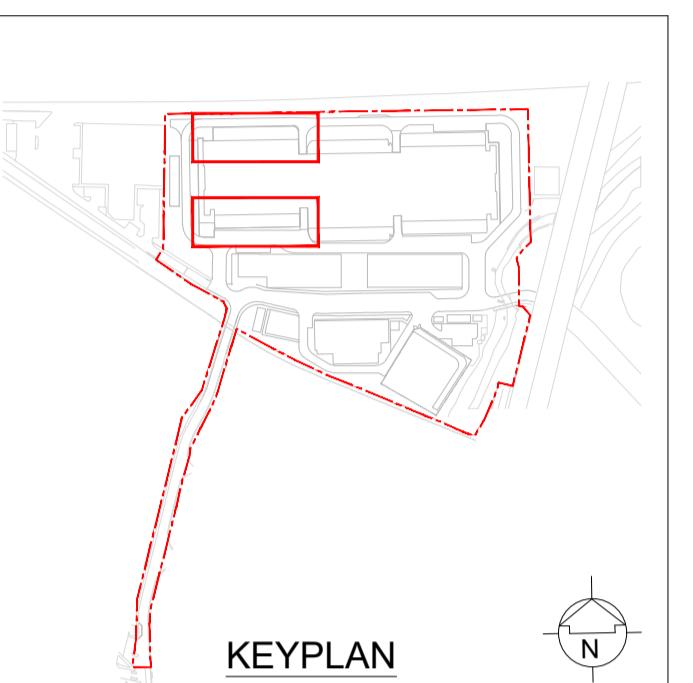

**DRAINAGE CHANNEL SECTION**

SCALE 1:10

**LEGEND**

PLANNING BOUNDARY	
CONSTRUCTION BOUNDARY	
EXISTING SURFACE WATER	
EXISTING PRIVATE FOUL WATER	
EXISTING PUBLIC FOUL WATER	
PROPOSED SURFACE WATER	
PROPOSED BACK DROP	
PROPOSED FOUL WATER	
EXISTING THAMES VALLEY SEWER	
PERMEABLE PAVING CONNECTIONS	
RAINWATER & CHANNEL CONNECTIONS (RWP01.XX)	
DRAINAGE CHANNEL (CH01.XX, FWCH01.XX)	
SOIL VENT PIPE & FLOOR GULLY CONNECTIONS (SVP01.XX, FG01.XX)	
GULLY CONNECTION (GU01.XX)	

P01	STAGE 4 ISSUE	14/05/24
Rev	Description	Date
Drawing Status:	FOR APPROVAL	S4








Client:	SWEET PROJECTS
Architect:	NWA
Project:	UNION PARK
Title:	BLOCK 3 BELOW FINISHED GROUND LEVEL GANTRY DRAINAGE LAYOUT

HDR Project Number:	10274713
Cad File Name:	HDR-0473-SWS-BG-DR-C-520215
Drawn:	AC
Chkd/Appd:	JJ/JUG
Date:	14/05/24
Scale @ A1:	1:100
Drawing Number:	HDR-0473-SWS-BG-DR-C-520215
Revision:	P01

NOTES

1. DO NOT SCALE OFF THIS DRAWING. ALWAYS WORK TO NOTED DIMENSION.
2. ALL DIMENSIONS MUST BE VERIFIED ON SITE BEFORE COMPLETING SHOP DRAWINGS OR SETTING OUT OF THE WORKS.
3. THIS DRAWING IS TO BE READ IN CONJUNCTION WITH ALL OTHER DISCIPLINE'S, REPORTS AND SPECIFICATIONS.
4. REFER TO GENERAL NOTES DRAWING HDR-0473-SWS-XX-TN-C-000025
5. REFER TO DRAWING SERIES HDR-0473-SWS-BG-DR-C-520... & HDR-0473-SWS-BG-SCH-C-520... FOR ASSOCIATED BELOW GROUND DRAINAGE DRAWINGS

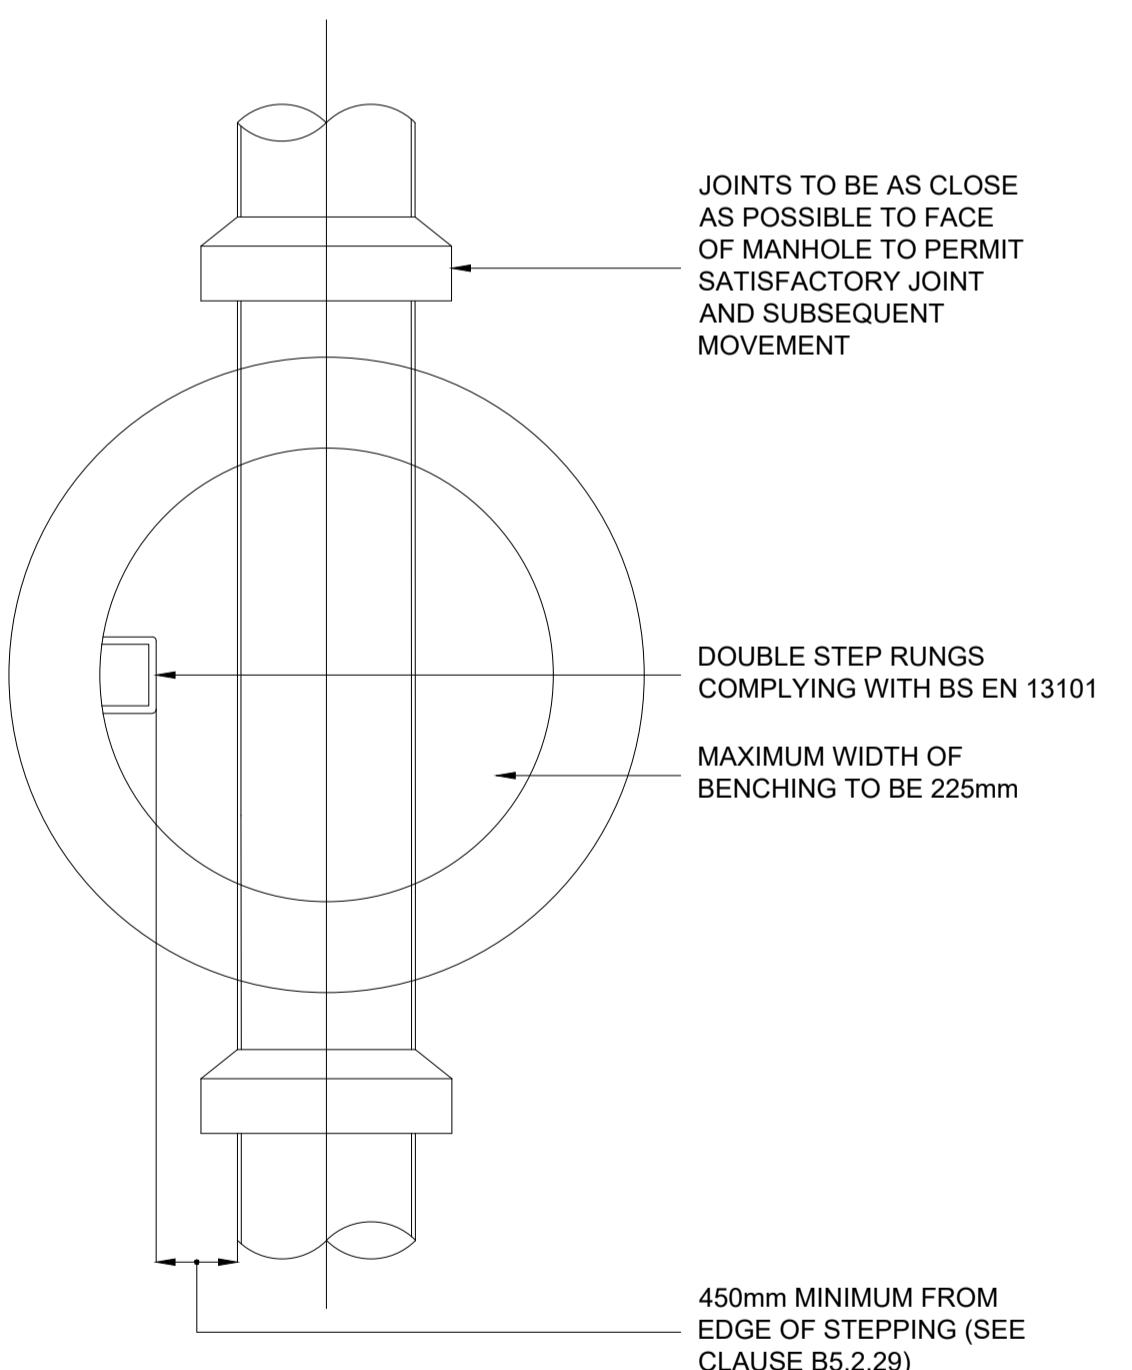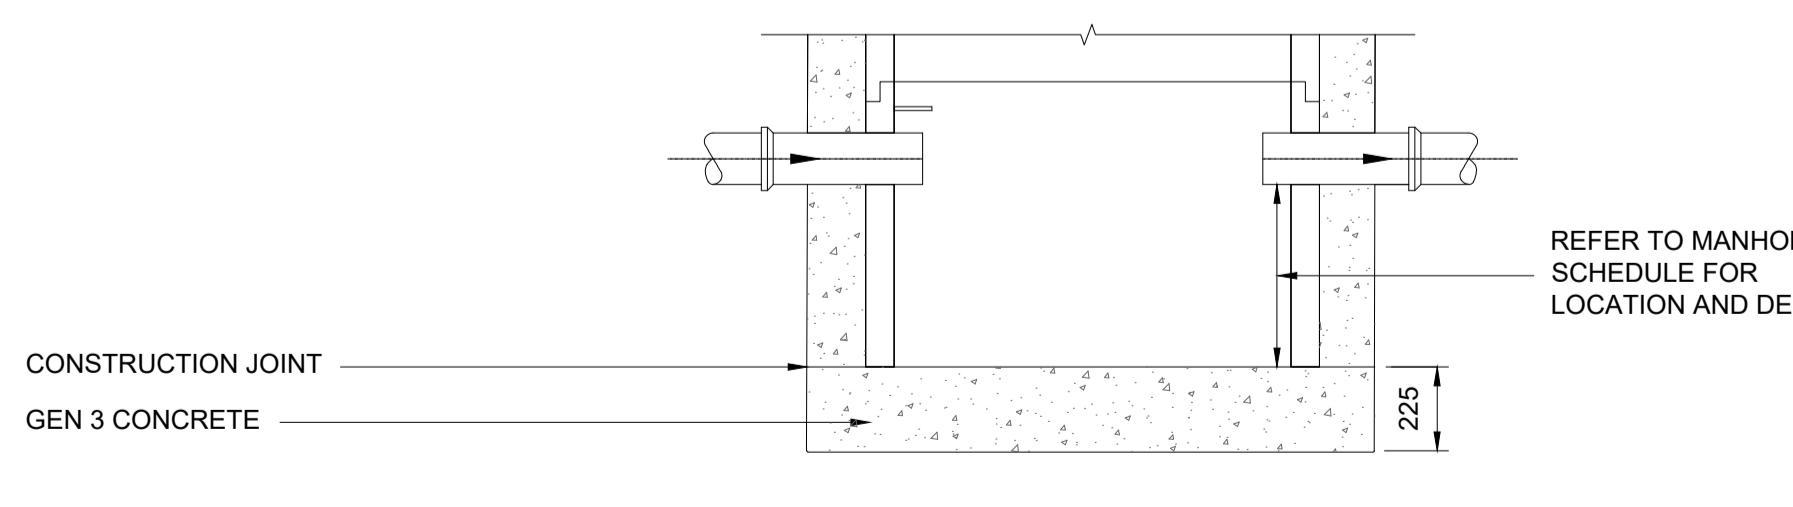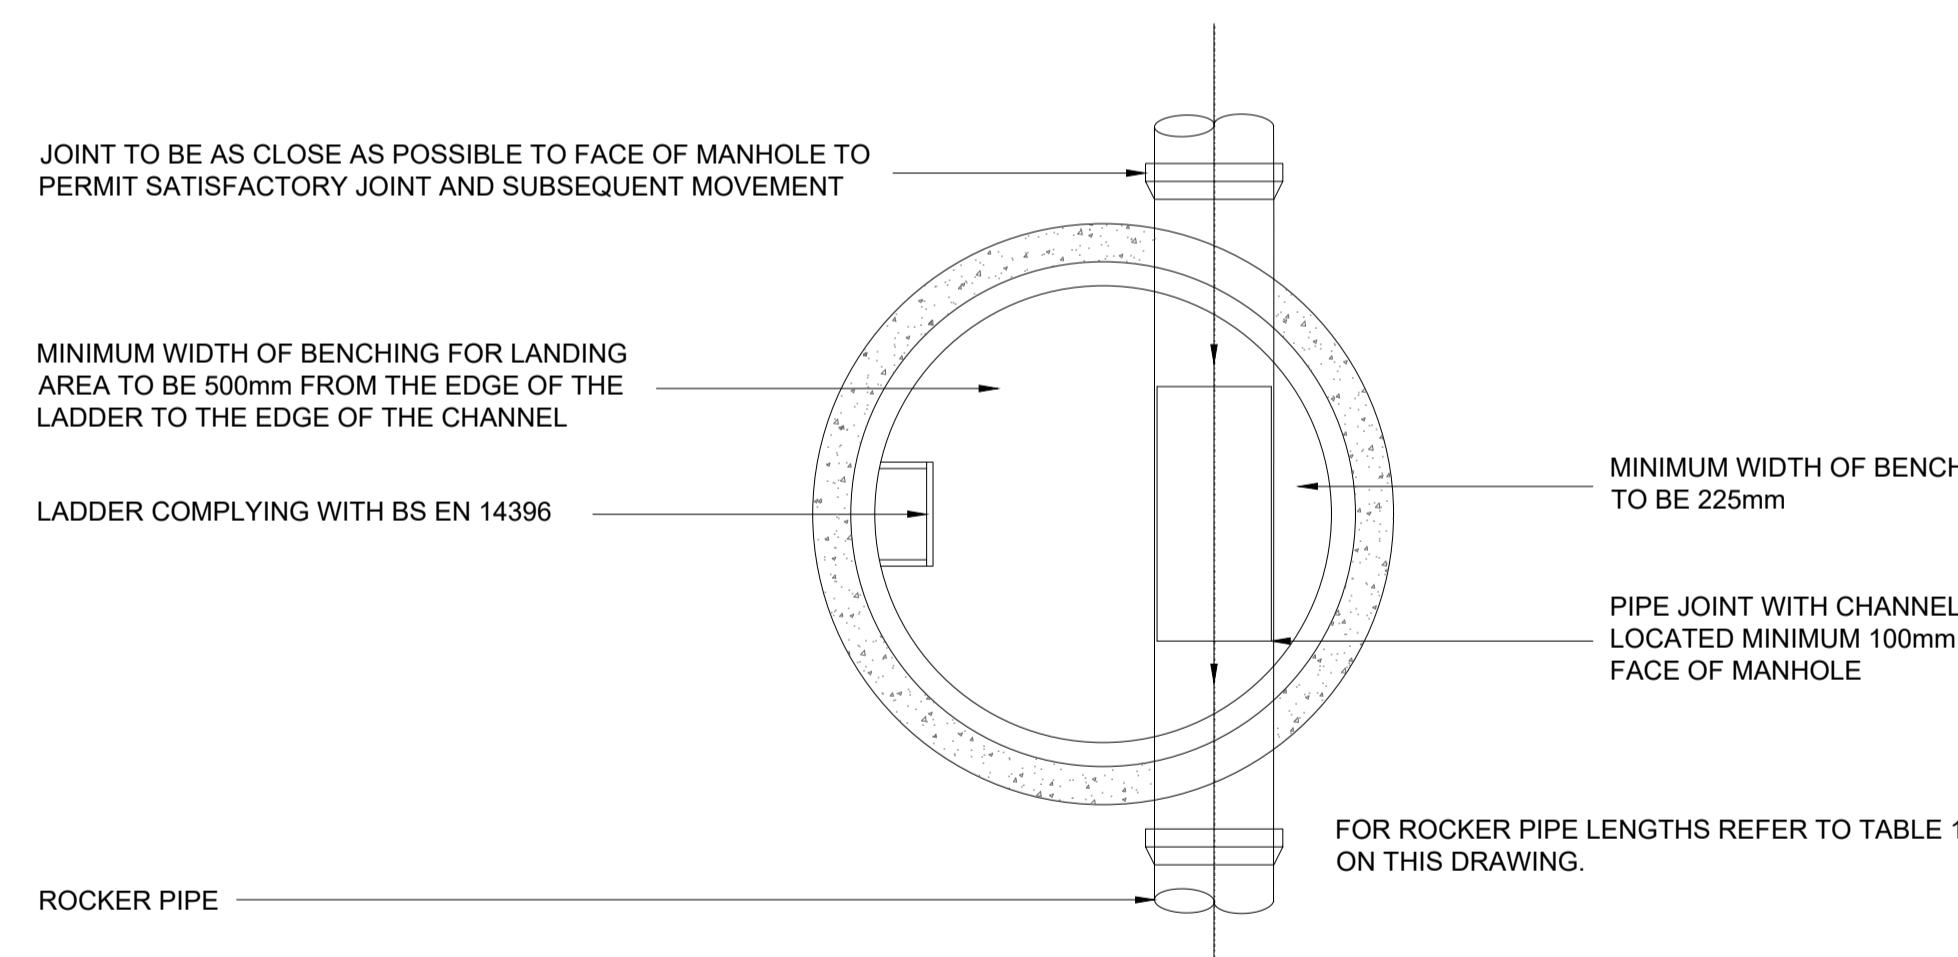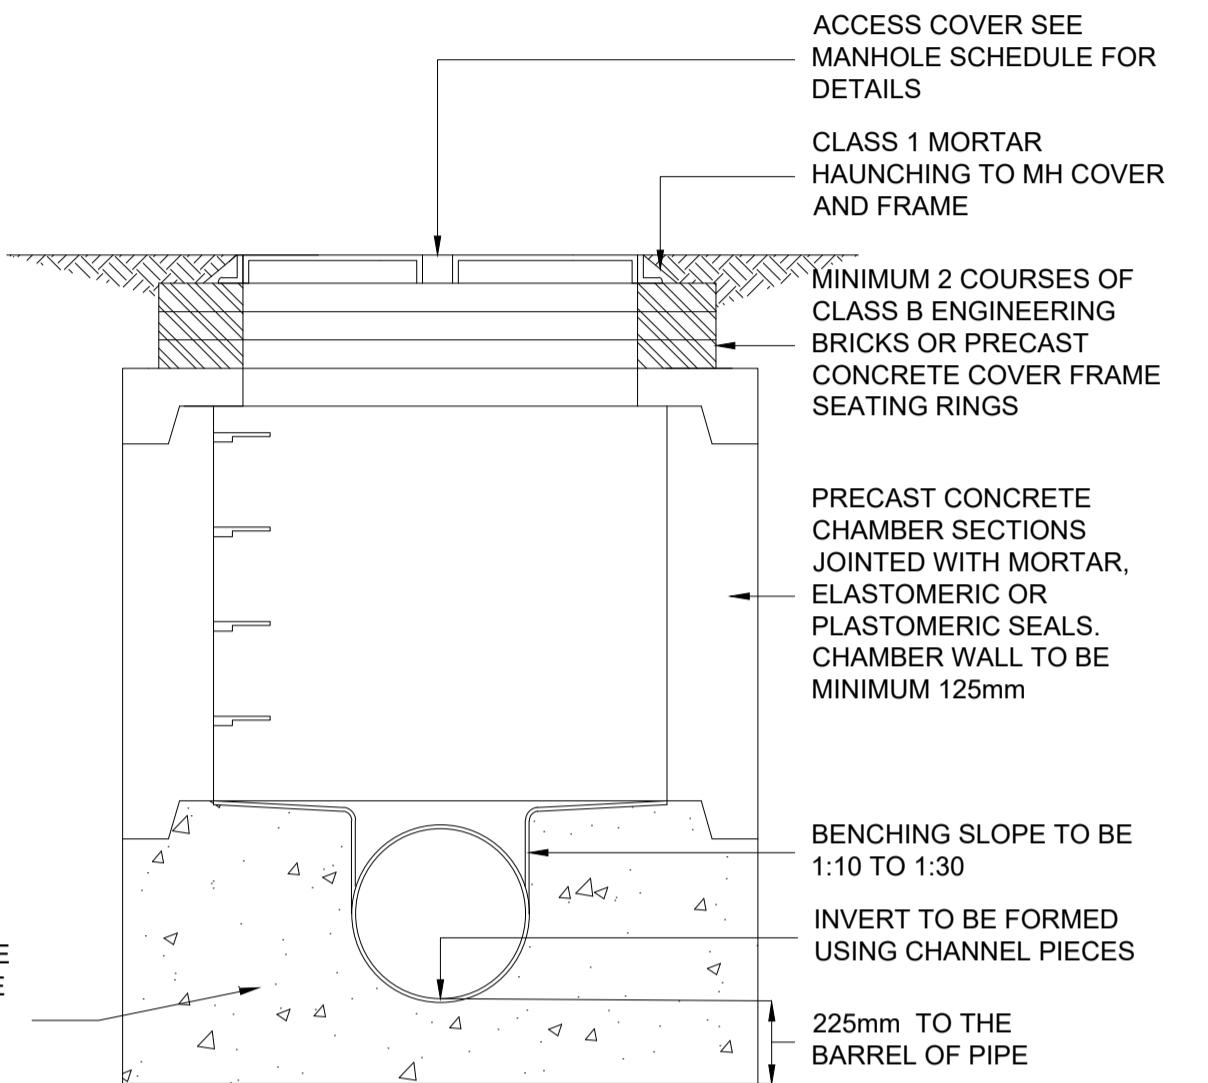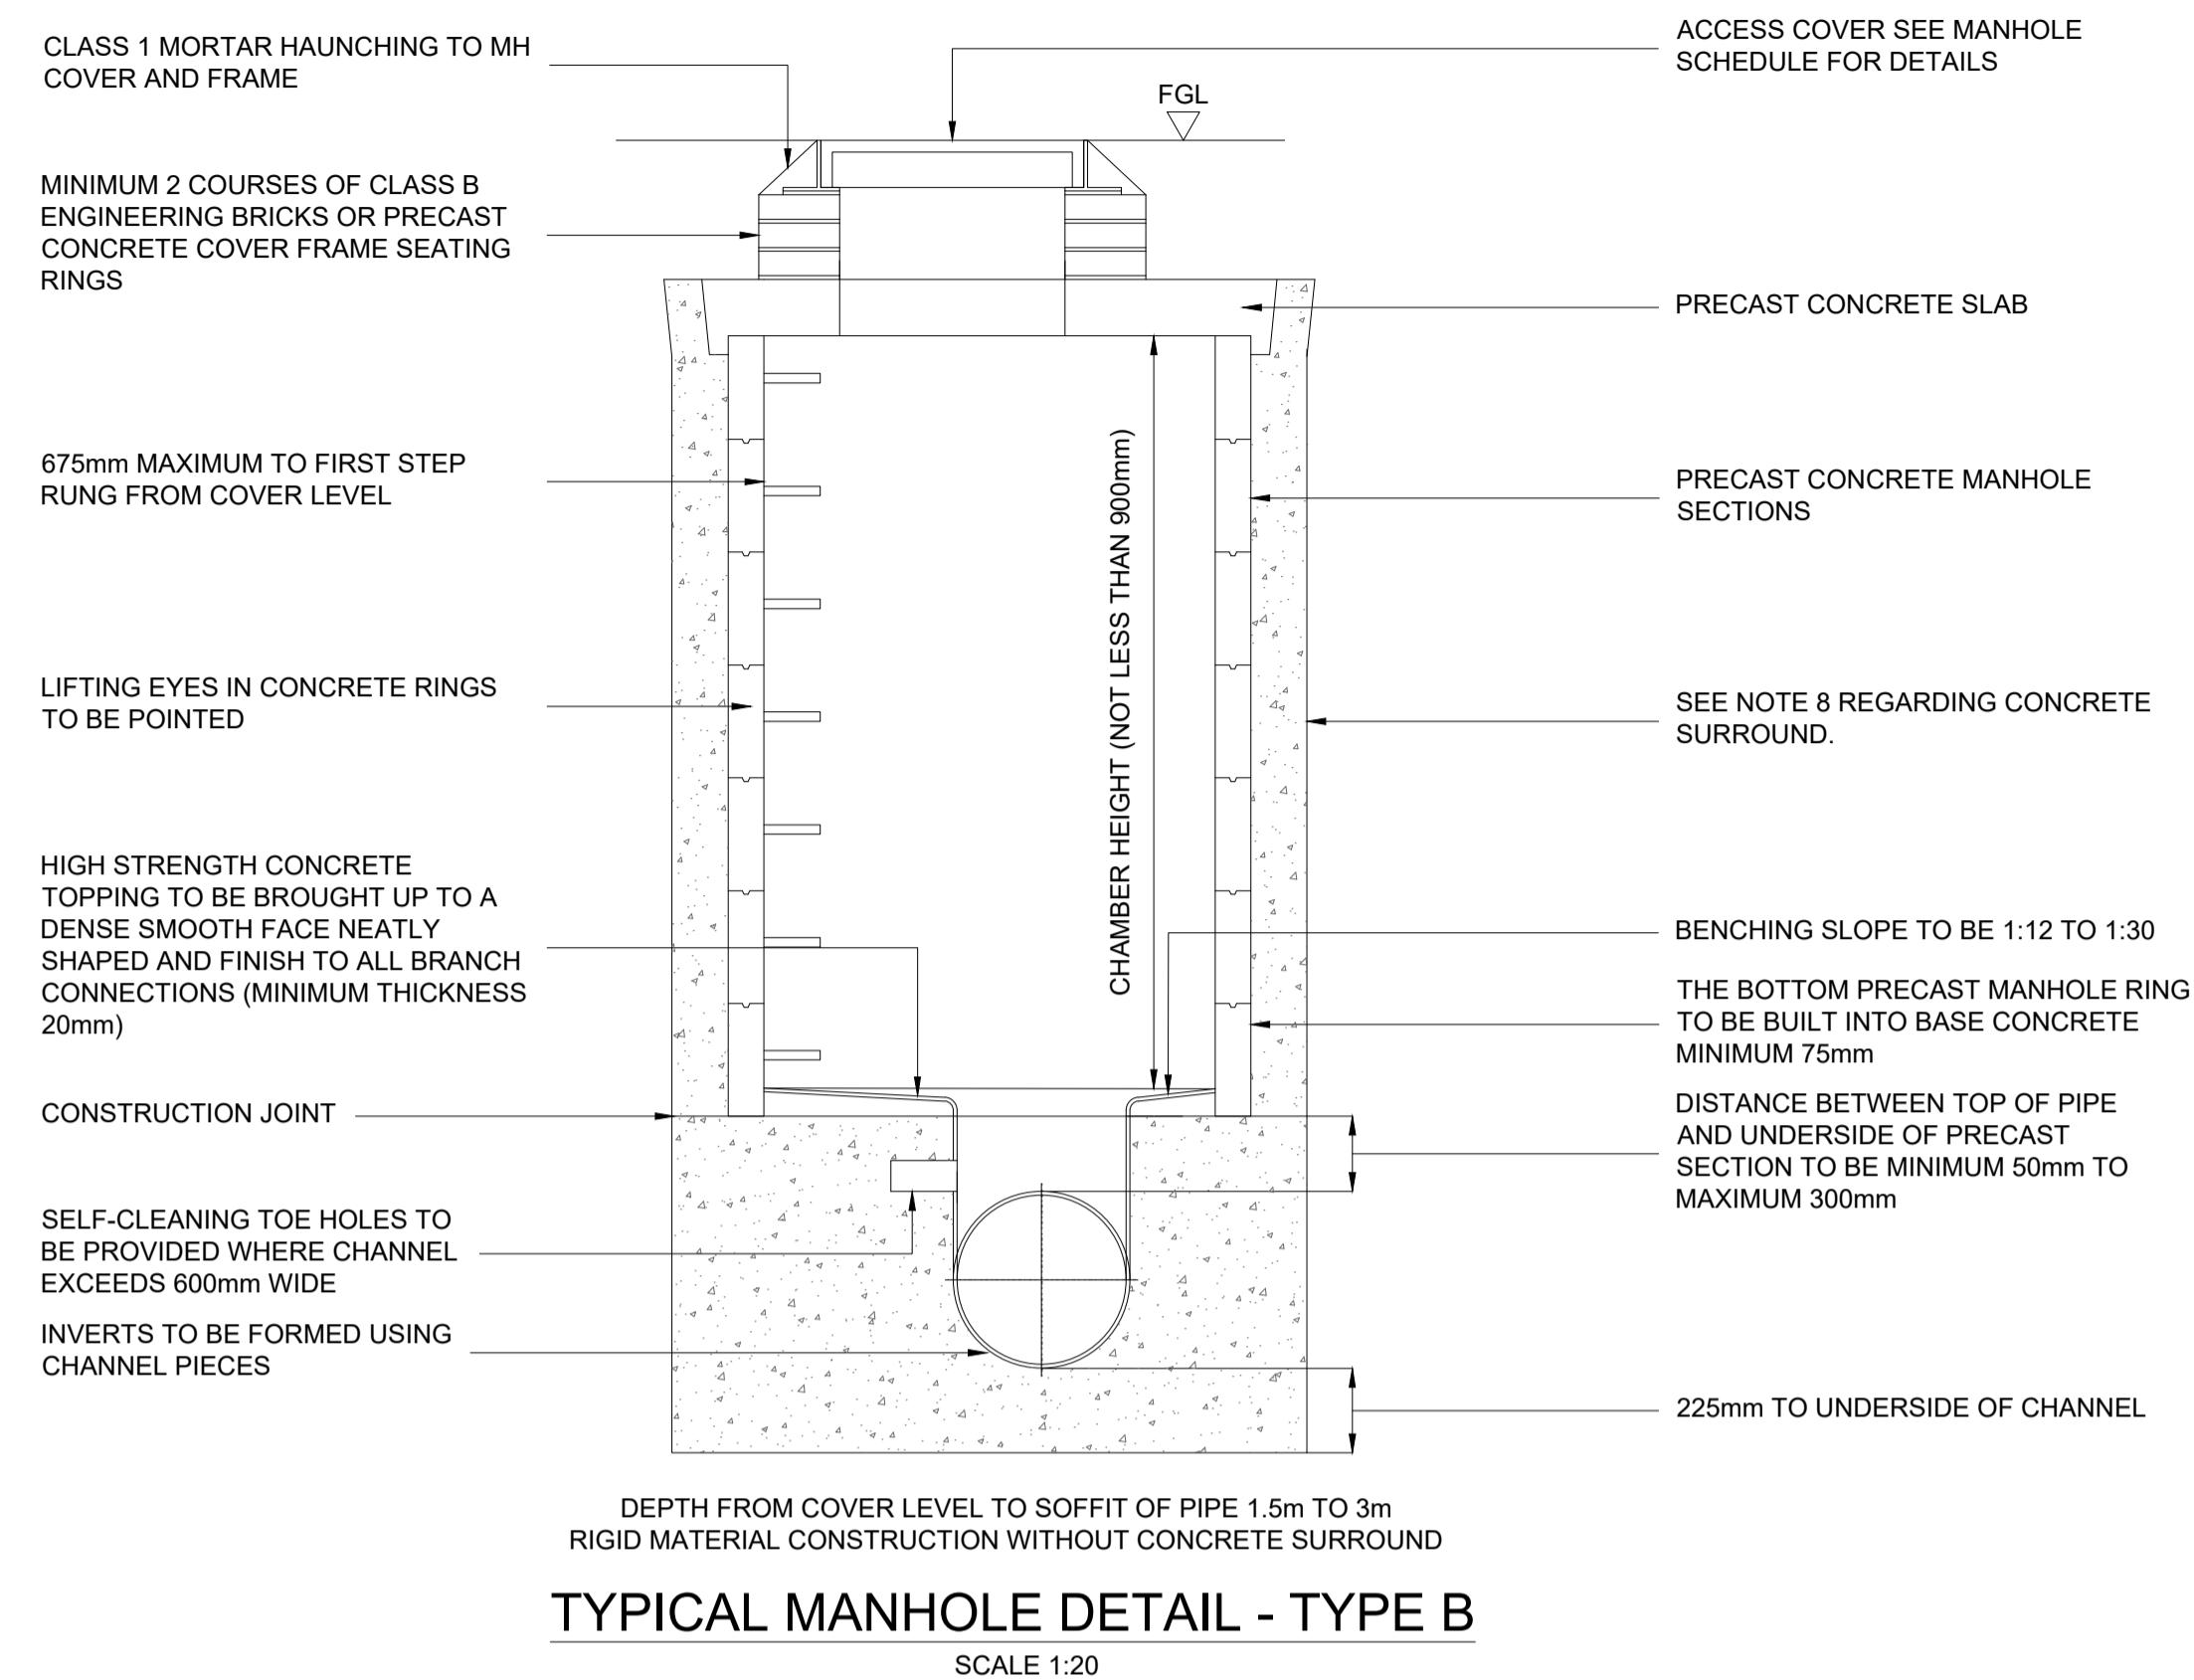

**TYPICAL MANHOLE DETAIL - TYPE C**  
DEPTH FROM COVER LEVEL TO SOFFIT OF PIPE <1.5m FLEXIBLE MATERIAL CONSTRUCTION FOR USE IN AREAS SUBJECT TO VEHICLE LOADING (SCALE 1:20)

P03	STAGE 4 ISSUE	04/12/23
P02	STAGE 4 ISSUE	22/09/23
P01	STAGE 3 ISSUE	04/12/23
Rev	Description	Date
Drawing Status:		Suitability:
FOR APPROVAL		S4


4TH FLOOR  
KNOLLYS HOUSE  
17 ADDINGTON ROAD  
CROXTON, CROY 6SR  
UNITED KINGDOM  
t: +44 (0) 20 8763 5900  
e: info@drinc.com  
w: www.hdrinc.com

Client:	SWEET PROJECTS
Architect:	NWA
Project:	UNION PARK
Title:	BLOCK 3 BELOW FINISHED GROUND LEVEL DRAINAGE TYPICAL DETAILS SHEET 1 OF 5
HDR Project Number:	10274713
Cad File Name:	HDR-0473-SWS-BG-DR-C-520501
Drawn:	RJJ
Chkd/Appd:	JJ/JUG
Date:	04/12/23
Scale @ A1:	AS SHOWN
Drawing Number:	HDR-0473-SWS-BG-DR-C-520501
Revision:	P03




NOTES


1. DO NOT SCALE OFF THIS DRAWING. ALWAYS WORK TO NOTED DIMENSION.
2. ALL DIMENSIONS MUST BE VERIFIED ON SITE BEFORE COMPLETING SHOP DRAWINGS OR SETTING OUT OF THE WORKS.
3. THIS DRAWING IS TO BE READ IN CONJUNCTION WITH ALL OTHER DISCIPLINE'S DRAWINGS, REPORTS AND SPECIFICATIONS.
4. REFER TO GENERAL NOTES DRAWING HDR-0473-SWS-XX-TN-C-000025
5. REFER TO DRAWING SERIES  
HDR-0473-SWS-BG-DR-C-520... &  
HDR-0473-SWS-BG-SCH-C-520... FOR ASSOCIATED BELOW GROUND DRAINAGE DRAWINGS

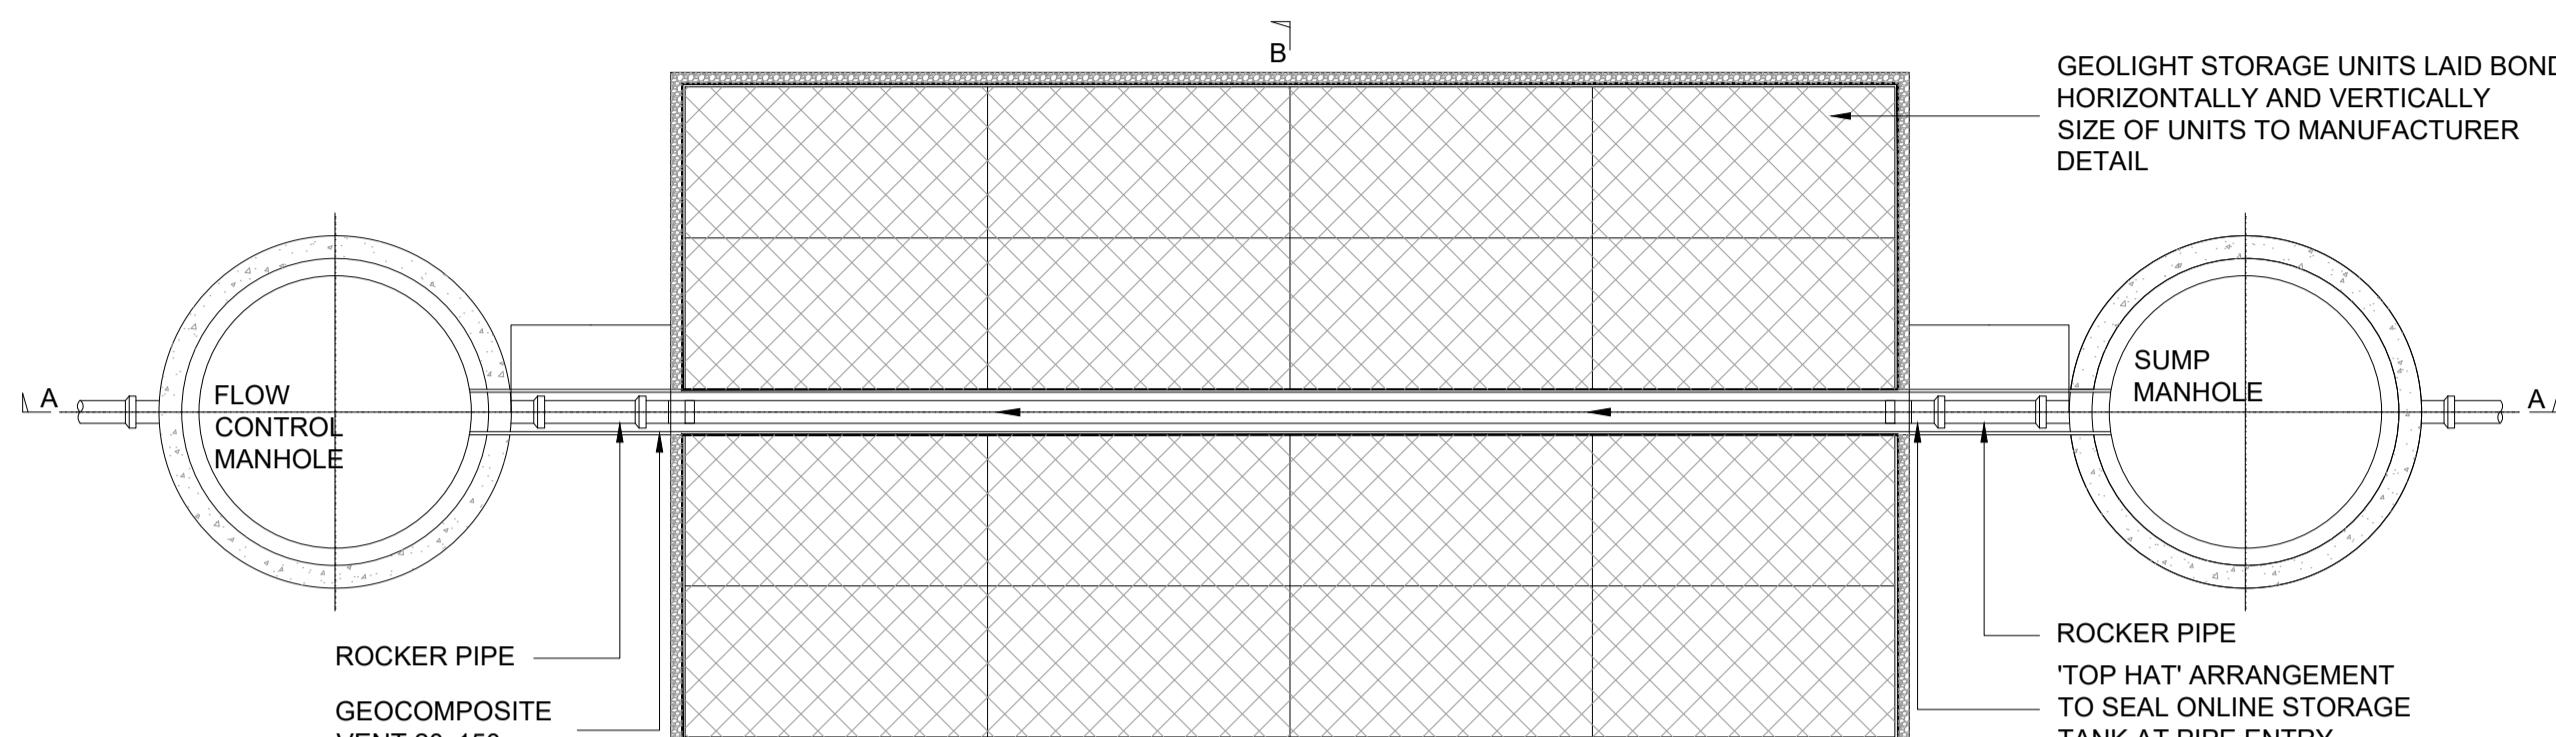

PLAN

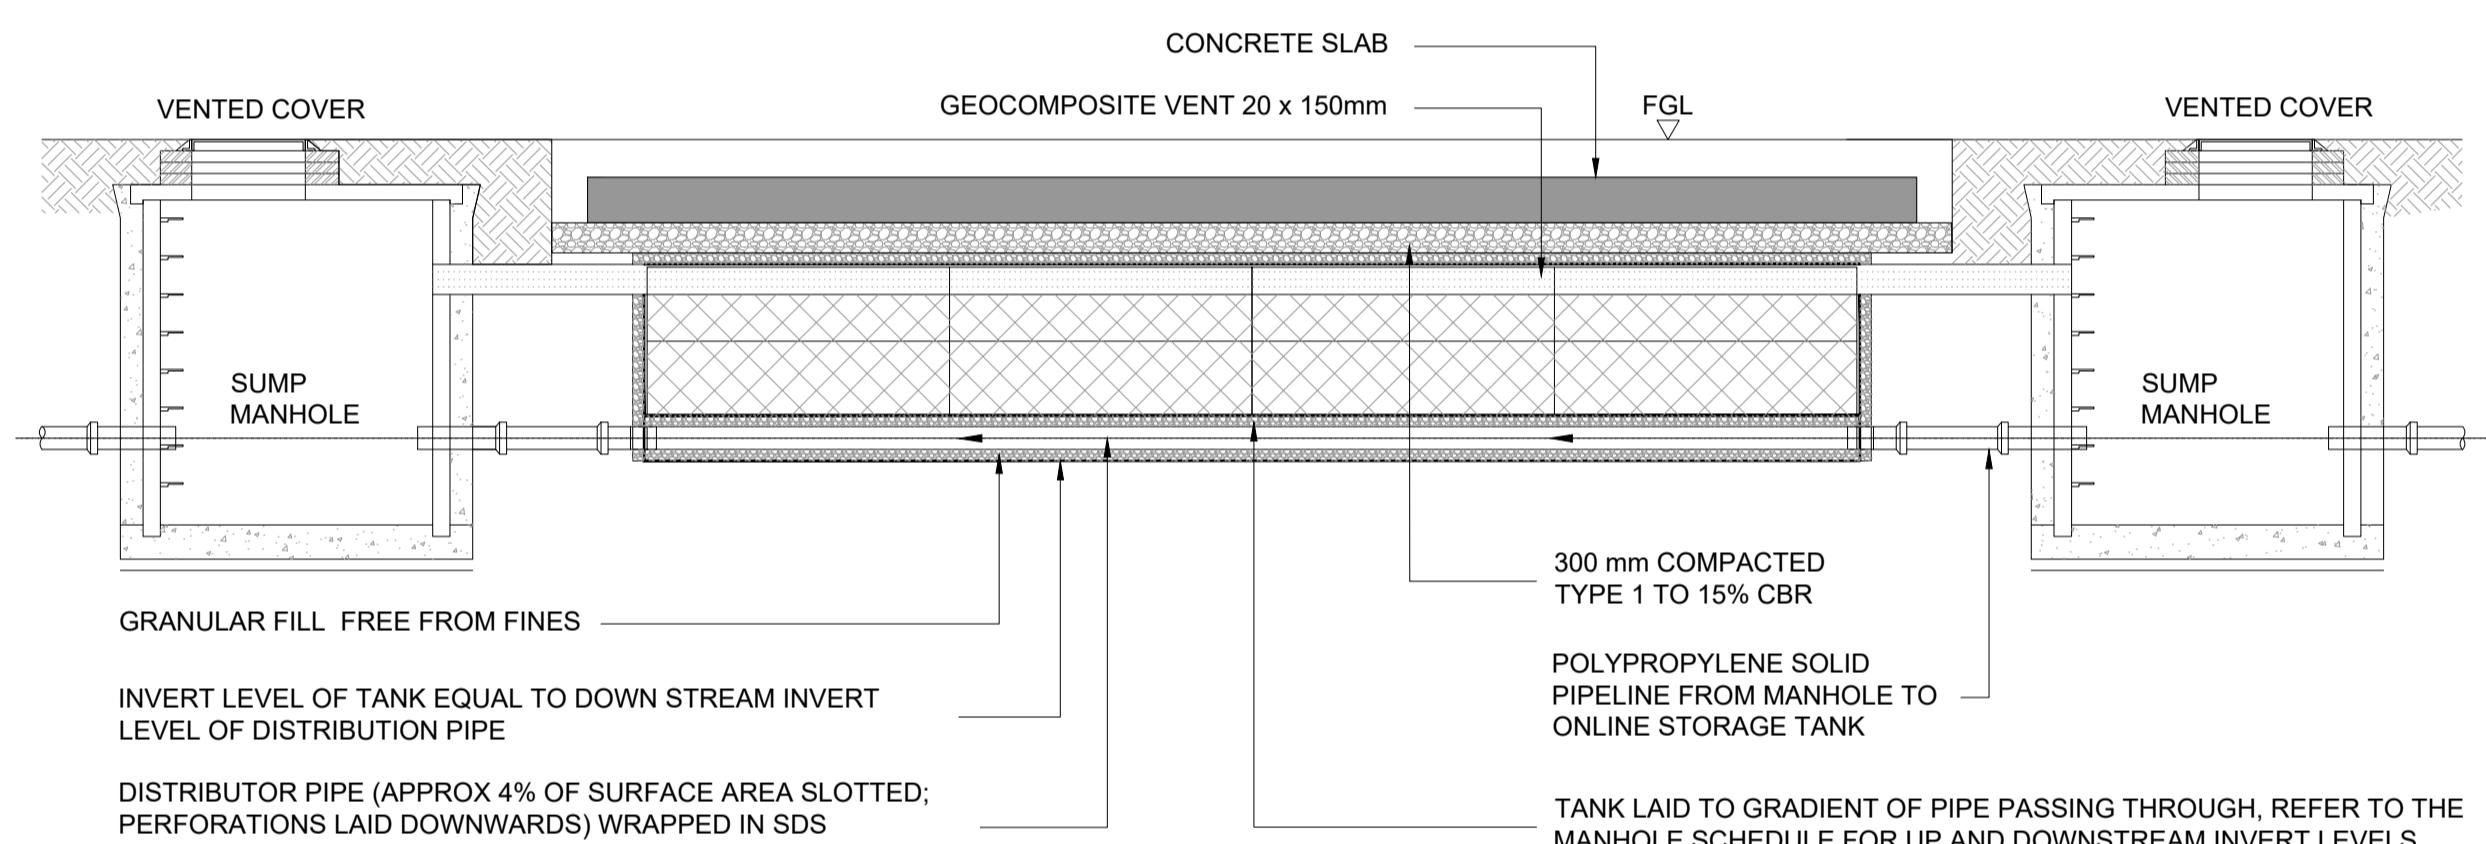


SECTION A-A

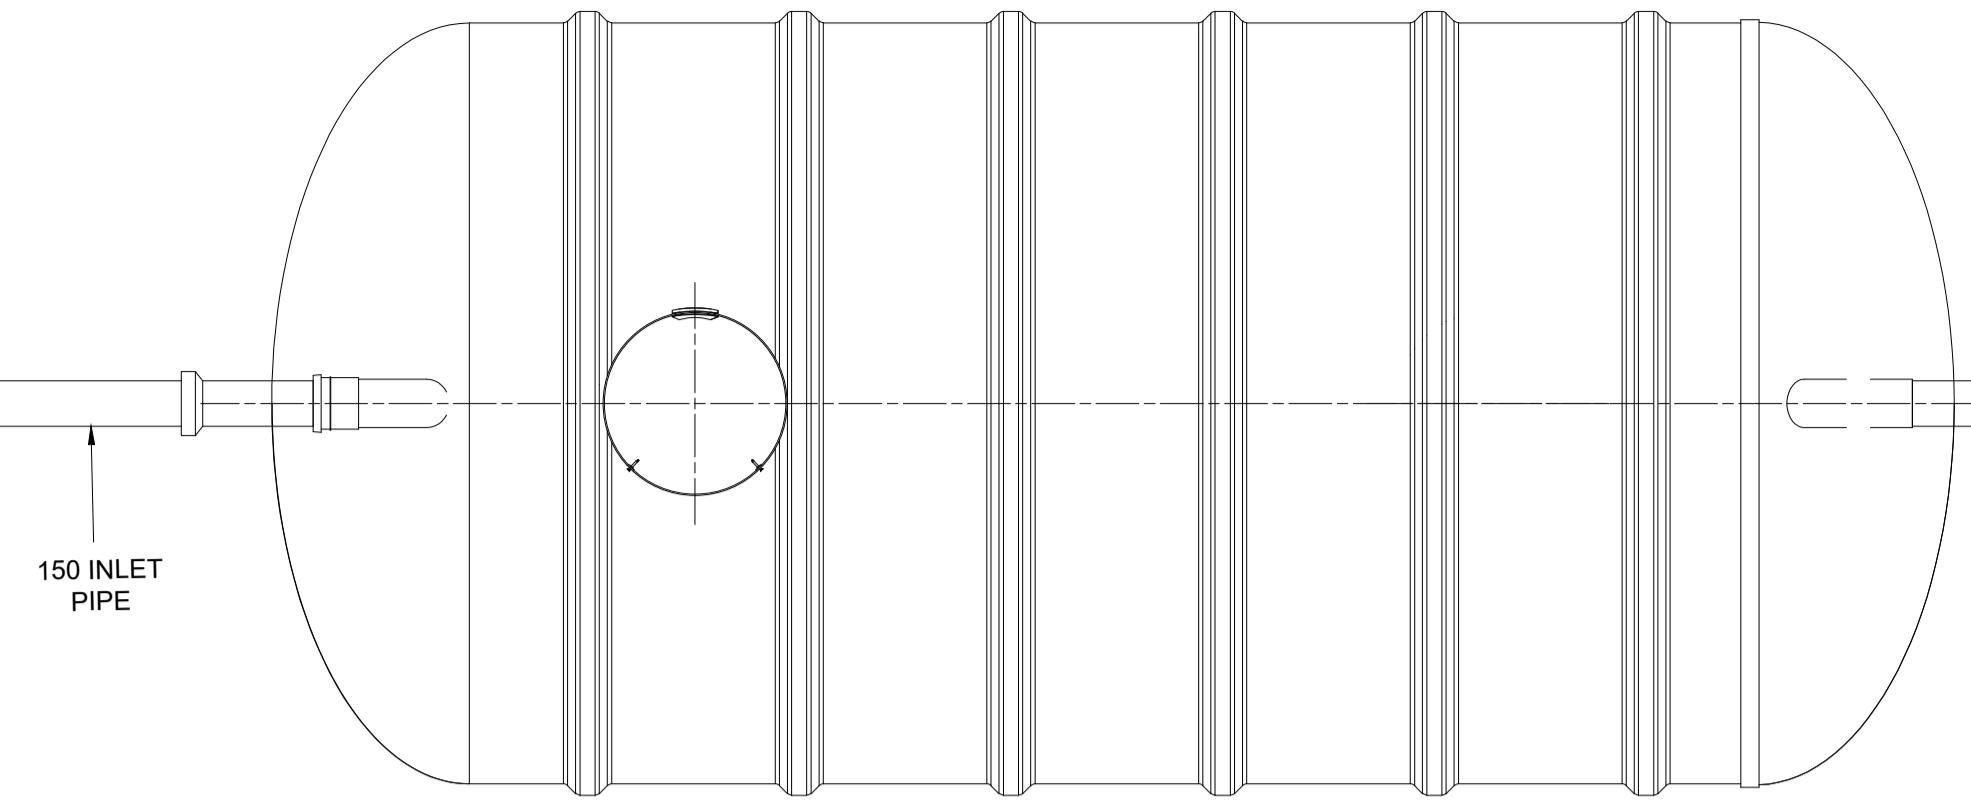


PLAN VIEW

SCALE 1:25

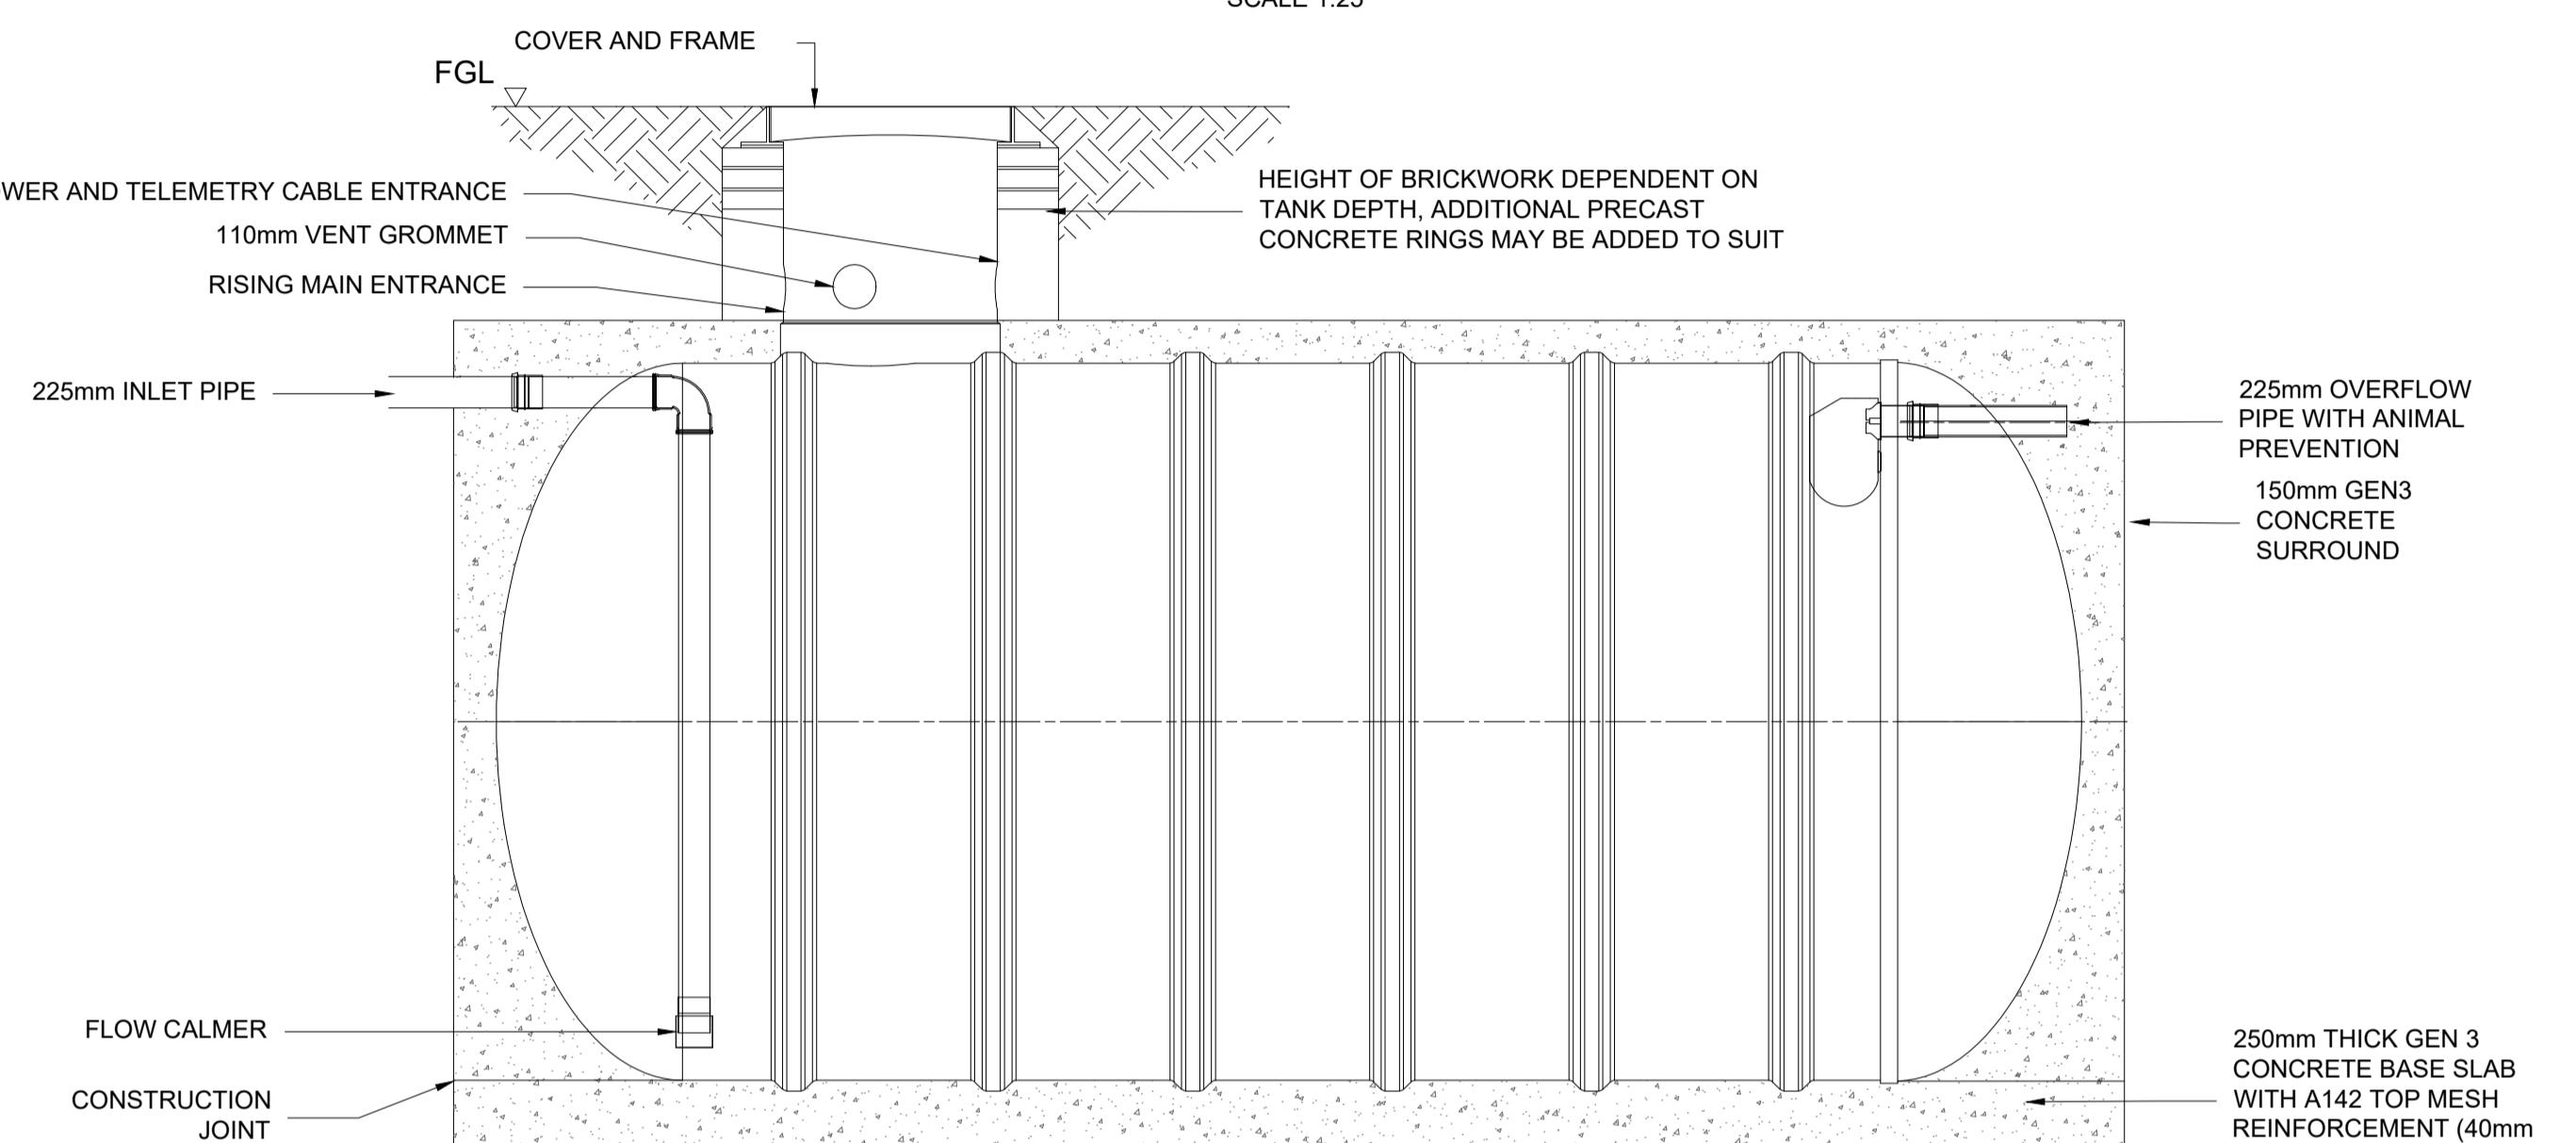

FRONT ELEVATION

SCALE 1:25

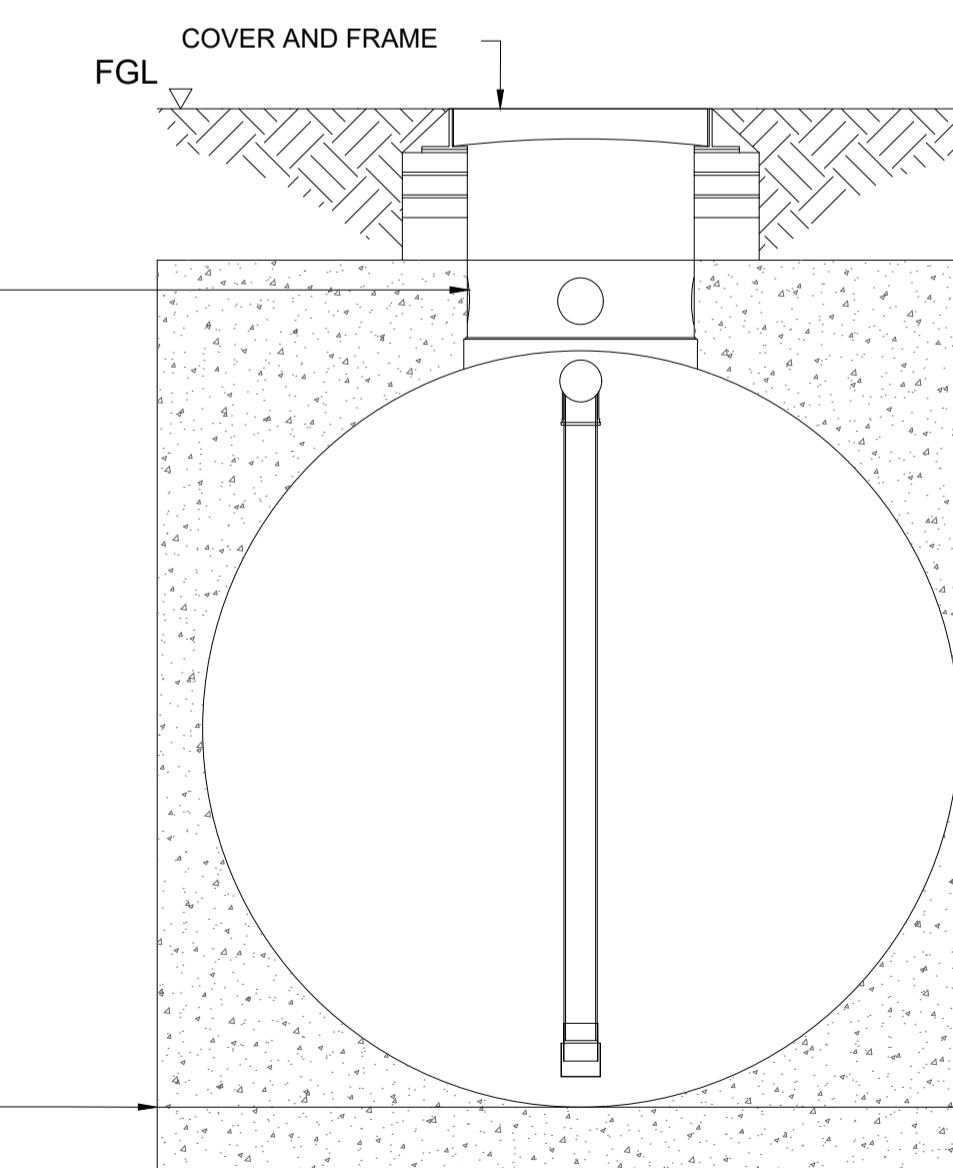

END ELEVATION

(NTS)

RAINWATER HARVESTING TANK  
NOMINAL CAPACITY 25000 LITRES

SCALE 1:25

P04	STAGE 4 ISSUE	11/01/24
P03	STAGE 4 ISSUE	04/12/23
P02	STAGE 4 ISSUE	22/09/23
P01	STAGE 3 ISSUE	02/06/23
Rev	Description	
Drawing Status:	FOR APPROVAL	
	Suitability: S4	



Client:	SWEET PROJECTS
Architect:	NWA
Project:	UNION PARK
Title:	BLOCK 3 BELOW FINISHED GROUND LEVEL DRAINAGE TYPICAL DETAILS SHEET 4 OF 5

HDR Project Number:	10274713
Cad File Name:	HDR-0473-SWS-BG-DR-C-520504
Drawn:	RJJ
Chkd/Appd:	JJ/JUG
Date:	11/01/24
Scale @ A1:	AS SHOWN
Drawing Number:	HDR-0473-SWS-BG-DR-C-520504
Revision:	P04



NOTES

- DO NOT SCALE OFF THIS DRAWING. ALWAYS WORK TO NOTED DIMENSION.
- ALL DIMENSIONS MUST BE VERIFIED ON SITE BEFORE COMPLETING SHOP DRAWINGS OR SETTING OUT OF THE WORKS.
- THIS DRAWING IS TO BE READ IN CONJUNCTION WITH ALL OTHER DISCIPLINE'S DRAWINGS, REPORTS AND SPECIFICATIONS.
- REFER TO GENERAL NOTES DRAWING HDR-0473-SWS-XX-TN-C-000025
- REFER TO DRAWING SERIES HDR-0473-SWS-BG-DR-C-520... & HDR-0473-SWS-BG-SCH-C-520... FOR ASSOCIATED BELOW GROUND DRAINAGE DRAWINGS

SURFACE WATER MANHOLE AND PIPE SCHEDULE																
REF NO.	APPROXIMATE COVER LEVEL (m)	INVERT LEVEL (m)	PIPE INVERT LEVELS (m)	DEPTH (m)	EASTING	NORTHING	INTERNAL CHAMBER SIZE (mm)	COVER LOADING TO BS EN 124	RECESSED	LOCKED	SEALED	VENTED	ACCESS COVER OPENING (mm)	DOWNSTREAM PIPE DIAMETER (mm)	DOWNSTREAM PIPE GRADIENT	REMARKS
SW03.02	30.843	27.864	In = 29.719 from PP-02.01 In = 29.424 from SD03.01 Out = 27.851	2.98	510324.695	179370.328	1800	D400	NO	NO	NO	NO	600x600	600	1:563	TYPE B
SW03.02A	30.770	27.826	In = 27.826 from SW03.02 In = 28.276 from SW03.19 In = 29.326 from CH-03.02 Out = 27.826	3.03	510344.356	179371.881	1800	D400	NO	NO	NO	NO	600x600	600	1:482	TYPE A1
SW03.03	30.622	29.871	In = 29.871 from RWP03.01 Out = 29.871	0.75	510341.264	179332.052	450	B125	YES	NO	NO	NO	450x450	150	1:39	PPIC
SW03.04	31.213	29.119	In = 29.119 from MH60 Out = 29.119	2.09	510340.760	179361.704	450	C250	NO	NO	NO	NO	450x450	150	1:40	TYPE E
SW03.05	31.035	27.859	In = 27.859 from PP03-03 Out = 27.859	3.19	510325.801	179291.591	1800	D400	NO	NO	NO	NO	600x600	600	1:600	TYPE B
SW03.07	31.206	27.332	In = 27.832 from SW03.05 In = 28.158 from RWP-03.08 Out = 27.832	3.35	510341.838	179291.592	1800	C250	NO	NO	YES	NO	600x600	600	1:761	CATCHPIT
SW03.09	30.921	28.837	In = 29.349 from MH940 Out = 28.837	2.08	510362.044	179267.355	450	C250	NO	NO	NO	NO	450x450	150	1:40	TYPE E
SW03.10	31.017	28.670	In = 28.670 from SW03.09 In = 28.670 from RWP03.22 Out = 28.670	2.35	510361.319	179273.969	1200	C250	NO	NO	NO	NO	600x600	150	1:21	TYPE B
SW03.11	30.777	29.140	In = 29.140 from MH1007 In = 29.140 from RWP03.23 Out = 29.140	1.64	510406.857	179278.208	600	D400	NO	NO	NO	NO	600x600	225	1:41	TYPE E
SW03.12	30.857	28.807	In = 28.817 from CH03.13 In = 28.816 from CH03.13 Out = 28.807	2.05	510393.534	179278.398	600	D400	NO	NO	NO	NO	600x600	225	1:12	TYPE E
SW03.18	31.161	29.063	In = 29.063 from SW03.04 Out = 29.063	2.10	510342.993	179361.743	450	C250	NO	NO	NO	NO	450x450	150	1:40	TYPE E
SW03.19	30.963	28.859	In = 28.859 from RWT03.01 Out = 28.859	2.10	510344.351	179369.167	450	C250	NO	NO	NO	NO	450x450	150	1:5	TYPE E
SW03.20	31.802	30.804	In = 30.859 from RWP03.24 In = 30.859 from PP03.02 In = 30.859 from PP03.01 Out = 30.858	1.00	510391.580	179223.551	600	D400	NO	NO	NO	NO	600x600	225	1:156	PPIC
SW03.21	31.801	30.759	In = 30.759 from PP03.03 In = 30.759 from RWP03.25 In = 30.759 from SW03.20 Out = 30.759	1.09	510406.821	179220.971	600	D400	NO	NO	NO	NO	600x600	225	1:100	PPIC

SURFACE WATER RAINWATER TANK CONNECTION SCHEDULE								
REFERENCE	COVER LEVEL (m)	PIPE INVERT LEVELS (m)	DOWNSTREAM PIPE DIAMETER (mm)	DOWNSTREAM PIPE GRADIENT	EASTING (m)	NORTHING (m)	SPECIAL REQUIREMENTS	
RWT03.01	29.515	Out = 28.910	150	1:40	510342.313	179369.122	RAIN WATER HARVESTING	

SURFACE WATER ATTENUATION TANK SCHEDULE									
TANK REFERENCE	TOP TANK LEVEL (m)	INVERT LEVEL (m)	WIDTH (m)	LENGTH (m)	DEPTH (m)	VOID RATIO	TOTAL ATTENUATION VOLUME (m³)	TANKED/ INFILTRATION	NOTES
ATT03.01	29.745	27.745	5.000	4.000	2.000	97%	38.802	TANKED	
ATT03.02	29.755	27.755	5.000	10.000	2.000	97%	96.983	TANKED	
ATT03.03	29.772	27.772	5.000	20.000	2.000	97%	193.959	TANKED	
ATT03.04	29.801	27.801	5.000	13.000	2.000	97%	126.089	TANKED	
ATT03.05	29.821	27.821	5.000	4.500	2.000	97%	43.640	TANKED	

SURFACE WATER, GULLY & CHANNEL CONNECTION SCHEDULE							
REFERENCE	COVER LEVEL (m)	PIPE INVERT LEVELS (m)	DOWNSTREAM PIPE DIAMETER (mm)	DOWNSTREAM PIPE GRADIENT	EASTING (m)	NORTHING (m)	SPECIAL REQUIREMENTS
CH-03.01	30.850	In = 30.630 Out = 29.569	150	1:40	510363.582	179259.684	
CH-03.02	31.275	Out = 29.372	150	1:58	510345.702	179369.579	
CH-03.03	31.275	Out = 28.284	150	1:52	510360.552	179369.840	
CH-03.04	31.275	Out = 28.237	150	1:53	510380.796	179370.194	
CH-03.05	31.275	Out = 28.229	150	1:57	510392.134	179370.389	
CH-03.06	31.275	Out = 28.188	150	1:55	510402.038	179370.565	
CH-03.07	31.275	Out = 30.061	150	1:44	510357.593	179296.498	
CH-03.08	31.275	Out = 30.037	150	1:44	510373.466	179296.769	
CH-03.09	31.275	Out = 30.042	150	1:44	510385.793	179296.978	
CH-03.10	31.275	Out = 30.028	150	1:44	510397.914	179297.189	
CH03.11	31.100	Out = 29.256	150	1:40	510409.807	179275.808	
CH03.12	31.100	Out = 29.090	150	1:40	510409.096	179275.808	
CH03.13	31.100	Out = 28.887	150	1:40	510392.593	179275.808	
CH03.14	31.100	Out = 28.621	150	1:40	510363.547	179275.808	
PP-03-01	30.907	Out = 28.944	150	1:40	510322.013	179361.922	
PP-03-02	30.674	Out = 29.535	150	1:100	510367.264	179375.710	
PP-03-03	30.935	Out = 28.010	150	Horizontal	510322.271	179299.879	
PP-03-04	31.107	Out = 27.943	150	1:40	510335.351	179298.866	
PP-03-05	30.952	Out = 29.519	150	1:40	510362.122	179287.699	
PP-03-06	30.787	Out = 29.471	150	1:40	510394.168	179288.74	

NOTES

1. DO NOT SCALE OFF THIS DRAWING. ALWAYS WORK TO NOTED DIMENSION.
2. ALL DIMENSIONS MUST BE VERIFIED ON SITE BEFORE COMPLETING SHOP DRAWINGS OR SETTING OUT OF THE WORKS.
3. THIS DRAWING IS TO BE READ IN CONJUNCTION WITH ALL OTHER DISCIPLINE'S DRAWINGS, REPORTS AND SPECIFICATIONS.
4. REFER TO GENERAL NOTES DRAWING HDR-0473-SWS-XX-TN-C-000025
5. REFER TO DRAWING SERIES HDR-0473-SWS-BG-DR-C-520... & HDR-0473-SWS-BG-SCH-C-520... FOR ASSOCIATED BELOW GROUND DRAINAGE DRAWINGS

FOUL WATER SVP, GULLY & CHANNEL CONNECTION SCHEDULE							
REFERENCE	COVER LEVEL (m)	PIPE INVERT LEVELS (m)	DOWNSTREAM PIPE DIAMETER (mm)	DOWNSTREAM PIPE GRADIENT	EASTING (m)	NORTHING (m)	SPECIAL REQUIREMENTS
FG03.02	31.150	Out = 29.360	150	1:36	510368.751	179344.269	
FG03.03	31.150	Out = 30.407	150	1:40	510367.417	179345.168	
FG03.04	31.150	Out = 28.843	150	1:40	510372.283	179321.811	
FG03.05	31.150	Out = 29.058	150	1:45	510371.699	179309.489	
FG03.06	31.150	Out = 30.217	150	1:40	510372.681	179322.062	
FG03.07	31.150	Out = 30.183	150	1:33	510401.409	179331.173	
GBL UP3-00-CDS-01	31.300	Out = 28.961	150	1:40	510403.775	179345.754	
GBL UP3-00-CDS-03	30.900	Out = 29.724	150	1:24			
GBL UP3-00-CDS-04	31.300	Out = 29.615	150	1:40			
GBL UP3-00-FG-01	31.300	Out = 29.121	150	1:40			
GBL UP3-00-FG-02	31.190	Out = 28.961	150	1:40			
GBL UP3-00-FG-03	30.900	Out = 30.251	150	1:40			
GBL UP3-00-FG-04	30.900	Out = 30.156	150	1:40			
GBL UP3-00-FG-05	31.300	Out = 29.504	150	1:40			
GBL UP3-00-FG-06	31.300	Out = 29.901	150	1:40			
GBL UP3-00-FG-07	30.900	Out = 30.205	150	1:40			
GBL UP3-00-FG-08	31.300	Out = 30.126	150	1:40			
GBL UP3-00-FG-11	31.300	Out = 29.977	150	1:40			
GBL UP3-00-FG-12	31.300	Out = 29.937	150	1:40			
GBL UP3-00-FG-13	31.300	Out = 29.924	150	1:40			
GBL UP3-00-FG-16	31.300	Out = 29.286	150	1:40			
GBL UP3-00-FG-17	30.900	Out = 30.026	150	1:40			
GBL UP3-00-FG-18	30.900	Out = 30.125	150	1:80			
GBL UP3-00-FG-19	30.900	Out = 30.291	150	1:40			
GBL UP3-00-FG-20	30.900	Out = 30.092	150	1:40			
GBL UP3-00-FG-21	30.900	Out = 30.208	150	1:40			
GBL UP3-00-FG-22	31.300	Out = 29.913	150	1:40			
GBL UP3-00-FG-23	31.290	Out = 29.530	150	1:11			
GBL UP3-00-FG-26	31.300	Out = 29.937	150	1:40			
GBL UP3-00-FG-27	31.300	Out = 29.748	150	1:40			
GBL UP3-00-FG-28	31.300	Out = 29.172	150	1:40			
GBL UP3-00-FG-29	31.300	Out = 29.957	150	1:40			
GBL UP3-00-FG-30	31.300	Out = 30.168	150	1:40			
GBL UP3-00-FG-32	31.300	Out = 29.342	150	1:40			
GBL UP3-00-FG-33	31.300	Out = 30.054	150	1:40			
GBL UP3-00-FG-34	31.300	Out = 29.303	150	1:45			
GBL UP3-00-FG-35	31.300	Out = 30.168	150	1:40			
GBL UP3-00-FG-36	31.300	Out = 30.170	150	1:40			
GBL UP3-00-FG-37	31.300	Out = 30.181	150	1:15			
GBL UP3-00-FG-39	31.300	Out = 28.888	150	1:40			
GBL UP3-00-FG-40	31.300	Out = 28.814	150	1:40			
GBL UP3-00-FG-41	31.300	Out = 29.522	150	1:14			
GBL UP3-00-FG-42	31.300	Out = 29.699	150	1:40			
GBL UP3-00-FG-44	31.300	Out = 29.549	150	1:40			
GBL UP3-00-FG-45	31.190	Out = 29.777	150	1:40			
GBL UP3-00-FG-47	31.300	Out = 29.954	150	1:40			
GBL UP3-00-FG-49	31.300	Out = 29.826	150	1:40			
GBL UP3-00-FG-50	31.300	Out = 30.135	150	1:40			
GBL UP3-00-FG-52	31.300	Out = 29.755	150	1:40			
GBL UP3-00-FG-54	31.300	Out = 29.589	150	1:40			
GBL UP3-00-FG-55	31.190	Out = 29.601	150	1:40			
GBL UP3-00-FG-57	31.300	Out = 29.914	150	1:40			
GBL UP3-00-FG-58	31.300	Out = 30.240	150	1:40			
GBL UP3-00-FG-59	31.300	Out = 30.094	150	1:40			
GBL UP3-00-FG-60	31.300	Out = 30.054	150	1:40			
GBL UP3-00-FG-61	31.300	Out = 29.237	150	1:40			
GBL UP3-00-FG-62	31.300	Out = 28.836	150	1:40			
GBL UP3-00-FG-64	31.300	Out = 28.861	150	1:40			
GBL UP3-00-FG-66	31.300	Out = 28.760	150	1:40			
GBL UP3-00-FG-67	31.300	Out = 28.722	150	1:40			
GBL UP3-00-FG-68	31.300	Out = 28.718	150	1:40			
GBL UP3-00-FG-71	31.150	Out = 28.954	150	1:40			
GBL UP3-00-SS-03	31.300	Out = 28.704	150	1:40			
GBL UP3-00-SVP-04	31.300	Out = 29.704	150	1:40			
GBL UP3-00-SVP-05	31.300	Out = 30.153	150	1:40			

NOTE: REFER TO HDR-0473-UP3-00-DR-S-200208 P01 13/09/23 AND HDR-0473-EC3-00-DR-S-200211 P01 13/09/23 FOR SETOUT

RODDING EYE SCHEDULE							
REFERENCE	COVER LEVEL (m)	PIPE INVERT LEVELS (m)	DOWNSTREAM PIPE DIAMETER (mm)	DOWNSTREAM PIPE GRADIENT	EASTING (m)	NORTHING (m)	SPECIAL REQUIREMENTS
RE03.01	31.300	Out = 30.131	150	1:40	510368.751	179344.269	
RE03.03	31.300	Out = 30.182	150	1:40	510367.417	179345.168	
RE03.05	31.300	Out = 30.100	150	1:40	510372.283	179321.811	
RE03.06	31.300	Out = 30.489	150	1:40	510371.699	179309.489	
RE03.07	31.300	Out = 30.152	150	1:40	510372.681	179322.062	
RE03.08	31.300	Out = 30.244	150	1:40	510401.409	179331.173	
RE03.09	31.300	Out = 30.148	150	1:40	510403.775	179345.754	

FOUL WATER SVP, GULLY & CHANNEL CONNECTION SCHEDULE							
REFERENCE	COVER LEVEL (m)	PIPE INVERT LEVELS (m)	DOWNSTREAM PIPE DIAMETER (mm)	DOWNSTREAM PIPE GRADIENT	EASTING (m)	NORTHING (m)	SPECIAL REQUIREMENTS
FGE03.01	30.365	Out = 30.154	1				

## Technical Submittal Form



**Please use this form as a 'front sheet' for all technical submittals. Ensure you include as much information as possible to receive a status. Where you provide an attachment, please reference the technical submittal ref. in the 'Subject/Title' field. and refer to the attachment in the 'Description' field.**

**Subject/Title**

TOU-0473-SW-BG-TS-X-0022

**Description (example: product name; location; specification details; supplier; etc.):**

Storm water attenuation system

**Is the proposal specification compliant?**

Yes

**Is the proposal an alternative to specification?**

No

**Details of reason for deviation from specification / alternative to specification:**

N/A

# Technical Submittal Form



Doc Ref.	SWP-0471-SW-ZZ-TS-W-000002		
To: (Name)	Neil Cooper	From: (Name)	Alhasan Sheriff
Company:	Ark Data Centres	Company:	Sweet Projects
Project Name:	Union Park	Company Initials: (3 capital letters)	SWP
Job No:	SP103	Role:	Main Contractor
Submission Date:	25/04/22	Package Code:	WP0001-Groundworks
Date Approval is Required:	23/05/22	Revision:	01
Date Approval was Received:			
SWP Submission No	SP103-WP0001-0001		
<b>Description of Technical Submittal</b>			
<b>System Category</b>	Group:	Disposal Systems	
	Subgroup:	Surface Water drainage collection systems	
	Section:	Storm water gravity drainage systems	
	Object:	Rigid attenuation or storage tank for storm water flood attenuation	
<b>Equipment Category</b>	Group:	Services and process source products	
	Subgroup:	Tank, cylinder and vessel products	
	Section:	Water tanks and cisterns	
	Object:	Piped attenuation structures	
<b>Equipment Type</b> (Fan Coil Unit, Radiator etc)		Attenuation Tank – Stormwater Management System	
<b>System Abbreviation</b>		SDS	
<b>Manufacturer</b>		GEOlight	
<b>Model</b>		HPF-0471-SWS-BG-DR-C-91138 T3	
<b>Drawing No</b>			
<b>Specification reference</b>		HPF-0471-SWS-XX-SPE-C-93000 464 Modular stormwater attenuation units Ss_50_35_80_72 Pr_60_50_96_62	
<b>Description or additional information:</b>			
<b>Is the proposal specification compliant?</b>		Yes	
<b>Is the proposal an alternative to specification?</b>		No	
<b>Details of reason for deviation from specification / alternative to specification:</b>			
<b>SWP / Consultant' comments:</b>			
<b>Designated Consultant to co-ordinate response from all parties</b>			
<b>Organisation</b>	<b>Copied to</b>		<b>Comments</b>

Consultant	Approval Status	Signed	Date

# SDS GEOlight®


Stormwater Management System

## Product Profile

**SDS GEOlight® is an ultra lightweight honeycombed modular structure made from recycled PVC. The ready to install units are preformed to provide an underground stormwater storage facility, for the application of stormwater attenuation or infiltration.**

The high void rate (>95%), high compressive strength (to 1000KN/m<sup>2</sup>) and low resistance to water flow makes

SDS GEOlight® an ideal material for cost efficient and maintainable underground water storage during storm conditions.

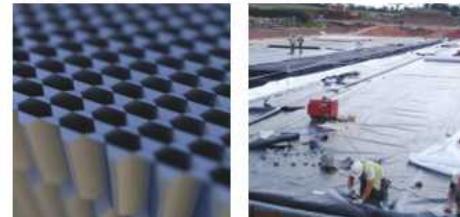

## SDS GEOlight® Benefits

- High compressive strength – can be located under all roads, car parks and amenity area surfaces.
- Reduced excavation costs – the very high void rate (95%) minimises the required volume of earthworks.
- Speed of installation – 1000m<sup>3</sup> reservoir, completed in one week.
- Light and easy to handle.
- Excellent hydraulic characteristics.
- The honeycomb structure is highly permeable, offering low resistance to water flow.
- SDS GEOlight®'s unique lateral and vertical filling arrangement requires a minimum amount of pipework and stone.
- Depth of tank invert reduced by using patented lateral supply.
- Simplified distribution pipe network, easy maintenance – dispensing with costly and complicated pipework configurations.
- Modular format offers design flexibility to overcome topographical constraints and architectural requirements.
- Greatly reduces the risk of flooding when used as stormwater storage.
- Can also be used for water recycling and combining with irrigation systems.
- Can virtually eliminate pollution when used in combination with specialist separation and filtration technology such as SDS Aqua-Swirl™ and SDS Aqua-Filter™.
- Design service available, including calculations.

## APPLICATIONS



RETAIL



INFRASTRUCTURE



INDUSTRIAL




RESIDENTIAL



COMMERCIAL



PUBLIC SECTOR

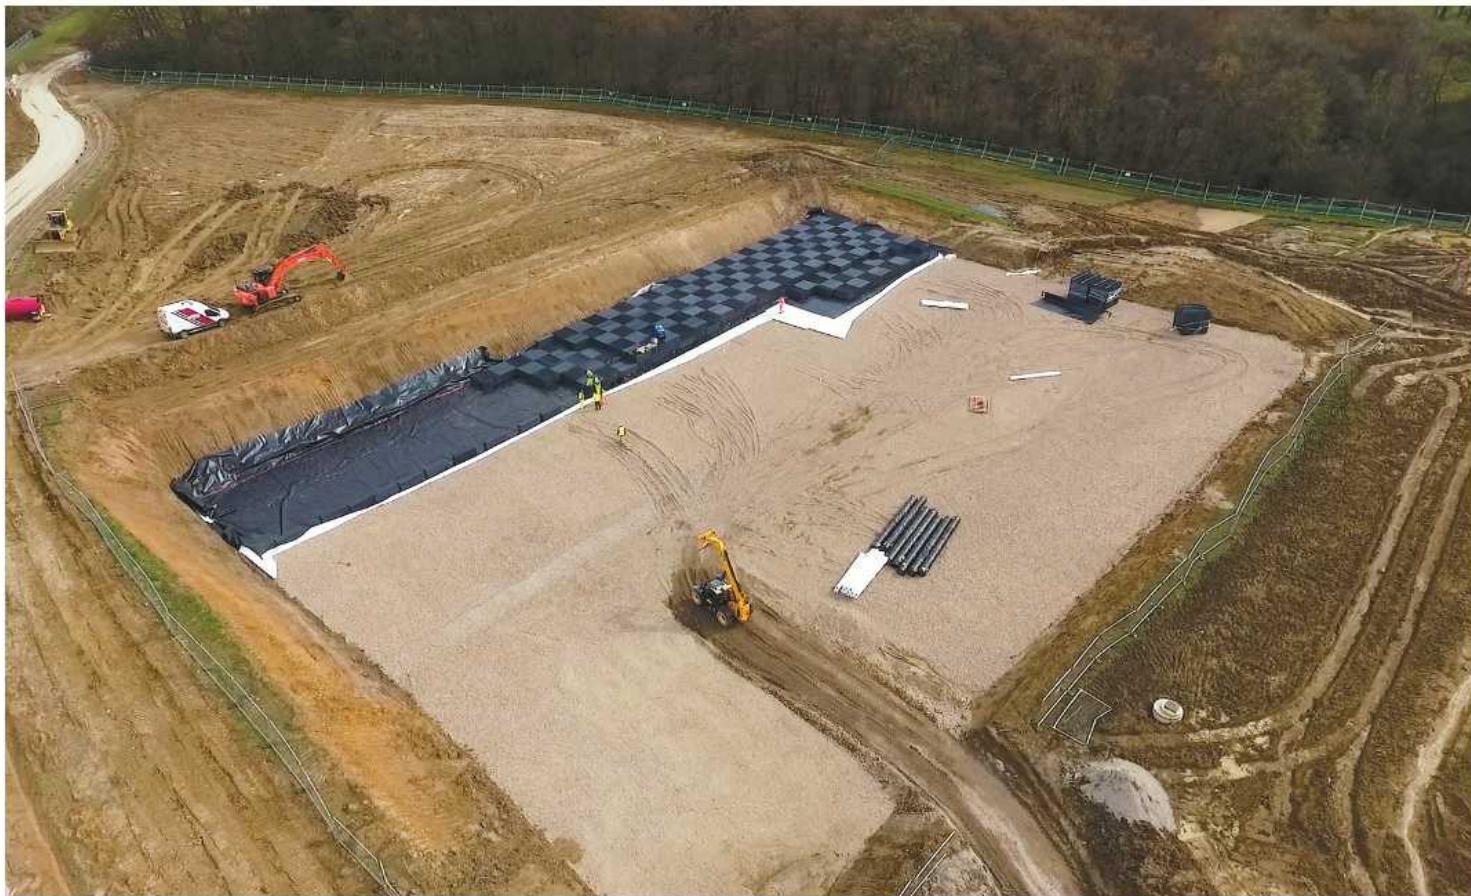

### SDS GEOlight® 400

### SDS GEOlight® 600

### SDS GEOlight® 800

#### APPLICATIONS

Stormwater Management

Attenuation / Infiltration

Bacterial filter-bed for biological treatment

Hydrocarbon Separation

Filtration and Separation Units

#### SPECIFICATIONS

Material	Recycled Rigid PVC		
Colour	Dark grey to black		
Standard length of a block	2000 mm	2000 mm	2000 mm
Standard width of a block	500 mm	500 mm	500 mm
Standard height of a block*	750 mm	750 mm	750 mm

\*Other block sizes available on request

Void Ratio	> 95%	> 95%	> 95%
Compressive Strength	420 kN/m <sup>2</sup>	610 kN/m <sup>2</sup>	800 kN/m <sup>2</sup>

#### ADVANTAGES

Highly cost effective

Reduced excavation costs

High void capacity

Good UV resistance

Good hydrocarbon resistance



# SDS GEOLight®

Stormwater Management System



SDS GEOLight® is an ultra lightweight honeycombed modular structure, made from recycled PVC, that provides an underground storage facility for the application of stormwater attenuation or infiltration.

## Stormwater Management

The Environment Agency is keen to promote the wider use of sustainable drainage systems, which reduce the impact of surface water runoff. There are two main ways of storing surface water for stormwater management:

- Stormwater attenuation tanks
- Soakaway infiltration systems

### Stormwater Attenuation Systems

This consists of underground water storage facilities that hold excess water during periods of peak rainfall.

The stored water is gradually released in a controlled manner into the surface water drainage system or directly into watercourses, reducing the risk of upstream and downstream flooding.

### Soakaway Infiltration Systems


Soakaways are designed to store surface water runoff until it can be gradually absorbed by the surrounding ground.

**SDS GEOlight® – an efficient and economic solution for stormwater management.**

### SDS GEOlight® Attenuation

**SDS GEOlight® has been specifically designed to form underground water storage reservoirs in stormwater management schemes. Its honeycombed structure gives it certain unique characteristics that make it ideal for this purpose:**

- The high void rate (95%) of GEOlight® means that the maximum volume of water is stored in the minimum volume of storage unit.
- High compressive strength. GEOlight® is available in two strengths as standard: 200 and 400kN/m<sup>2</sup>. Note: Higher compressive strengths available from 600 to 1000 kN/m<sup>2</sup>. The graph on the right shows the results of a compression test, where samples of GEOlight® 400 were compressed at the rate of 1mm per minute. The deformation at 400kN/m<sup>2</sup> is about 1.6%.

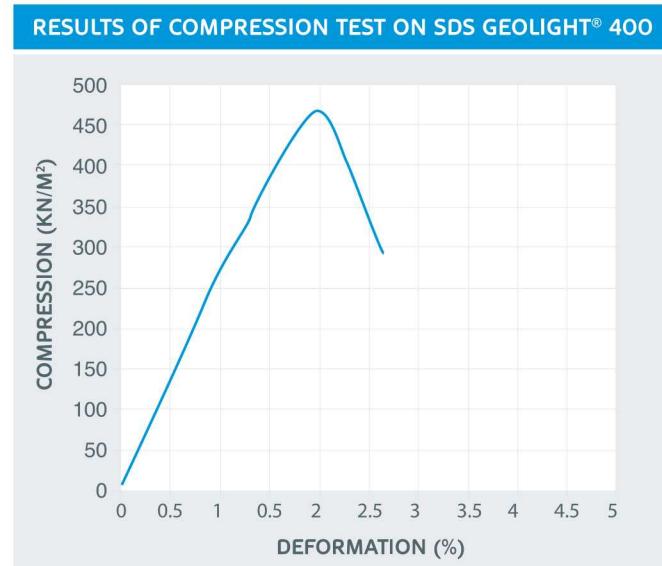


The GEOlight® Stormwater Attenuation System consists of two manholes (inspection chambers) connected by a length of perforated distribution pipe which feeds the stormwater storage reservoirs on either side formed from GEOlight®.

The distribution pipe is normally from 225mm up to 500mm diameter, generally covered in a trench that is filled with draining material such as 15/25 clean graded stone, free from fines.

The reservoirs and distribution pipe are wrapped in a waterproof membrane, such as butyl, to prevent seepage of water into the surrounding ground. The top of each GEOlight® reservoir has a vent which is connected back to the upstream manhole.

A geotextile or 10mm mesh geogrid is laid between the distribution pipe and GEOlight® to prevent the GEOlight® units being clogged by the draining materials.

## SDS GEOlight® Attenuation

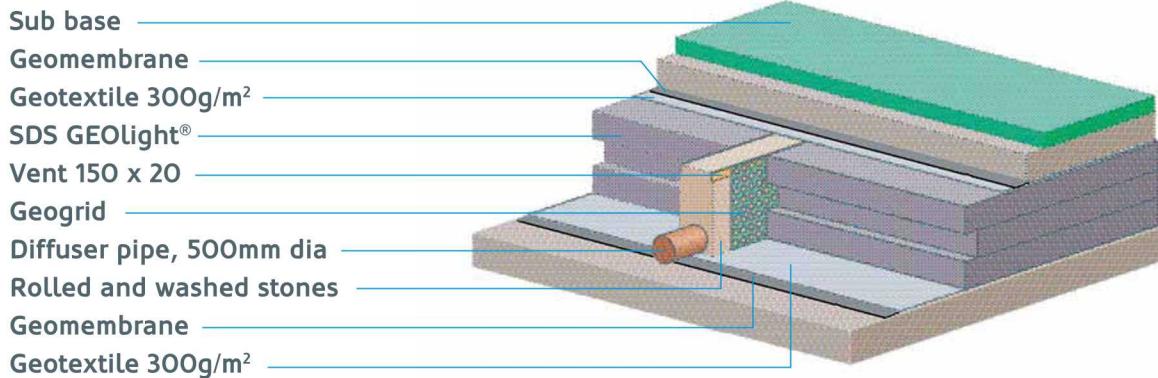

### How does it work?

- 1. In normal conditions, water enters a back drop manhole. This is the upstream manhole and any silt or sediment will collect in the bottom of the chamber. The water then flows along the distribution pipe into the downstream manhole. The upstream pipework is sized to cope with normal flow conditions. The distribution pipe and attenuation tank are sized to cope with storm conditions. The outflow pipe is sized to cope with the permissible discharge.
- 2. In storm conditions the flow restrictor (vortex flow control or orifice plate) in the downstream manhole limits the amount of water flowing out of the manhole. This causes the water level in the distribution pipe to rise and water to spill into the GEOlight® reservoirs on either side. As the water level rises in the reservoirs, air is forced out of the high level vents into the upstream manhole.

→ 3. Once the storm has passed, the water level in the GEOlight® reservoirs gradually falls as water passes through the flow restrictor in the downstream manhole. The vents now allow air to return into the GEOlight® reservoirs. Gradually the reservoirs empty. The flow restrictor prevents excess surges of flood water to pass downstream and uses the storage reservoirs to store the water for the period of the storm.

### Calculating the storage capacity

The storage capacity of the GEOlight® reservoirs is determined by the maximum outflow permitted, (set by the water company or Environment Agency), the impermeable area of the site and the rainfall return period – normally 1 in 30 years, but again can be dictated by the water company. A full design service, including calculations, can be supplied via a third party consultant.

**Please contact SDS for details.**

### Other uses

#### The water storage ability of SDS GEOlight® lends itself to a number of other uses:

- Water recycling combines with irrigation systems – this is increasingly popular: GEOlight® is used to retain stormwater which is then pumped as required to a network of standpipes for irrigation.
- Drainage channels – the natural permeability of GEOlight® lends itself for use as an underground drainage channel that collects and drains away groundwater.
- Pollution control – improved water runoff quality. When used in combination with oil / petrol separators, GEOlight® can replenish groundwater without the risk of contamination from oil, chemicals or suspended solids.
- To form lightweight embankments (slope stabilisation) – GEOlight® can be used to quickly form the base of embankments that only weigh a fraction of earth embankments.

# Stormwater Attenuation System


## Design Details

The details on these two pages illustrate the construction of a typical SDS GEOlight® Stormwater Attenuation System. The length and height of the GEOlight® reservoirs is determined by the quantity of water to be stored.

The layout of each scheme is specifically designed to suit the characteristics and limitation of the site. Typically the distributor pipe would be arranged in the centre of the reservoir, but can alternatively be placed at the side where topographical constraints dictate.

The high performance waterproof membrane should be sealed continuously to encapsulate the GEOlight® reservoirs, distributor pipe and granular fill. It is protected by a heavyweight needle punched, non woven geotextile. To help with maintenance a high flow geotextile is placed between the granular fill and GEOlight® attenuation units to prevent silt and particles being washed into the reservoir. GEOlight® can be used under a range of surfaces e.g. grass, porous paving, standard paving block, tarmac and concrete.


## Cross Section

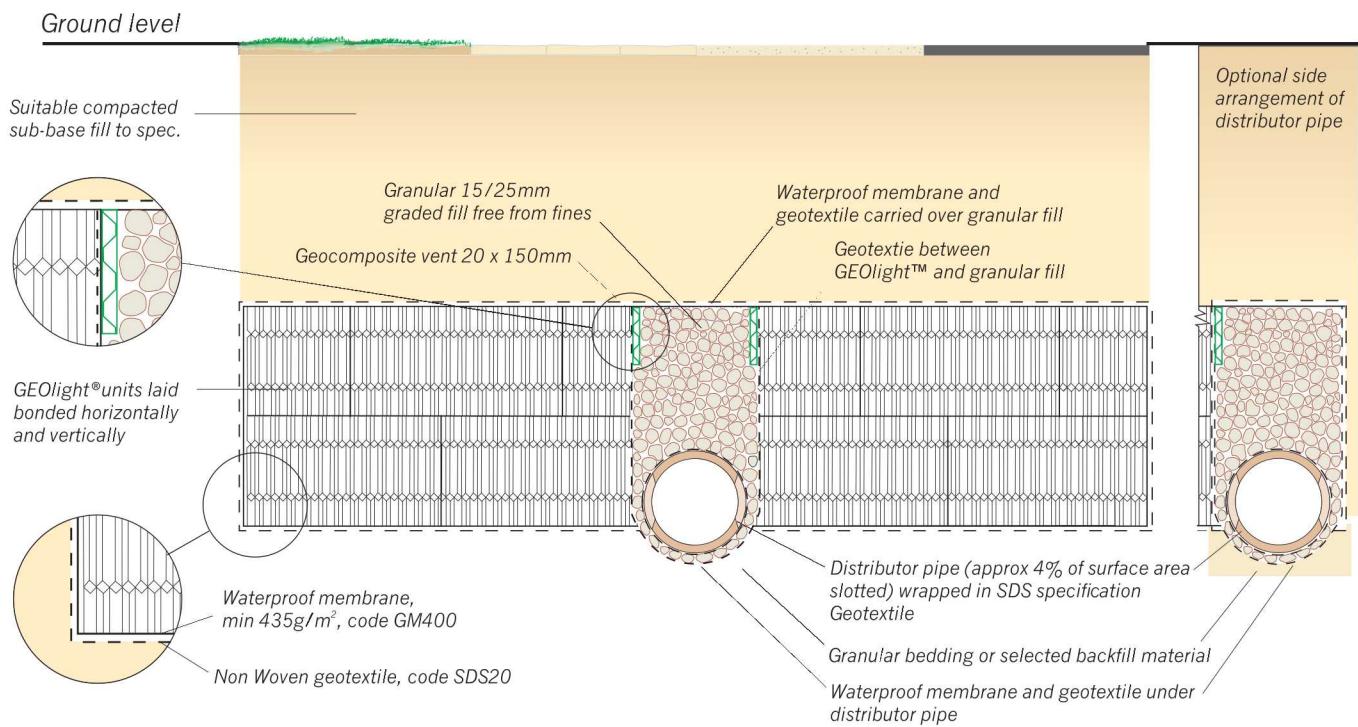


# Stormwater Attenuation System

## Design Details

### Long Section

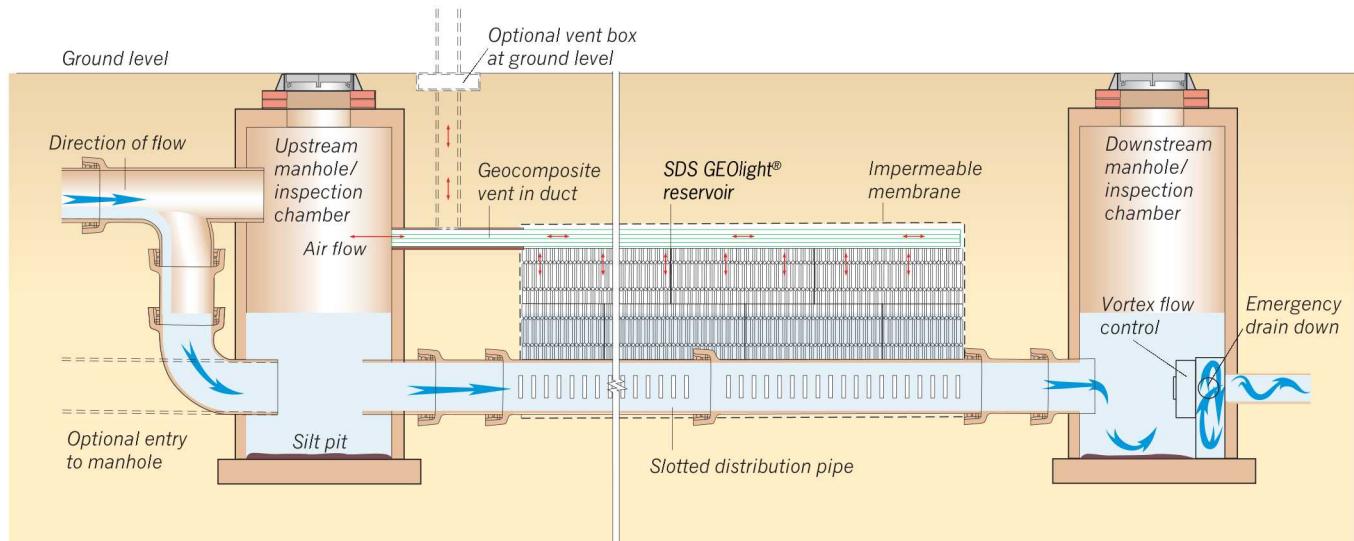


### Plan

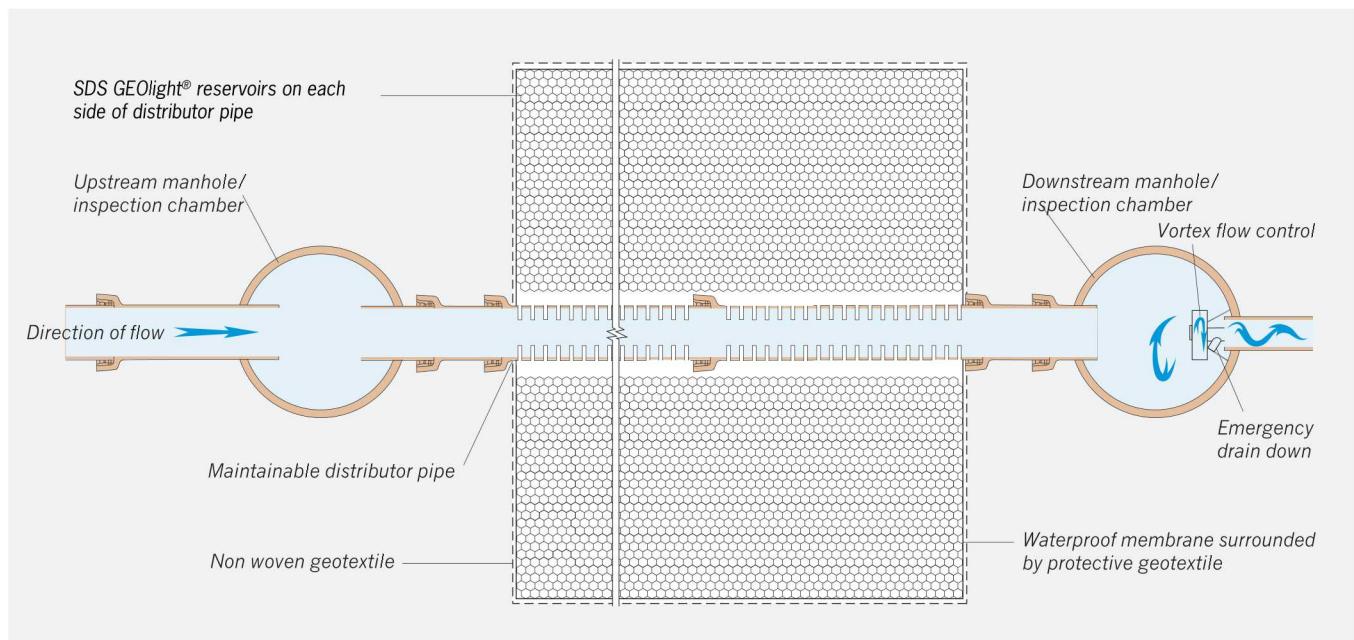

## Benefits

- High compressive strength – can be located under all roads, car parks and amenity area surfaces.
- Reduced excavation costs – the very high void rate (95%) minimises the required volume of earthworks.
- Speed of installation – 1000m<sup>3</sup> reservoir, completed in one week.
- Light and easy to handle.
- Depth of tank invert reduced by using patented lateral supply.
- Simplified distribution pipe network, easy maintenance – dispensing with costly and complicated pipework configurations.
- Greatly reduces the risk of flooding when used as stormwater storage.
- Can also be used for water recycling and combining with irrigation systems.
- Can virtually eliminate pollution when used in combination with specialist petrol / oil separators.
- Design service available, including calculations.

## GEOlight® block

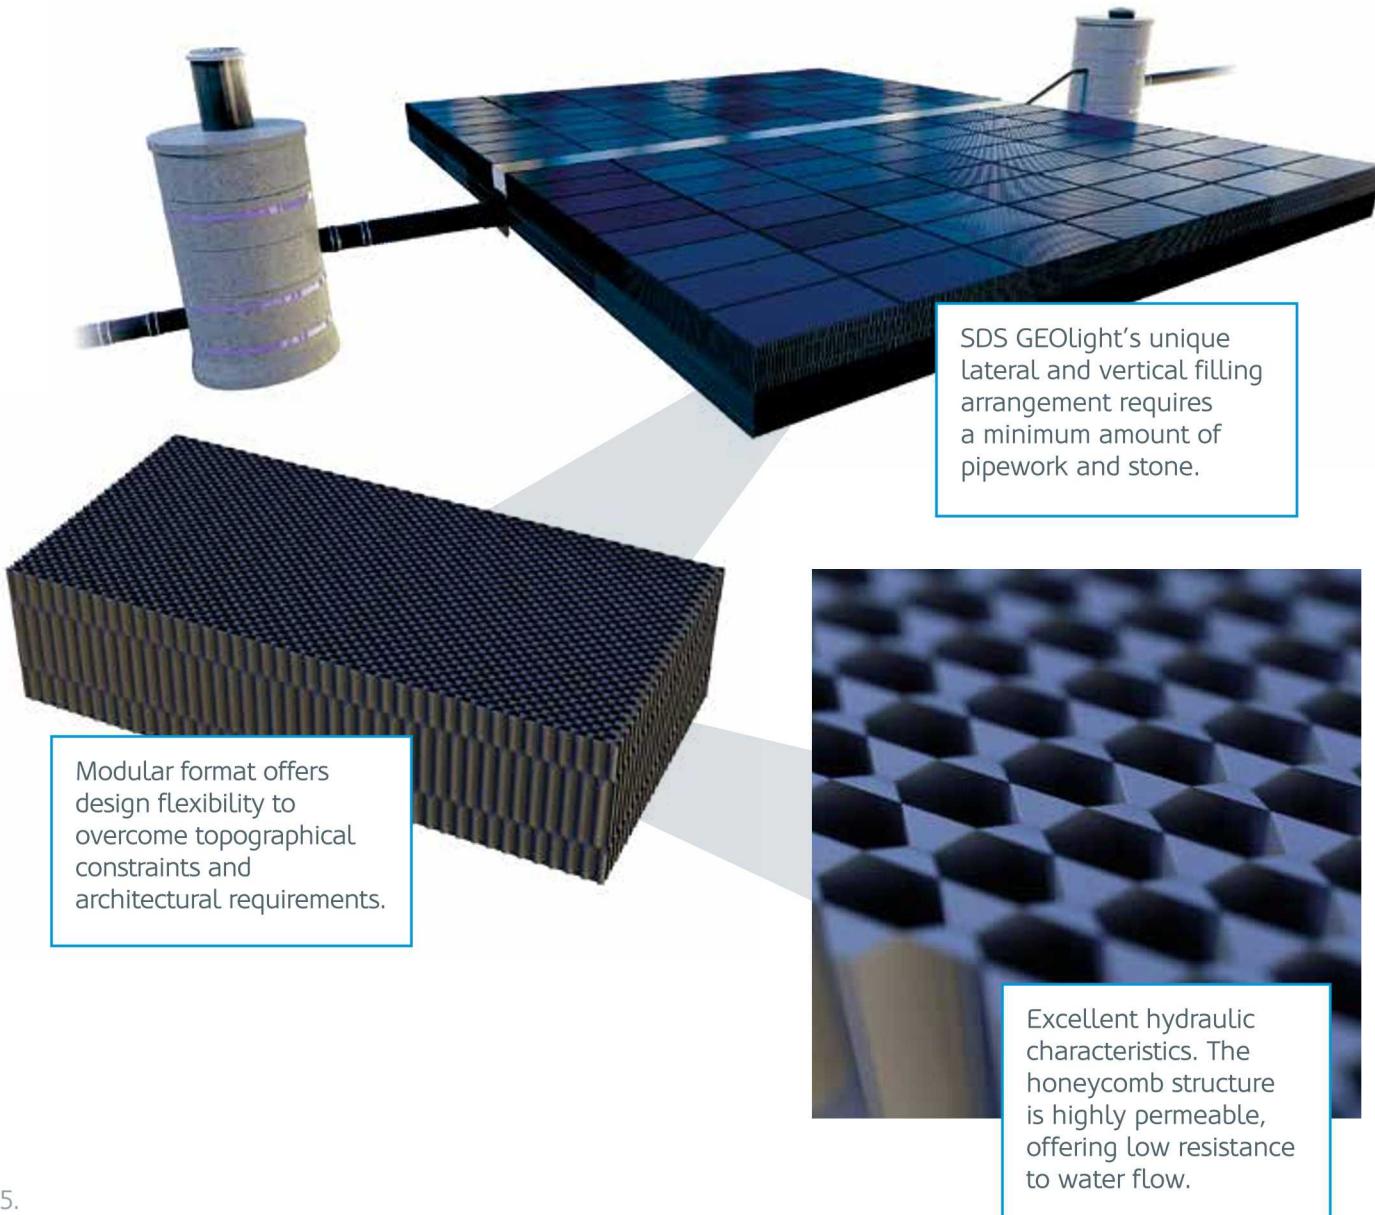

# COSHH and Handling Information

## 1. COMPOSITION/INFORMATION ON INGREDIENTS:

### Hazardous ingredients:

None as finished goods or products.

### Types of materials:

Polyvinyl chloride (PVC)  
MEK

## 2. HAZARDS IDENTIFICATION

### Nature of hazard:

There are no health risks from the products during normal use. The products may contain various pigment colours and stabilisers that may be toxic. The chemicals are, however, bound within the product material and not easily extracted.

## 3. FIRST-AID MEASURES

### Eye contact:

Plastic materials may cause physical irritation in the eyes. Wash out with large amounts of water. If irritation persists, seek medical advice.

### Skin contact:

Not applicable.

### Inhalation:

Not applicable.

### Ingestion:

Not expected to have any toxic effects.

## 4. FIRE-FIGHTING MEASURES

### Extinguishing media:

On small fires use any hand-held extinguisher type.  
On large fires use water.

### Fire and explosion hazards:

Melting plastics may flow and spread in a large fire.  
Products of fire will be thick black toxic smoke.

### Material characteristics:

PVC products will burn in the presence of a flame but are classed as self-extinguishing.

### Protective equipment:

Wear self-contained breathing apparatus and protective clothing.

## 5. HANDLING AND STORAGE

### Handling:

There are no hazards associated with the finished products. However, when cutting SDS GEOLight®, we recommend that the correct tools are used e.g. Handsaw or Alligator saw. When cutting, dust may be created; Machines used to lift the pallet should be able to lift this weight safely. Loose individual units should not be stored more than three units high. SDS GEOLight® units are lightweight ranging from 23kg to 55kg and can be easily handled – one or two person lift.

### Storage:

SDS GEOLight® units will resist the effects of UV light for up to six months; however, prolonged storage in direct sunlight should be avoided. SDS GEOLight® units should not be stored near to any fuel storage areas or any other solvents. SDS GEOLight® units are very robust and resistant to damage during normal handling; however, they should be secured in areas where impacts from vehicles or construction plant will be avoided.





## 6. EXPOSURE CONTROLS / PERSONAL PROTECTION

### Respiratory protection:

Not required under normal conditions of use. Where cutting etc. creates dust, wear a disposable half-mask to the standard FFP2S.

### Hand protection:

Wear impervious strong gloves to prevent cuts to the hands while handling, cutting etc.

### Eye protection:

Wear safety glasses when cutting etc.

### Skin protection:

Wear overalls.

## 7. SITE HAZARDS

### Other hazards for consideration:

Working in excavations and trenches – SDS GEOLight® may be designed with a shallow invert for infiltration (soakaway) or attenuation (storage) system. This negates the need for deep excavations or trenches, excavation near services e.g. gas, electricity or contaminated soil areas. N.B. All risk assessments should be undertaken by the main contractor for forklift, access to and working in excavations and trench support.

## 8. STABILITY AND REACTIVITY

### Decomposition products:

Major thermal decomposition products are oxides of carbon. Relevant differences are (in addition): PVC may produce amounts of Hydrogen Chloride.

### Stability:

These materials are stable at temperatures up to normal operating limits (moulding parameters).

## 9. ECOLOGICAL INFORMATION

### Biodegradability:

Plastic products are not readily biodegradable but are not detrimental to terrestrial wildlife.

### Aquatic toxicity:

Non-toxic to marine life.

## 10. DISPOSAL CONSIDERATIONS

### Method:

The preferred method of disposal is collection and recycling. Plastics can safely be placed with regular industrial or household wastes where recycling is not available.

## 11. OTHER INFORMATION

As the handling, storage, use and disposal of the product are beyond our control SDS disclaims all liability for loss, damage, injury or expense in any way connected with such activities and further makes no warranties, expressed or implied, as to the suitability of the product for any particular use.


# SDS

Water  
Infrastructure  
Systems

INNOVATORS IN  
WATER TECHNOLOGY



SDS Limited  
Clearwater House  
Castlemills  
Biddisham  
Somerset  
BS26 2RE

T +44 (0)1934 751303  
E [info@sdslimited.com](mailto:info@sdslimited.com)

SDS  
Water  
Infrastructure  
Systems

[sdslimited.com](http://sdslimited.com)

## Technical Submittal Form



**Please use this form as a 'front sheet' for all technical submittals. Ensure you include as much information as possible to receive a status. Where you provide an attachment, please reference the technical submittal ref. in the 'Subject/Title' field. and refer to the attachment in the 'Description' field.**

**Subject/Title**

TOU-0473-SW-BG-TS-X-0023

**Description (example: product name; location; specification details; supplier; etc.):**

Forecourt Separator specification for approval

**Is the proposal specification compliant?**

Yes

**Is the proposal an alternative to specification?**

No

**Details of reason for deviation from specification / alternative to specification:**

N/A

# Forecourt

## APPLICATION

The forecourt separator is designed for installation in petrol filling station forecourts and similar applications. The function of the separator is to intercept hydrocarbon pollutants such as petroleum and oil and prevent their entry to the drainage system, thus protecting the environment against hydrocarbon contaminated surface water run-off and gross spillage.

## PERFORMANCE

Operation ensures that the flow cannot exit the unit without first passing through the coalescer assembly.

In normal operation, the forecourt separator has sufficient capacity to provide storage for separated pollutants within the main chamber, but is also able to contain up to 7,600 litres of pollutant arising from the spillage of a fuel delivery tanker compartment on the petrol forecourt. The separator has been designed to ensure that oil cannot exit the separator in the event of a major spillage, subsequently the separator should be emptied immediately.

## FEATURES

- Light and easy to install.
- Inclusive of silt storage volume.
- Fitted inlet/outlet connectors.
- Vent points within necks.
- Extension access shafts for deep inverts.
- Maintenance from ground level.

## SIZES AND SPECIFICATIONS

ENVIROCEPTOR CLASS	TOTAL CAP. (litres)	DRAINAGE AREA (m <sup>2</sup> )	MAX. FLOW RATE (l/s)	LENGTH (mm)	DIAMETER (mm)	ACCESS SHAFT DIA. (mm)	BASE TO INLET INVERT (mm)	BASE TO OUTLET INVERT (mm)	STD. FALL ACROSS UNIT (mm)	MIN. INLET INVERT (mm)	STD. PIPEWORK (mm)	EMPTY WEIGHT (kg)
I	10000	555	10	3963	1920	600	2110	2060	50	400	160	500
II	10000	555	10	3963	1920	600	2110	2060	50	400	160	500
I	10000	1110	20	3963	1920	600	2110	2060	50	400	200	500
II	10000	1110	20	3963	1920	600	2110	2060	50	400	200	500



- Class I and Class II design.
- Oil storage volume.
- Coalescer (Class I unit only).
- Automatic closure device.
- Oil alarm system available.

## INSTALLATION

The unit should be installed on a suitable concrete base slab and surrounded with concrete or pea gravel backfill. See sales drawing for installation.

If the separator is to be installed within a trafficked area, then a suitable cover slab must be designed to ensure that loads are not transmitted to the unit.

The separator should be installed and vented in accordance with Health and Safety Guidance Note HS(G)41 for filling stations, subject to Local Authority requirements.

# Alarm Systems

British European Standard EN 858-1 and Environment Agency Pollution Prevention Guideline PPG3 requires that all separators are to be fitted with an oil level alarm system and that it should be installed and calibrated by a suitably qualified technician so that it will respond to an alarm condition when the separator requires emptying.

- Easily fitted to existing tanks.
- Excellent operational range.
- Visual and audible alarm.
- Additional telemetry option.



## Technical Submittal Form



Please use this form as a 'front sheet' for all technical submittals. Ensure you include as much information as possible to receive a status. Where you provide an attachment, please reference the technical submittal ref. in the 'Subject/Title' field. and refer to the attachment in the 'Description' field.

**Subject/Title**

TOU-0473-SW-XX-TS-X-0003 - SW Twin Wall Drainage

**Description (example: product name; location; specification details; supplier; etc.):**

SW Drainage  
Wavin  
Twin Wall  
Drawing Ref - HPF-0473-SWS-BG-DR-C-520210 P02  
Specification Ref - Clause R12 345

**Is the proposal specification compliant?**

Yes

**Is the proposal an alternative to specification?**

Yes

**Details of reason for deviation from specification / alternative to specification:**

# Technical Submittal Form



Doc Ref:	TOU-0473-SW-BG-TS-X-00003		
To: (Name)	Alhassan Sheriff	From: (Name)	Mark Rowlandson
Company:	SWP	Company:	Toureen Group
Project Name:	Project Union – Phase 3	Company Initials: (3 capital letters)	TCL
Job No:	1182	Role:	Project Engineer
Submission Date:	04.12.2023	Package Code:	
Date Approval is Required:	11.12.2023	Revision:	01
Date Approval was Received:			
SWP Submission N			
<b>Description of Technical Submittal</b>			
System Category	Group:	Civils	
	Subgroup:	Section:	
	Object:		
	Object:		
Equipment Category	Group:	Drainage	
	Subgroup:	Section:	
	Object:		
	Object:		
<b>Equipment Type</b> (Fan Coil Unit, Radiator etc)		SW Drainage	
<b>System Abbreviation</b>			
<b>Manufacturer</b>		Wavin	
<b>Model</b>		Twin Wall	
<b>Drawing No</b>		HPF-0473-SWS-BG-DR-C-520210 P02	
<b>Specification reference</b>		R12 345	
<b>Description or additional information:</b>			
<b>Is the proposal specification compliant?</b>		yes	
<b>Is the proposal an alternative to specification?</b>		yes	
<b>Details of reason for deviation from specification / alternative to specification:</b>			
<b>SWP / Consultant's comments:</b>			
<b>Designated Consultant to co-ordinate response from all parties</b>			
<b>Organisation</b>	<b>Copied to</b>		<b>Comments</b>

Consultant	Approval Status	Signed	Date



## SAFETY DATA SHEET

### PP and PE PIPE AND FITTINGS

#### 1.0 IDENTIFICATION OF THE SUBSTANCE/PREPARATION AND COMPANY/UNDERTAKING

ALTERNATIVE PRODUCT NAMES	Polypropylene and Polyethylene pipe and fittings
PRODUCT NO.	2CSxxx, 4CSxxx, 5CSxxx, 3Dxxx, 4Dxxx, 6Dxxx, 6LBxxx, 2Sxxx, 3Sxxx, 4Sxxx, 6Sxxx, 6TWxxx, 9TWxxx, 12TWxxx, 375TWxxx, 450TWxxx, 500TWxxx, 600TWxxx, WCxxx, 1000Cxxx, 2Vxxx, 4Vxxx, 5Vxxx, 2Wxxx, 4Wxxx, 5Wxxx, 2Zxxx, 4Zxxx, 5Zxxx, PExxx
APPLICATION	Potable, Non-potable, Stormwater, Drain, Soil and Waste
MANUFACTURER:	<p>WAVIN UK            Parsonage Way,            Chippenham,            Wiltshire, SN15 5PN</p> <p>Tel: (01249) 766600 (Opening hours 07.00 -19.00hrs)            Fax: (01249) 443286</p>
CONTACT PERSON	<a href="mailto:development.technologist@wavin.com">development.technologist@wavin.com</a>

#### 2.0 HAZARDS IDENTIFICATION

##### 2.1 Classification of the substance or mixture

Classification according to regulation (EC) No. 1272/2008 CLP is that PP and PE pipes and fittings as finished product are not regarded as hazardous to health, and exhibit no chemical hazards when used under normal circumstances for the stated application(s).

##### 2.2 Label Elements

Not labelled as Hazardous

##### 2.3 Other Hazards

Fine particles released on cutting may cause irritation to the eyes and respiratory tract.

#### 3.0 COMPOSITION/INFORMATION ON INGREDIENTS

##### 3.1 Substances

This material is not classified as hazardous to Health or the Environment under current EU legislation.

PRODUCT IDENTIFIER IN ACCORDANCE WITH ARTICLE 18(2) (EC) No 1272/2008	IDENTIFICATION NO	IDENTIFICATION NAME	WEIGHT % OR RANGE	EC NUMBER <sup>1</sup>
CAS Number	9003-07-0	1-Propene Copolymer	0-100	
CAS Number	9010-79-1	1-Propene with Ethene	0-100	

CAS Number	29160-13-2	1-butene, polymer with 1-propene	0-100	
CAS Number	25895-47-0	1-butene, polymer with ethane and 1-propene	0-100	
CAS Number	9002-88-4	High density Polyethylene	0-100	

<sup>1</sup> – this is only required for reference purposes only.

## 4.0 FIRST AID MEASURES

### 4.1 DESCRIPTION OF FIRST AID MEASURES

#### After inhalation:

Move the exposed person to fresh air at once.  
Get medical attention if any discomfort continues.  
Unlikely route of exposure as the product does not contain volatile substances.

#### After skin contact:

Contact with molten product may cause burns. Cool with plenty of cold water.  
Do not attempt to remove the solidified plastic without consulting a trained first aider.  
Contact with the product at room temperature is unlikely to cause irritation however, obtain medical attention if any discomfort develops.

#### After eye contact:

Promptly wash eyes with plenty of water while lifting the eye lids.  
Continue to rinse for at least 15 minutes.  
Get medical attention if any discomfort continues.

#### After ingestion:

Unlikely route of exposure.  
Get medical attention should discomfort develop.

## 4.2 Most important symptoms and effects, both acute and delayed

No further relevant information available.

## 4.3 Indication of any immediate medical attention and special treatment needed

No further relevant information available.

## 5.0 FIRE FIGHTING MEASURES

### 5.1 EXTINGUISHING MEDIA

Suitable Media - Extinguish with foam, carbon dioxide, dry powder or water fog.

Unsuitable Media - Do not use water jet as an extinguisher, as this will spread the fire.

### 5.2 SPECIAL HAZARDS ARISING FROM THE SUBSTANCE OR MIXTURE

Avoid breathing fire vapours. Beware, risk of formation of toxic and corrosive gases.

Keep run-off water out of sewers and water sources.

Dike for water control. If risk of water pollution occurs, notify appropriate authorities.

### 5.3 ADVICE FOR FIREFIGHTERS

Self-contained breathing apparatus and full protective clothing must be worn in case of a large fire.

## 6.0 ACCIDENTAL RELEASE MEASURES

### 6.1 PERSONAL PRECAUTIONS, PROTECTIVE EQUIPMENT AND EMERGENCY PROCEDURES

Pellets remaining on the ground may act as a slip hazard.

Ensure adequate ventilation.

Keep away from ignition sources.

Keep unprotected personnel away from the area.

Wear protective equipment if applicable.

### 6.2 ENVIRONMENTAL PRECAUTIONS

Do not allow to enter drains, sewers or watercourses.

Avoid release to the environment, and avoid any contact with wildlife.

### 6.3 METHODS AND MATERIAL FOR CONTAINMENT AND CLEANING UP

Not applicable.

### 6.4 REFERENCE TO OTHER SECTIONS

See Section 7 for information on safe handling.

See Section 8 for information on personal protection equipment.

See Section 13 for disposal information.

## 7.0 HANDLING AND STORAGE

### 7.1 PRECAUTIONS OF SAFE HANDLING

Avoid dust formation if cutting.

Avoid eating, drinking and smoking when using the product.

Observe good industrial hygiene practices.

Gloves should be worn if edges are sharp where pipes have been broken.

### 7.2 CONDITIONS FOR SAFE STORAGE, INCLUDING ANY INCOMPATIBILITIES

Products should preferably be stored in dry covered conditions away from direct sources of heat, including sunlight.

During storage it must be recognised that the packaging and pallets may themselves be a fire risk, and are generally a much more likely route for rapid fire spread.

### 7.3 SPECIFIC END USE(S)

No further relevant information available.

## 8.0 EXPOSURE CONTROLS/PERSONAL PROTECTION

### 8.1 CONTROL PARAMETERS

#### 8.1.1 Occupational Exposure Limits

	15min TWA	8hr TWA
Total Inhalable Dust	20 mg/m <sup>3</sup>	10 mg/m <sup>3</sup>
Total Respirable Dust		4 mg/m <sup>3</sup>

### 8.1.2 Decomposition Products With Occupational Exposure Limits

Cas No.	Name	15min TWA	8hr TWA
630-08-0	Carbon Monoxide	200 ppm ;	

### 8.2 PROTECTIVE EQUIPMENT

#### 8.2.1 General protective and hygienic measures:

Appropriate workwear

Provide adequate general and local exhaust ventilation.

#### 8.2.2 Respiratory protection:

No specific recommendation made, but respiratory protection may still be required under exceptional circumstances when excessive dust formation occurs. Seek advice.

#### 8.2.3 Protection of hands:

Protective gloves recommended, for prolonged or repeated skin contact use suitable protective gloves.



Protective gloves recommended

#### 8.2.4 Eye protection:

Wear protective goggles to prevent any possibility of eye contact especially when cutting.



Eye protection

#### 8.2.5 Skin protection:

Standard industrial protective clothing

#### 8.2.5 Body protection:

Not necessary

## 9.0 PHYSICAL AND CHEMICAL PROPERTIES

APPEARANCE	Solid plastic articles		
COLOUR	White, Grey or Black		
ODOUR	Odourless		
SOLUBILITY	Insoluble in water	DECOMPOSITION TEMP °C	> 250°C
RELATIVE DENSITY	0.90 – 0.97	FLASH POINT (°C)	> 300°C

**10.0 STABILITY AND REACTIVITY****10.1 REACTIVITY**

Non-reactive under normal handling and storage conditions.

**10.2 CHEMICAL STABILITY**

Stable under normal temperature conditions and recommended use.

**10.3 POSSIBILITY OF HAZARDOUS REACTIONS**

No further relevant information available.

**10.4 CONDITIONS TO AVOID**

Avoid excessive heat for prolonged periods of time.

**10.5 INCOMPATIBLE MATERIALS**

No further relevant information available.

**10.6 HAZARDOUS DECOMPOSITION PRODUCTS**

None under normal conditions.

**11.0 TOXICOLOGICAL INFORMATION****11.1 ACUTE TOXICITY****11.2 PRIMARY IRRITANT EFFECT****11.2.1 On the skin:**

No harmful effects expected

**11.2.2 On the eye:**

Dust formed during cutting may cause irritation.

**11.2.3 Sensitization:**

Material is practically inert from a physiological point of view.

**11.2.4 Inhalation:**

Dust formed during cutting may be irritating to the respiratory tract.

**11.2.4 Ingestion:**

No harmful effects expected.

**11.3 ADDITIONAL TOXICOLOGICAL INFORMATION**

No further relevant information available.

## 12.0 ECOLOGICAL INFORMATION

The product components are not classified as environmentally hazardous. However, this does not exclude the possibility that inappropriate, large or frequent disposal might have a harmful or damaging effect on the environment.

### 12.1 Toxicity

No data available.

### 12.2 Persistence and degradability

Product is not readily biodegradable and is likely to persist in the environment.

In Sewage plants it can be separated mechanically.

### 12.3 Bio accumulative Potential

To avoid bio accumulation of the plastics products should not be disposed in the sea or water environment.

### 12.4 Mobility in Soil

No data available.

### 12.5 Results of PBT & vPvB assessment

According to the revised Annex XIII of Regulations (EC) 1907/2006 and (EC) 253/2011: No information available.

### 12.6 Other adverse effects

Do not allow to enter into the ground water, surface water or drains.

## 12.7 Additional Information

## 13.0 DISPOSAL CONSIDERATIONS

### 13.1 WASTE TREATMENT METHODS

#### 13.1.1 Product and Packaging Disposal

Disposal of waste materials in accordance with local Waste regulations  
When handling waste, consideration should be made to the safety precautions applying to handling of the product.  
Recycle where it is practical to do so.

#### 13.1.2 Waste Treatment

Inadequate incineration may generate toxic gases.

#### 13.1.3 Sewage Disposal

#### 13.1.4 Other Disposal recommendations

---

**14.0 TRANSPORT INFORMATION**

---

The product is not covered by international regulation on the transport of dangerous goods (IMDG, IATA, ADR/RID).

**14.1 UN Number**

Not Applicable

**14.2 UN Proper Shipping Name**

Not Regulated

**14.3 Transport Hazard Classes**

Not Applicable

**14.4 Packing Group**

Not Applicable

**14.5 Environmental Hazards**

Not considered a hazard based on current data.

**14.6 Special precautions for the User**

No data available.

---

**15.0 REGULATORY INFORMATION**

---

**15.1 SAFETY, HEALTH AND ENVIRONMENTAL REGULATIONS/LEGISLATION SPECIFIC FOR THE SUBSTANCE OR MIXTURE**

Approved Code Of Practice

Workplace Exposure Limits EH40.

EU Legislation

CLP Regulations to EC 1272/2008

**15.2. Chemical Safety Assessment**

No chemical safety assessment has been carried out.

---

**16 OTHER INFORMATION**

---

REVISION DATE 28/04/2017

REV. NO./REPL. SDS GENERATED A

SAFETY DATA SHEET STATUS Approved.

DATE 28/04/2017

SIGNATURE JM

SIGNATURE 2 AR

**INFORMATION FOR DOWNSTREAM USERS ONLY; NAMELY,**

Any natural or legal person established within the community, other than the manufacturer or the importer, who uses a substance, either on its own or in a preparation, in the course of his industrial or professional activities. A distributor or a consumer is not a downstream user.

**DISCLAIMER**

This information relates only to the specific material as supplied and may not be valid for such material if used in combination with any other material(s) or in any other process. Such information is, to the best of the company's knowledge and belief, accurate and reliable as of the date indicated. The data should not be construed as guaranteeing specific properties of the product described or its suitability for a particular application, nor does it make any warranty, either express or implied of merchantability for the product itself. It is the user's responsibility to satisfy himself as to the suitability and completeness of such information for his own particular use.