

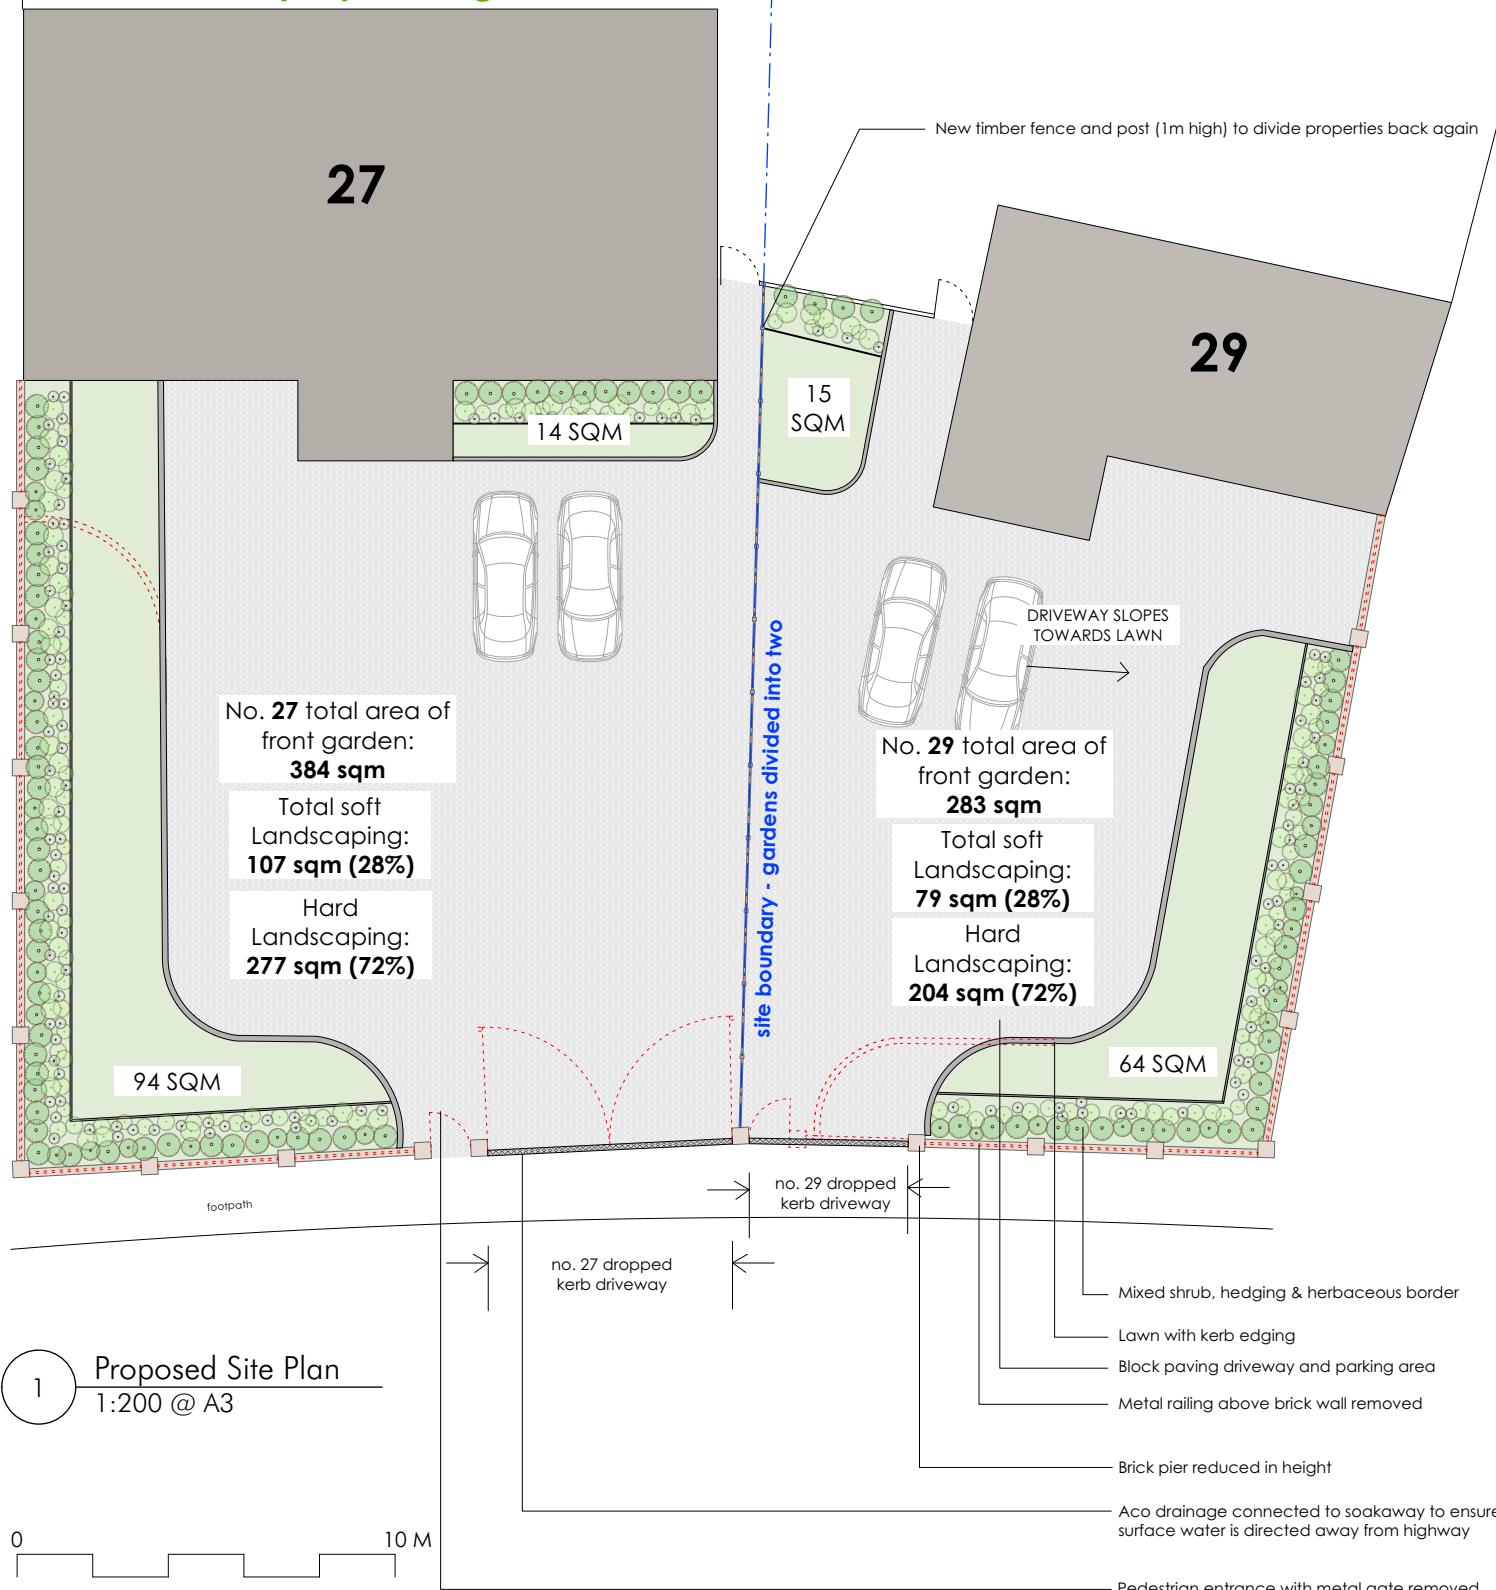


Hillingdon's Design Guidance recommends retaining at least 25% soft landscaping to front garden.


This proposal increases this by 3% above recommendation for soft landscaping = 28% of total surface area of each properties garden

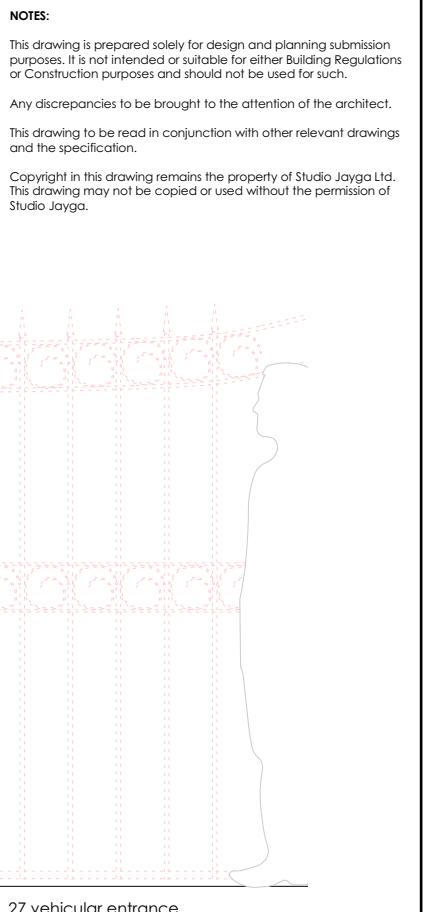


Dotted red lines indicate existing to be demolished or reduced in height

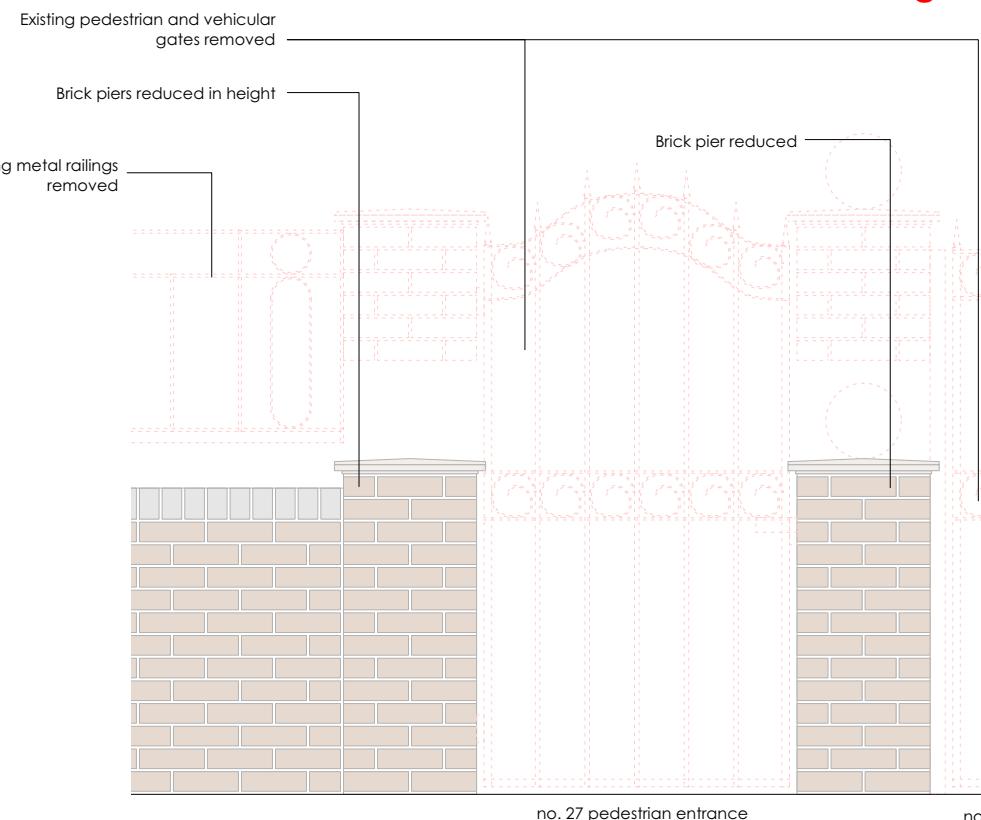

2 Proposed Gates 1:25 @ A3

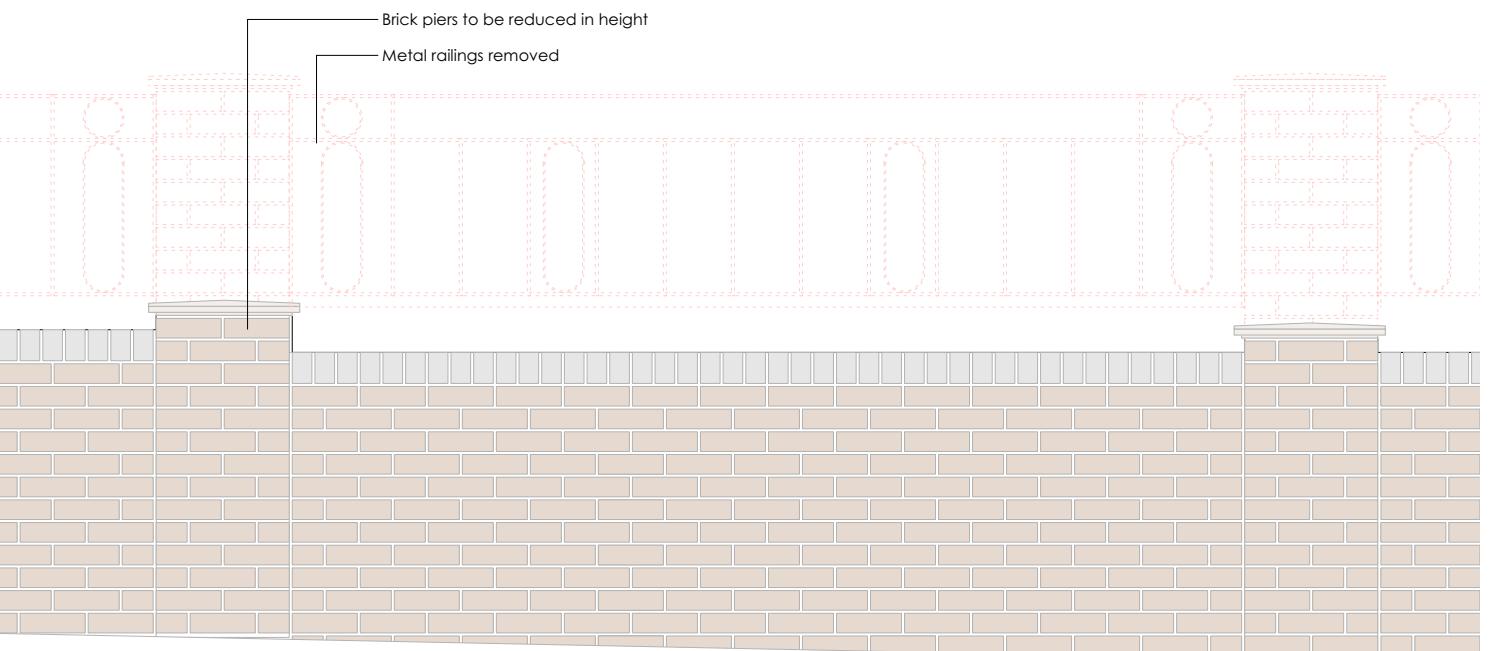

3 Proposed Typical Wall & Brick Pier 1:25 @ A3

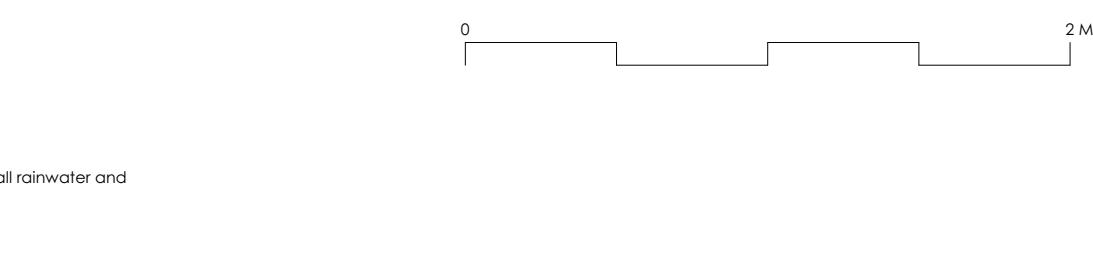

PLANNING

project 27 & 29 Woodstock Drive, Ickenham
stage Planning
client Mr R Saroya
drawing Proposed Boundary wall & gate plan & details
scale 1:200/25 @ A3
date May 2024
dwg no 644-203