
General Notes
1. New work shown shaded
2. Demolition shown dotted
3. W: Wardrobe
   Cpbd: Cupboard
   RLA: Roof lantern above
   RL: Roof light/lantern below
4. All dimensions are indicative and in mm
5. If shown levels indicated in red dotted
6. K: Kitchenette
   John Strand or similar
   ELK11-1M microwave Kitchenette
   1000 x 600 x 2000

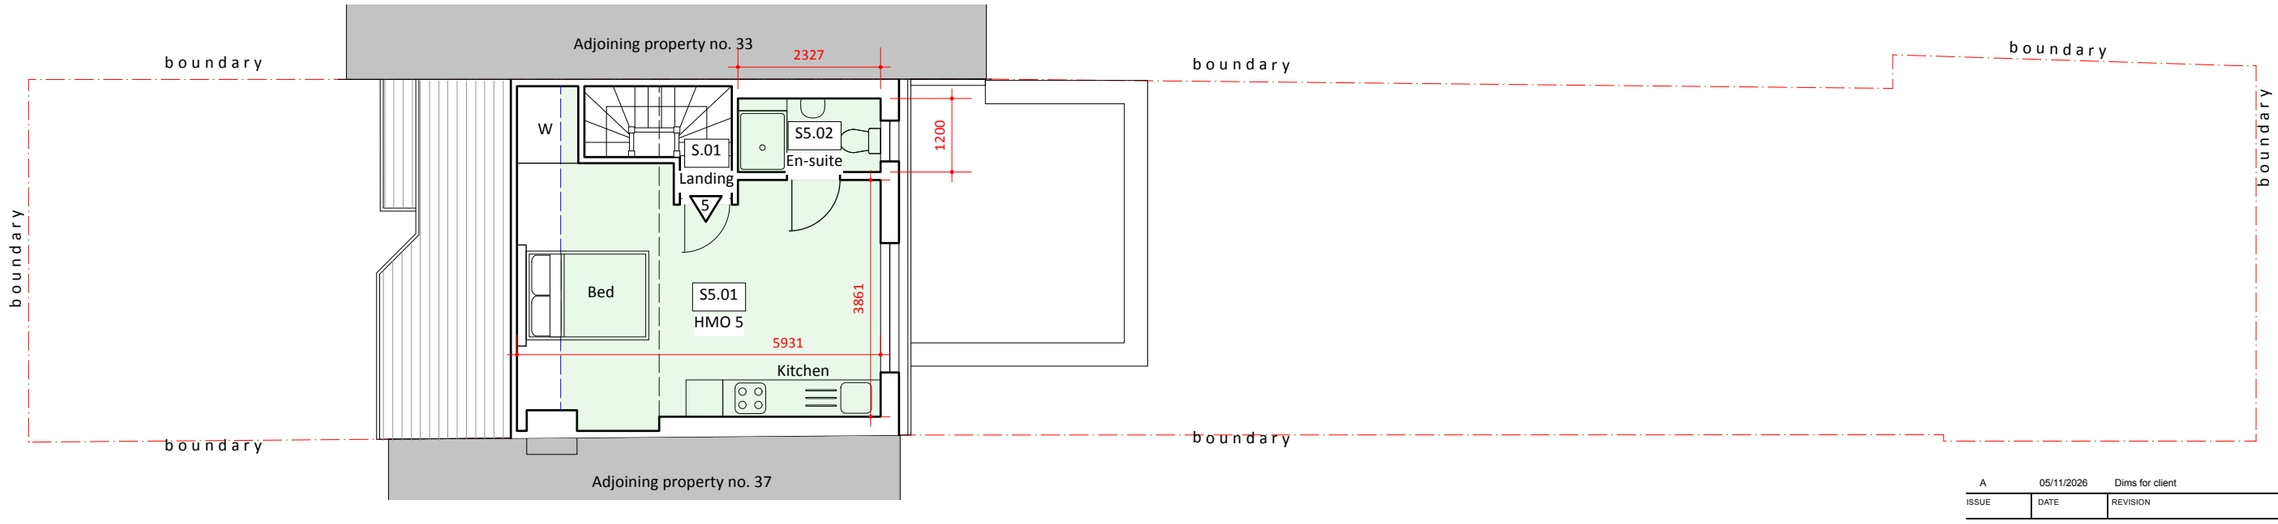


| ISSUE | DATE | REVISION |
|---|---|---|
| A | 05/11/2026 | Dims for client |

PROJECT
**35 Richmond Avenue Uxbridge UB10 9BQ**

CLIENT
**Mr Aaron Neil**

DRAWING
**PROPOSED SECOND**

STONES ARCHITECTS

All rights described in chapter IV of the copyright designs & patents act 1988 have been asserted. This drawing must not be scaled; only figured dimensions should be used. Check and verify all dimensions on site prior to commencing any work. Any discrepancies should be reported to the Architects immediately.

| PROJECT # | DWG # | REV |
|---|---|---|
| 2025.050 | D12-A | |
| DATE 05/11/2026 | | |
| SCALE 1:100 | | |
| DRAWN PR | CHKD JC | |

0 1 2 3 4 5 m

N

**Stones Architects Ltd**
50 Coldharbour Lane Hayes Middlesex UB3 3EP
**t** 020 8969 0000 **e** mail@stonesarchitects.co.uk **w** stonesarchitects.co.uk