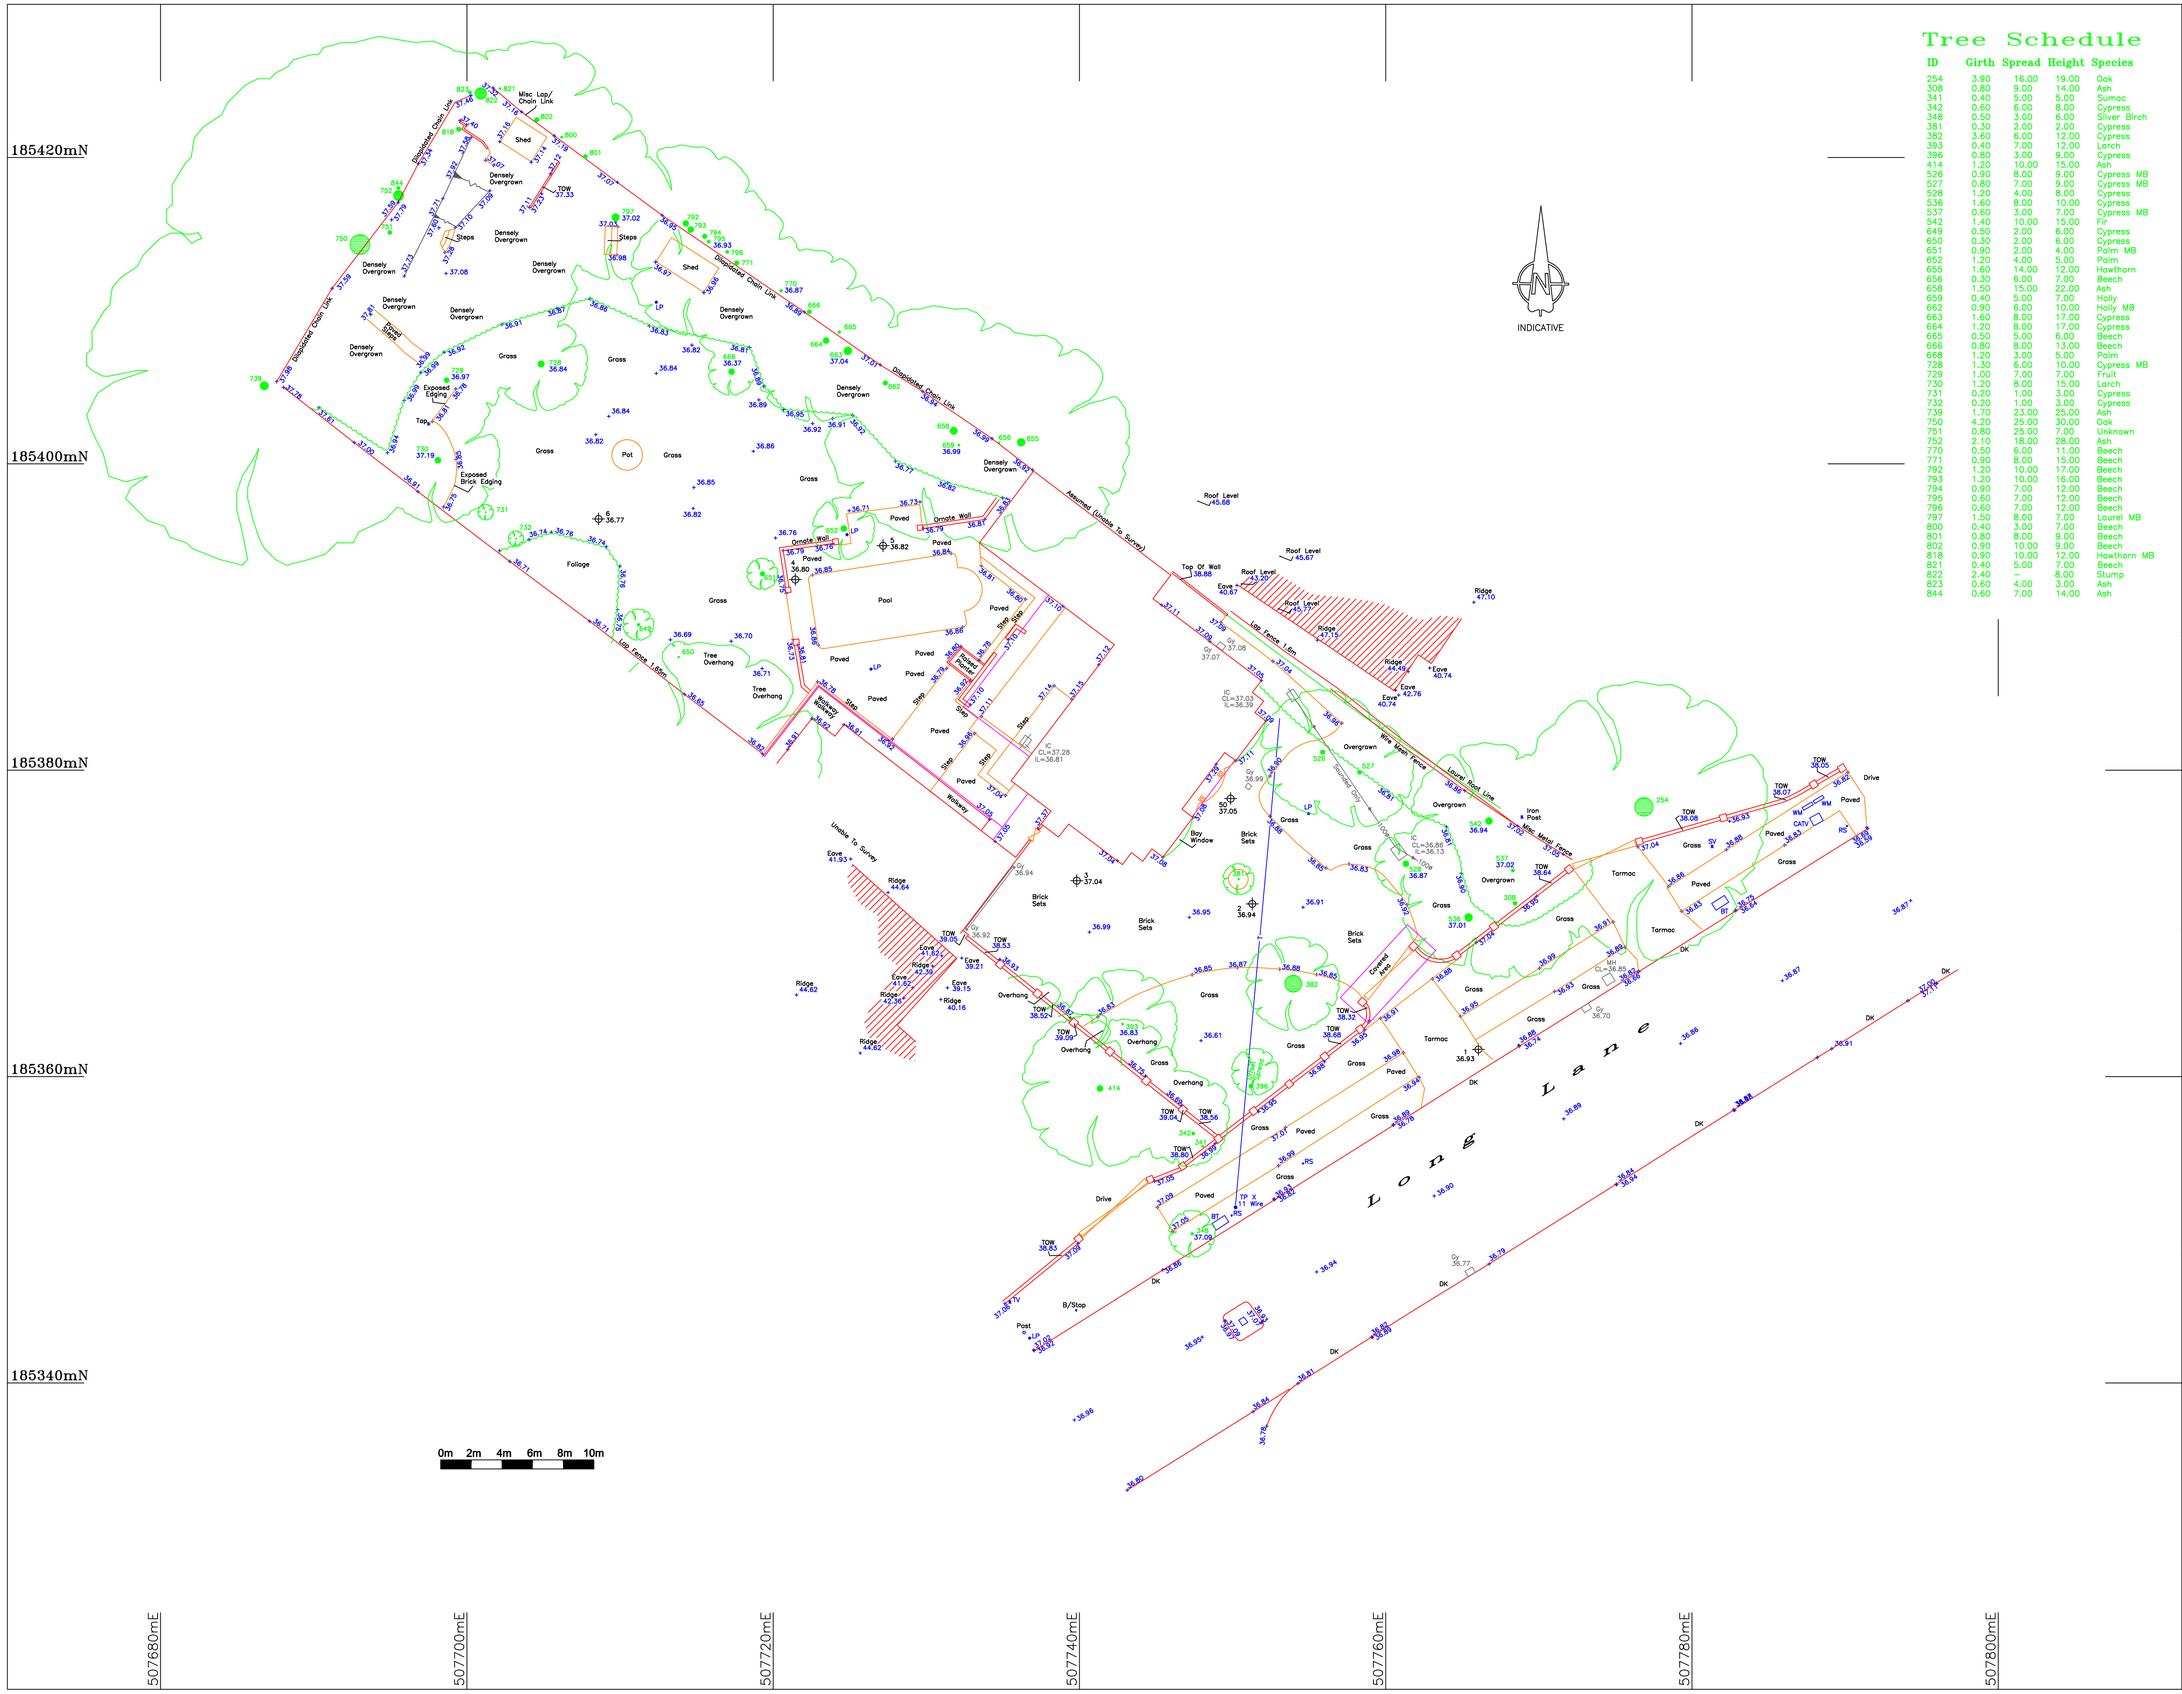

Tree Schedule

ID	Girth	Spread	Height	Species
254	3.90	16.00	19.00	Oak
308	0.80	9.00	14.00	Ash
341	0.40	5.00	5.00	Sumac
342	0.60	6.00	8.00	Cypress
348	0.50	3.00	6.00	Silver Birch
381	0.30	2.00	2.00	Cypress
382	3.60	6.00	12.00	Cypress
393	0.40	7.00	12.00	Larch
396	0.80	3.00	9.00	Cypress
414	1.20	10.00	15.00	Ash
526	0.90	8.00	9.00	Cypress MB
527	0.80	7.00	9.00	Cypress MB
528	1.20	4.00	8.00	Cypress
536	1.60	8.00	10.00	Cypress
537	0.60	3.00	7.00	Cypress MB
542	1.40	10.00	15.00	Fir
649	0.50	2.00	6.00	Cypress
650	0.30	2.00	6.00	Cypress
651	0.90	2.00	4.00	Palm MB
652	1.20	4.00	5.00	Palm
655	1.60	14.00	12.00	Hawthorn
656	0.30	6.00	7.00	Beech
658	1.50	15.00	22.00	Ash
659	0.40	5.00	7.00	Holly
662	0.90	6.00	10.00	Holly MB
663	1.60	8.00	17.00	Cypress
664	1.20	8.00	17.00	Cypress
665	0.50	5.00	6.00	Beech
666	0.80	8.00	13.00	Beech
668	1.20	3.00	5.00	Palm
728	1.30	6.00	10.00	Cypress MB
729	1.00	7.00	7.00	Fruit
730	1.20	8.00	15.00	Larch
731	0.20	1.00	3.00	Cypress
732	0.20	1.00	3.00	Cypress
739	1.70	23.00	25.00	Ash
750	4.20	25.00	30.00	Oak
751	0.80	25.00	7.00	Unknown
752	2.10	18.00	28.00	Ash
770	0.50	6.00	11.00	Beech
771	0.90	8.00	15.00	Beech
792	1.20	10.00	17.00	Beech
793	1.20	10.00	16.00	Beech
794	0.90	7.00	12.00	Beech
795	0.60	7.00	12.00	Beech
796	0.60	7.00	12.00	Beech
797	1.50	8.00	7.00	Laurel MB
800	0.40	3.00	7.00	Beech
801	0.80	8.00	9.00	Beech
802	0.90	10.00	9.00	Beech
818	0.90	10.00	12.00	Hawthorn MB
821	0.40	5.00	7.00	Beech
822	2.40	–	8.00	Stump
823	0.60	4.00	3.00	Ash
844	0.60	7.00	14.00	Ash

NOTES:

Whilst every effort has been made to correctly identify species of trees on the site, we advise that an arboriologist be consulted before any final decisions are made.

Grid coordinates are based on Ordnance Survey National Grid.

ABBREVIATION KEY – TOPOGRAPHIC SURVEY

AV	Air Valve
BO	Bollard
BIG	Back Inlet Gully
BT	British Telecom
CPS	Concrete Paving Slabs
CL=	Cover Level
CATV	Cable Television Cover
DY	Double Yellow Line
DR	Double Red Line
DW	Dashed White Line
ECB	Electric Cable Cabinet
ECP	Electric Cable Pit
EP	Electricity Pole
ER	Earth Rod
FAI	Fresh Air Inlet
FH	Fire Hydrant
F/B	Flower Bed
GV	Gas Valve
Gy	Gully
IL=	Invert Level
LC	Lamp Column
LP	Lamp Post
MB	Multi Bole
MK	Service Marker
PM	Parking Meter
RE	Rodding Eye
RS	Road Sign
RWP	Rain Water Pipe
SC	Stop Cock
SW	Single White Line
SY	Single Yellow Line
SV	Stop Valve
SVP	Soil and Vent Pipe
TCB	Telephone Cable Cabinet
TOW	Top Of Wall
TP	Telephone Pole
UTL	Unable To Lift
WG	Weir Gully
WM	Water Meter
WO	Wash Out

ABBREVIATION KEY – BUILDING SURVEY

○	Floor To Ceiling
□	Floor To False Ceiling
AB	Air Brick
DS	Double Socket
Dh	Door Head Level
Ceil HT	Ceiling Level
FA	Fire Alarm
FL	Floor Level
FS–	Floor To Sill
FS	Fuse Box
GL	Ground Line
Ht=	Height
LS	Light Switch
RWP	Rain Water Pipe
SA	Smoke Alarm
SD	Smoke Detector
SH–	Sill To Head
SS	Single Socket
Stat	Thermostat
SW	Switch
Tel	Telephone/Outlet
TV	Arial/Cable Socket
UA=	Under Arch (centre)
UO=	Under Opening
UB=	Under Beam
UD=	Under Duct
UP=	Under Pipe
WL	Wall Light
Wh=	Window Head Level
Ws=	Window Sill Level

Co-ordinate Table

ID	Easting	Northing	Height
1	507766.055	185361.770	36.933
2	507751.286	185371.276	36.945
3	507739.828	185372.793	37.038
4	507721.447	185392.452	36.803
5	507727.177	185394.660	36.823
6	507708.601	185396.406	36.769
50	507749.871	185378.146	37.053
51	507735.639	185385.626	37.095

REV. SUFFIX	DATE	INITIAL	REVISION DETAILS

LEVELLING: Related To Ordnance Survey Utilising GPS

DATUM: Related To Ordnance Survey Utilising GPS

CAD OPERATOR	CDH	APPROVED BY	BED	DATE	30.05.2023

Survey and Engineering Services Ltd

Land, Architectural and Engineering Surveyors

CLIENT: Towers Associates

LOCATION: *90 Long Lane Ickenham UB10 8SX*

DRAWING TITLE: *Detail Survey*

ORIGINAL JOB No.	JOB No. *150523*
DRAWING No. *150523/Topo*	REVISION SUFFIX
SCALE *1:200*	DATE *30th May 2023*

The Granary
Lee Farm
Lee Lane
Pinkneys Green
Maidenhead
SL6 6PE

Registered Company No: 5566478

Tel No / Fax: +44 (0) 1628 675 781
e-mail: mail@ses-surveyors.co.uk